


REFERENCE SCHEMATIC DRAWINGS		
RFB NO	DWG NO	TITLE
F	E-430	SOLID RADWASTE COLLECTION & PROCESSING CONCENTRATE STORAGE DISCHARGE PUMP/VALVES - COMMON
G	E-430	SOLID RADWASTE COLLECTION & PROCESSING CONCENTRATE STORAGE DISCHARGE PUMP & VALVES - COMMON
L		
M	E-398	EXTERNAL RADWASTE PROCESSING STATION VS-VES - COMMON

[illegible]

PDR RIDS

8405310075

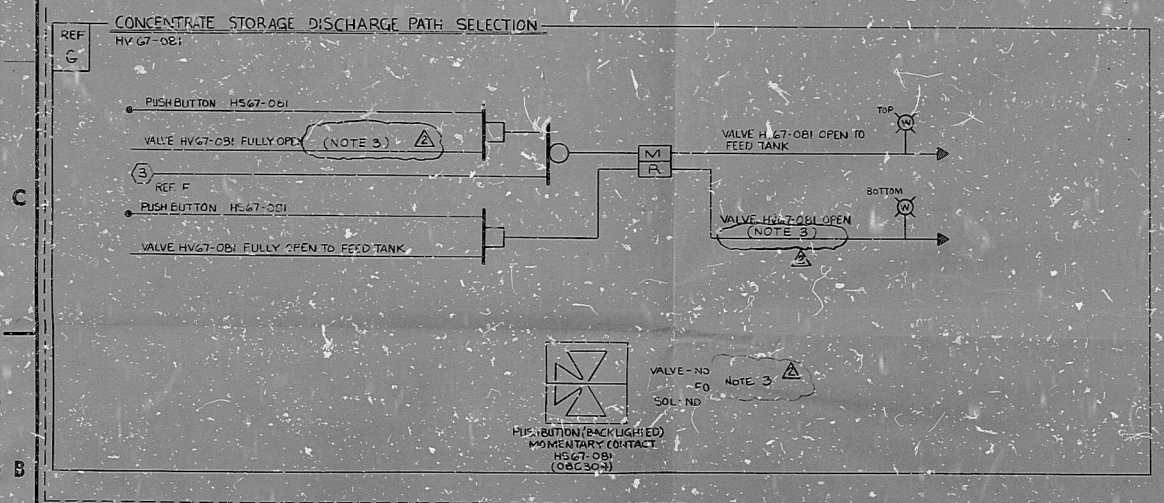