


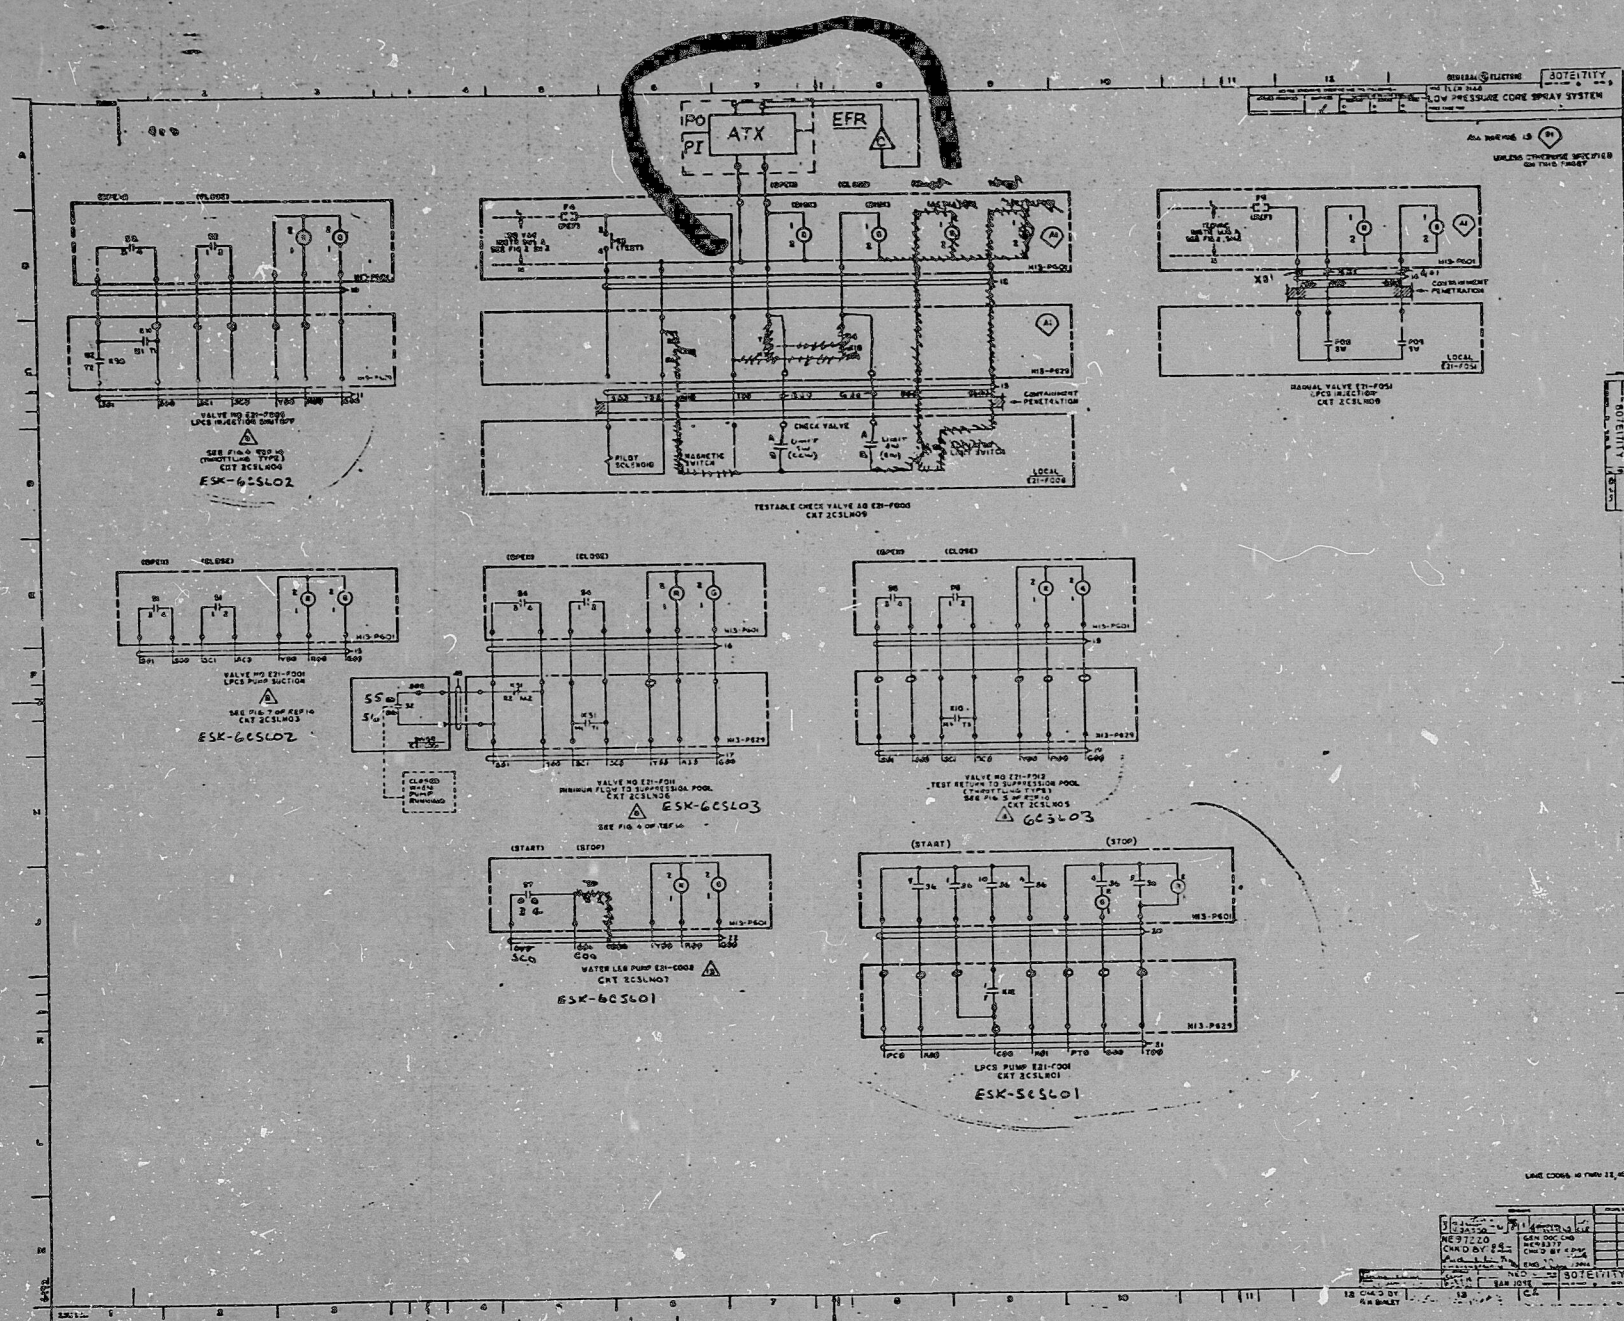

PRC
APERTURE
CARD

STONE & WEBSTER ENGINEERING CORPORATION
NINE MILE POINT NUCLEAR STATION - UNIT 2
NIAGARA MOHAWK POWER CORPORATION
J.O. 12177

INSTRUCTIONS TO SUPPLIER (E2)
✓ Comments As Noted
APPROVED AS REVISED
RELEASED FOR FABRICATION
RELEASED FOR MATERIAL PURCHASE

SUPPLIER TO RESUBMIT

NOTES:

DESIGN ENGINEER'S DATE STAMP (D)
INITIALS OF SELECTED REVIEWERS
RESPONSIBLE ENGINEER'S DATE STAMP (E2)
NOTED NOV 17 1981 J.D. CAREY

SUPERSEDES S&W FILE NO. (E2) (35-38)
REMARKS (C) (LIMIT TO 22 CHARACTERS & BLANKS) (33-74)

S&W EQUIP. I.D. CODE (E1)
AREA DESIGNATION CODES (E1) (78-80)

FUNCTIONAL TITLE (E1)
LOW PRESS CORE SPRAY

S&W FILE NO. (E2)
JOB ORDER NO. 12177 100

ATTACH TO M

RIDS

8305030232

