


(80-1

ADMINISTRATION BUILDING - EXHAUST FANS 00V503, 00V509

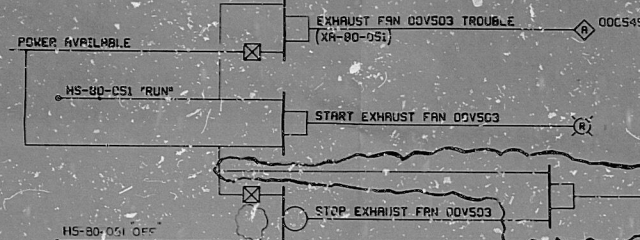

FAN	HS-	XA-	PANEL	POWER SUPPLY VOLTAGE - HZ - PHASE
00V503	90-051		00C545	460 - 60 - 3
00V509	90-003			




 00C545
 HS-80-051
 MAINT. CONTACT

RE

NO-2

ADMIN BLOC TELEPHONE EQUIPMENT ROOM AIR EXHAUST FAN 00Y504

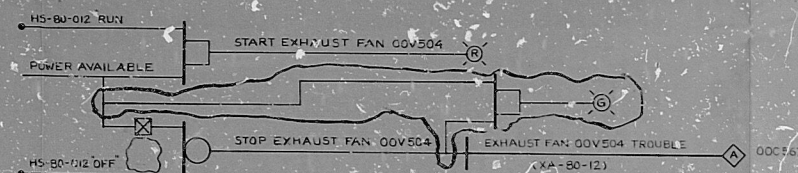

OFF RUN

00CS67
HS-80-012
MAINT. CONTR


NOTES

1. THIS FUNCTIONAL DESCRIPTION DRAWING IS
BASED ON P & ID M-80, SHT. 1 REV. 9 SHT. 2
REV. 14.

REF

189- 27

ADMINISTRATION BUILDING - EXHAUST FAN QOV703

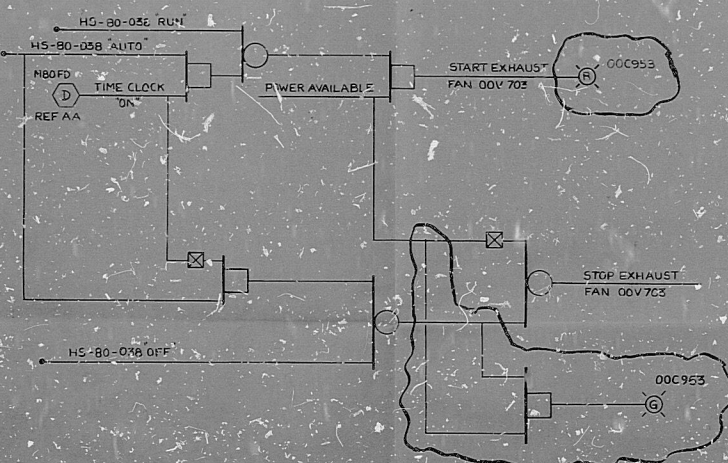


OFF RUN

00C95Z
H5-80-058
MAINT CONTACT

REI

(90-4)

ADMINISTRATION BUILDING - ROOF EXHAUST FANS OAV511 THRU OGV511, OAV547 THRU OJY547, OAV548 THRU OCV548 & OGV502

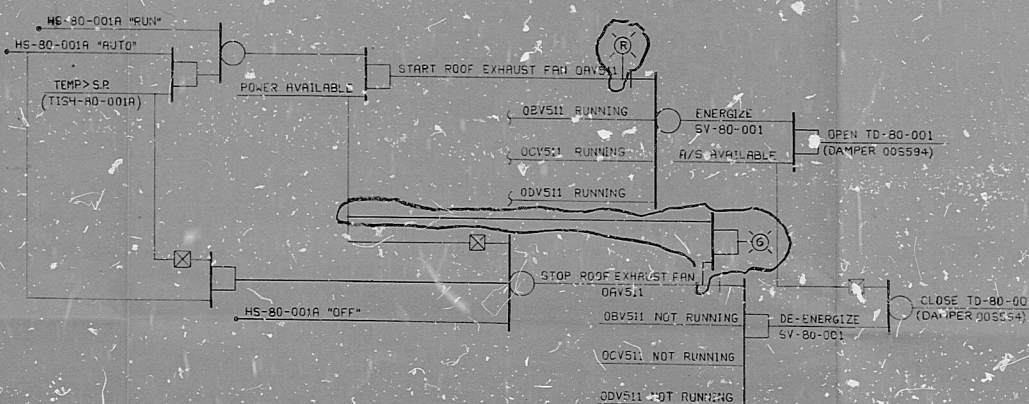

FBN	H5-	TISH-	SV-80-	TO-80-	DAMPER	ROOM	KNEEL H-3 SV LOCATION
JRV511	80-001R						
DCV511	80-001B		001	001	005S94	10B	
DCV511	80-001L						
JCV547	80-002R			--	--		DOC567
DCV547	80-002B		002E	FOZP-U	0R-6-3-93	10C	
DCV547	80-003C		003	003R-C	0B-47567		
DCV547	80-004R-C		004	004	005S95		
JRV708	80-007					340	001-350

TI
APERT
CARN

REFERENCE SCHEMATIC DRAWINGS		
REF. NO.	DWG NO.	TITLE
A	E526-1	ADMINISTRATION BLDG EXHAUST FANS - COMMON
B	E526-2	ADMINISTRATION BLDG EXHAUST FANS - COMMON
C	E526-3	ADMINISTRATION BLDG EXHAUST FANS - COMMON
D	E527-1-3	ADMINISTRATION BLDG SPLY EXHAUST

[illegible]

BECHTEL
SAN FRANCISCO

LIMERICK GENERATING STATION UNITS 1 & 2
PHILADELPHIA ELECTRIC COMPANY

FUNCTIONAL DESCRIPTION
ADMINISTRATION COMPLEX,
OFFICES & SHOPS - HVAC

	JOB No.	DRAWING No.	
	2031	M-80FD	SHT 1 OF 11

REF. A,B,C,D

PDR RIDS

8405310227

