


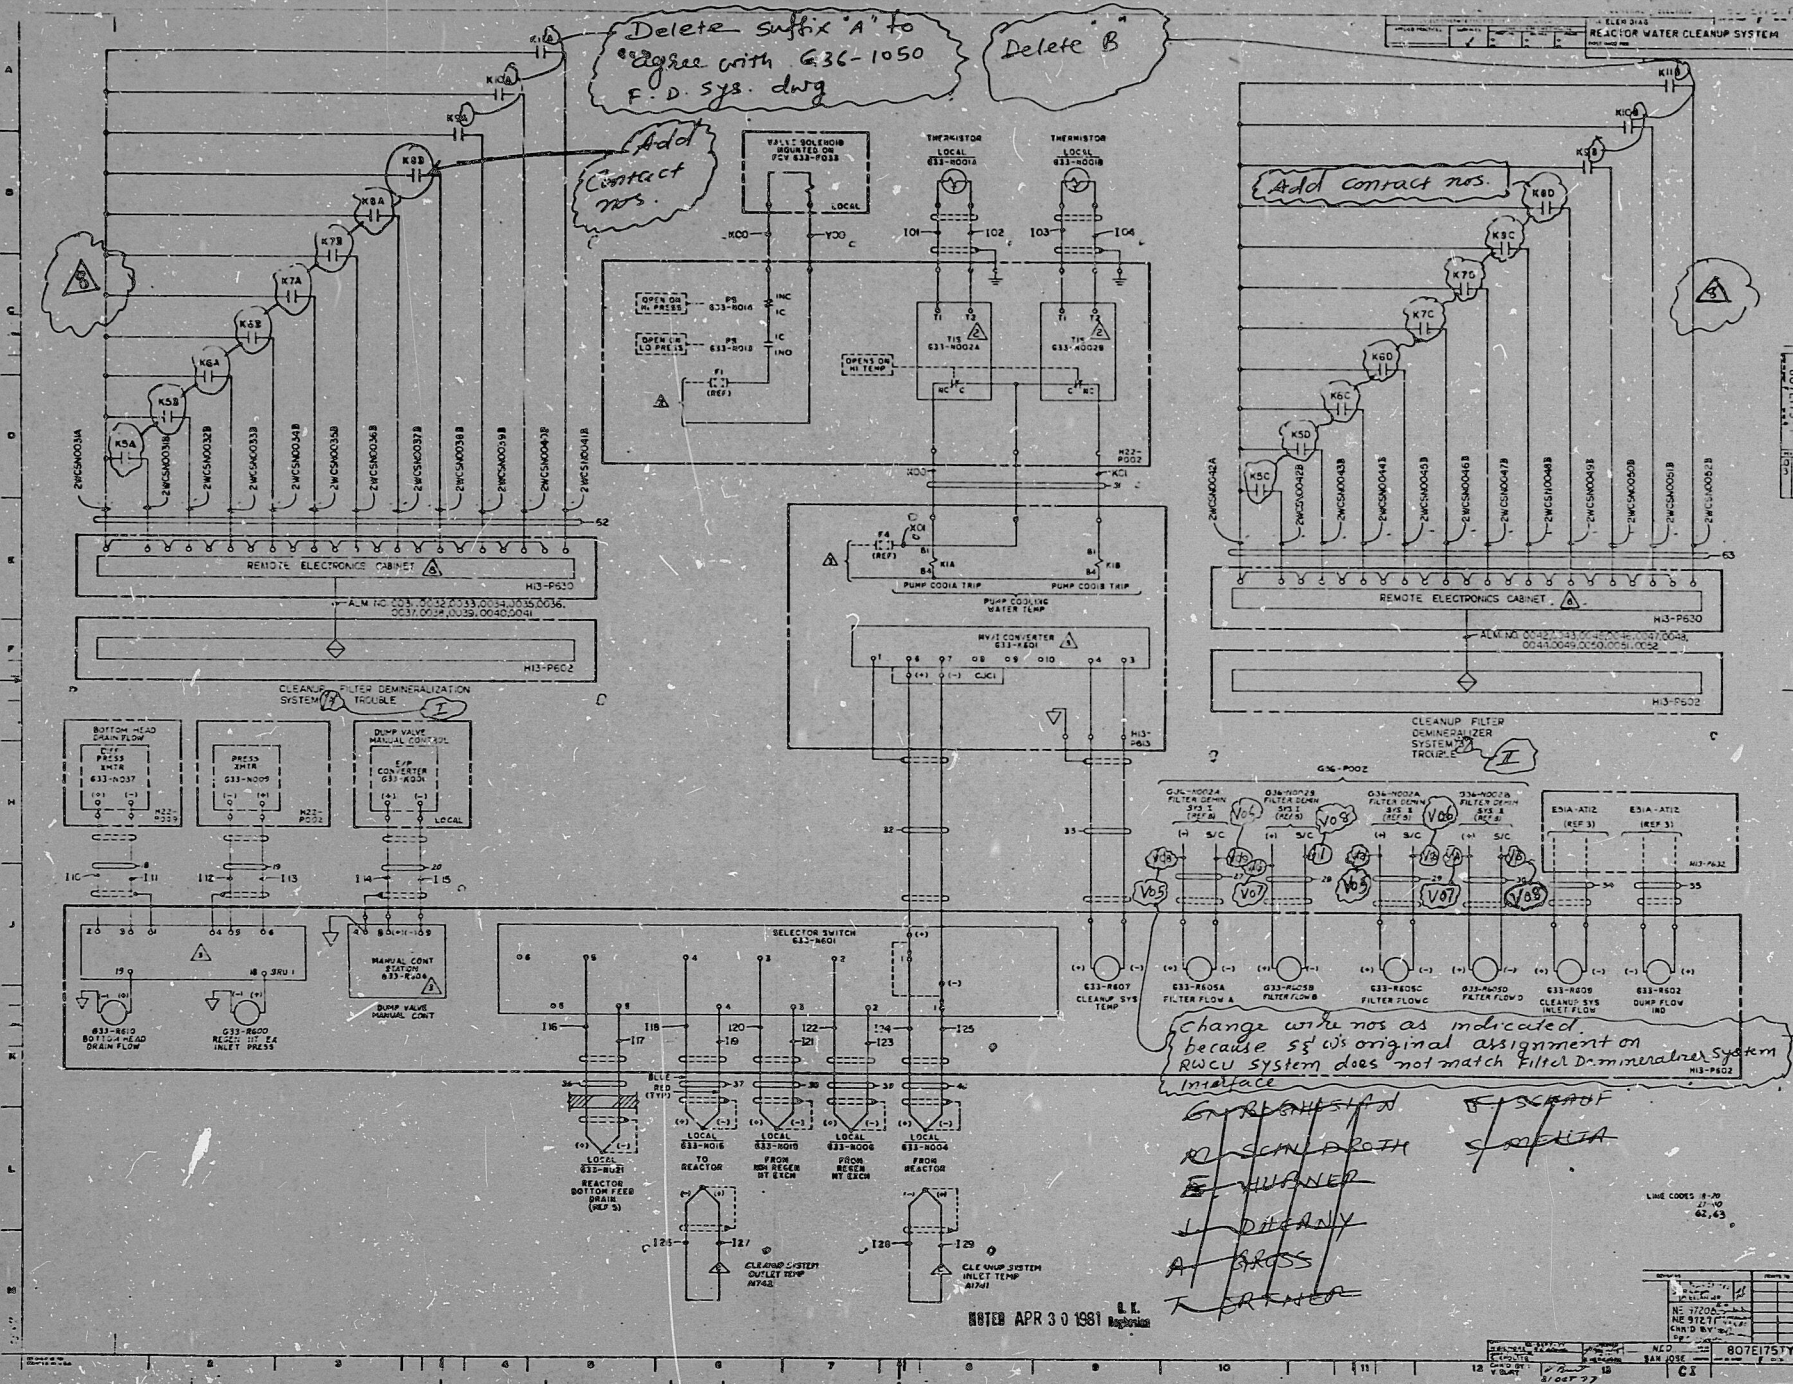

PRC
APERTURE
CARD

STONE & WEBSTER ENGINEERING CORPORATION NINE MILE POINT NUCLEAR STATION - UNIT 2 NIAGARA MOHAWK POWER CORPORATION I.D. 12177		MANUFACTURER'S DRAWING DATA FORM	
INSTRUCTIONS TO SUPPLIER (E2) COMMENTS AS NOTED APPROVED AS REVISED SPECIFICATION RELEASED FOR FABRICATION RELEASED FOR MATERIAL PURCHASE		RESP. ENG. S.M. HTA (E1) RESP. DES. ENG. B. RUSSELL (E1) INSTRUCTIONS TO DESIGN (E1) INFORMATION ONLY PRELIMINARY LAYOUT PRODUCTION STUDIES REVIEW AND COMMENT FINAL DETAILS NEW NEW REV REVISED	
SUPPLIER TO RESUBMIT FOR REVIEW FOR RECORD NONE REQUIRED		DATE TO DESIGN 11/14/80 (E1) REQUIRED RETURN DATE 12/15/80 DESIGN ENGINEER'S DATE STAMP (D) NOTED NOV 24 1980 DESIGN GROUP ROUTING (D) ROUTE ARCHITECTURE CIVIL CONCRETE BUILDING SERVICE INSTRUMENT MECHANICAL PIPE SUPPORT STRESS MACHINE DESIGN/VESSEL LIGHTING MODEL SHOP EXTENSION OFFICE CONTROL	
INITIALS OF SELECTED REVIEWERS RESPONSIBLE ENGINEER'S DATE STAMP (E2) SUPERSEDES S.G.W. FILE NO. (E1775-34) (158-501) 00001754001023A 1764001023A S.G.W. EQUIP. ID. CODE (E1) AREA DESIGNATION CODES (E1775-34) MFR'S. DWG. NO. (LIMIT TO 34 CHARACTERS & BLANKS) (E1775-34) MFR'S. NAME (LIMIT TO 30 CHARACTERS & BLANKS) (E1775-34) GENERAL ELECTRICAL DATE MONTH DAY YEAR 11 20 80 FUNCTIONAL TITLE (E1) REACTOR WATER CLEANUP SYSTEM S.G.W. FILE NO. (E1) 1764001023A PUR. ORDER NO. 12177 00		(E1) PROJECT CLERK (E2) RESP. DESIGN ENGINEER (E3) RESP. ENGINEER - ON DWS RECEIPT (E4) RESP. ENGINEER - AFTER DWS REVIEW (E5) MICROFILM APERTURE CARD (E6) REV. REVIEWER INITIALS	

RIDS

805040082

