


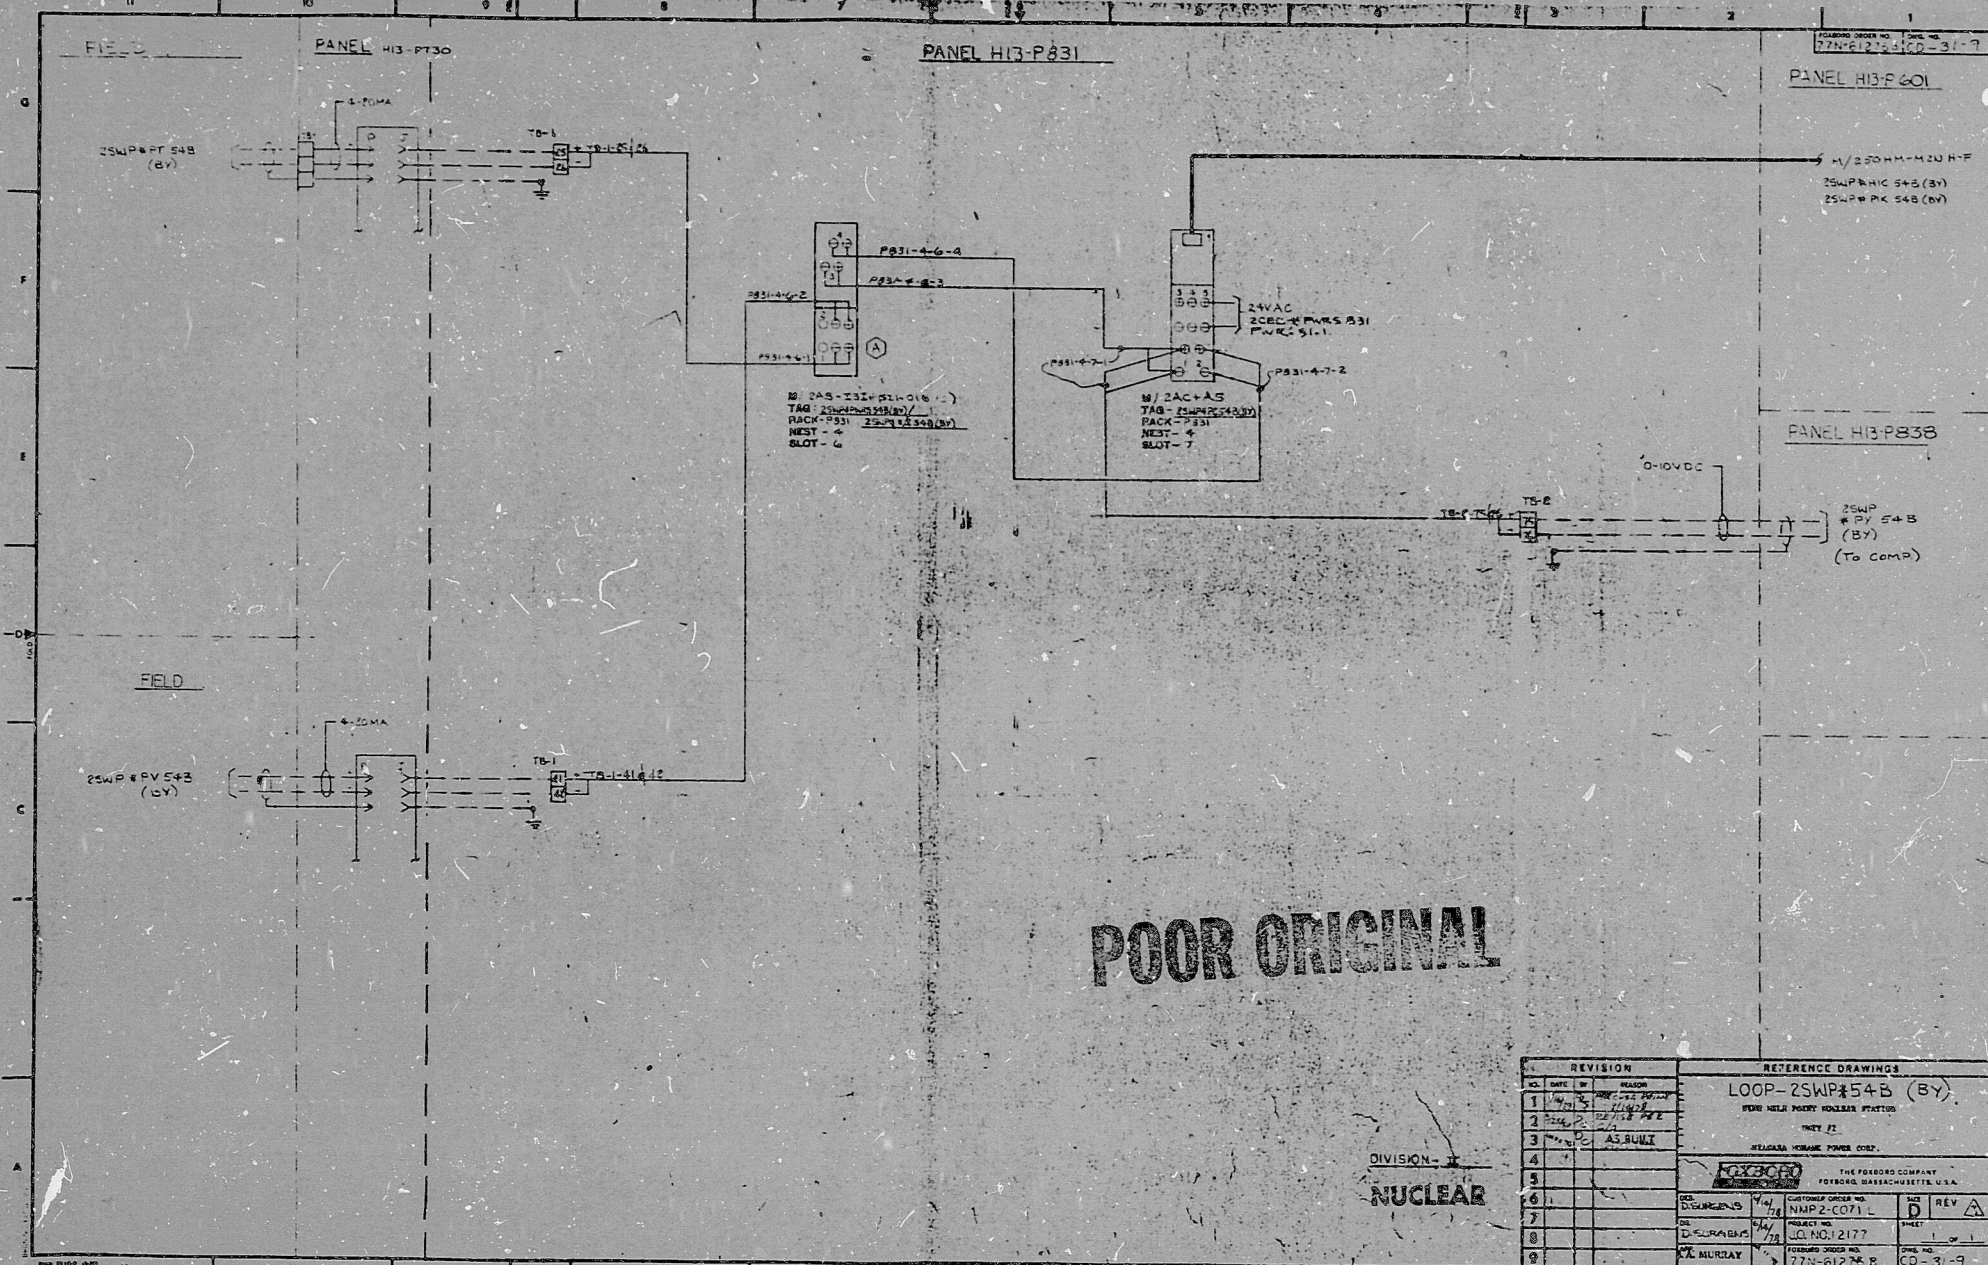

POOR ORIGINAL

DIVISION - 1
NUCLEAR

REVISION		REFERENCE DRAWINGS	
NO.	DATE	NO.	DATE

PRC
APERTURE
CARD


RIDS

8305040151

7

