


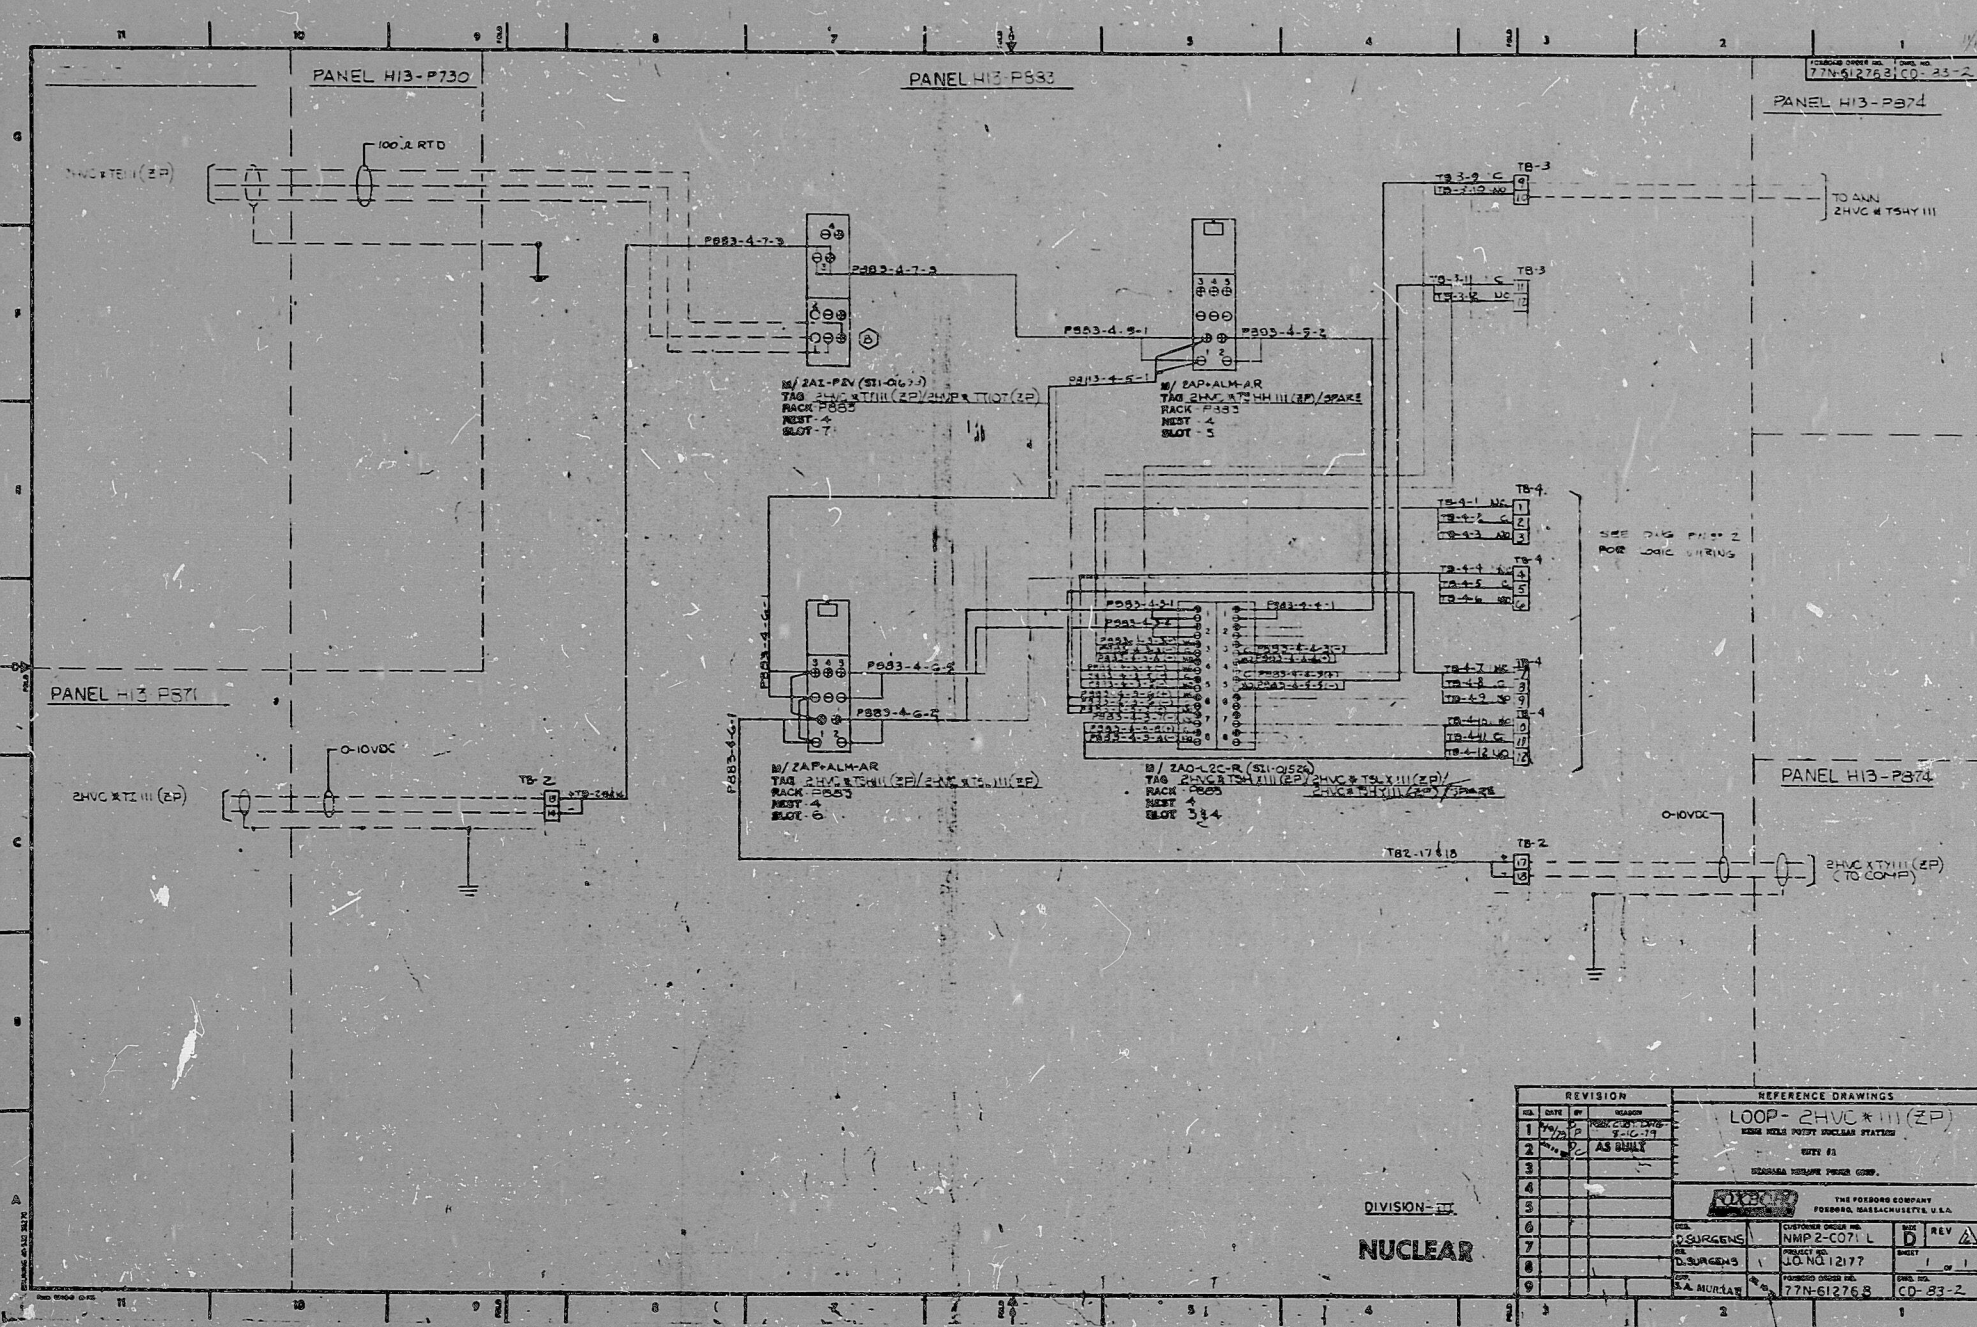

PRC
APERTURE
CARD

REVISION		REFERENCE DRAWINGS	
1	AS BUILT	LOOP-2HVC*III(ZP)	

MANUFACTURER'S DRAWING DATA FORM	
DATE OF DESIGN	3-12-81
DATE OF RETURN	
DESIGN ENGINEER'S DATE	
DESIGN GROUP ROUTING	
ROUTE	
DATE	
TIME	
0007.139.40.16.6	
0007.139.40.16.6	
031081	
Loop 2HVC*III ZP	
0007.139.40.16.6	
12177.00	

DIVISION-III
NUCLEAR

RIDS

8305040315

