


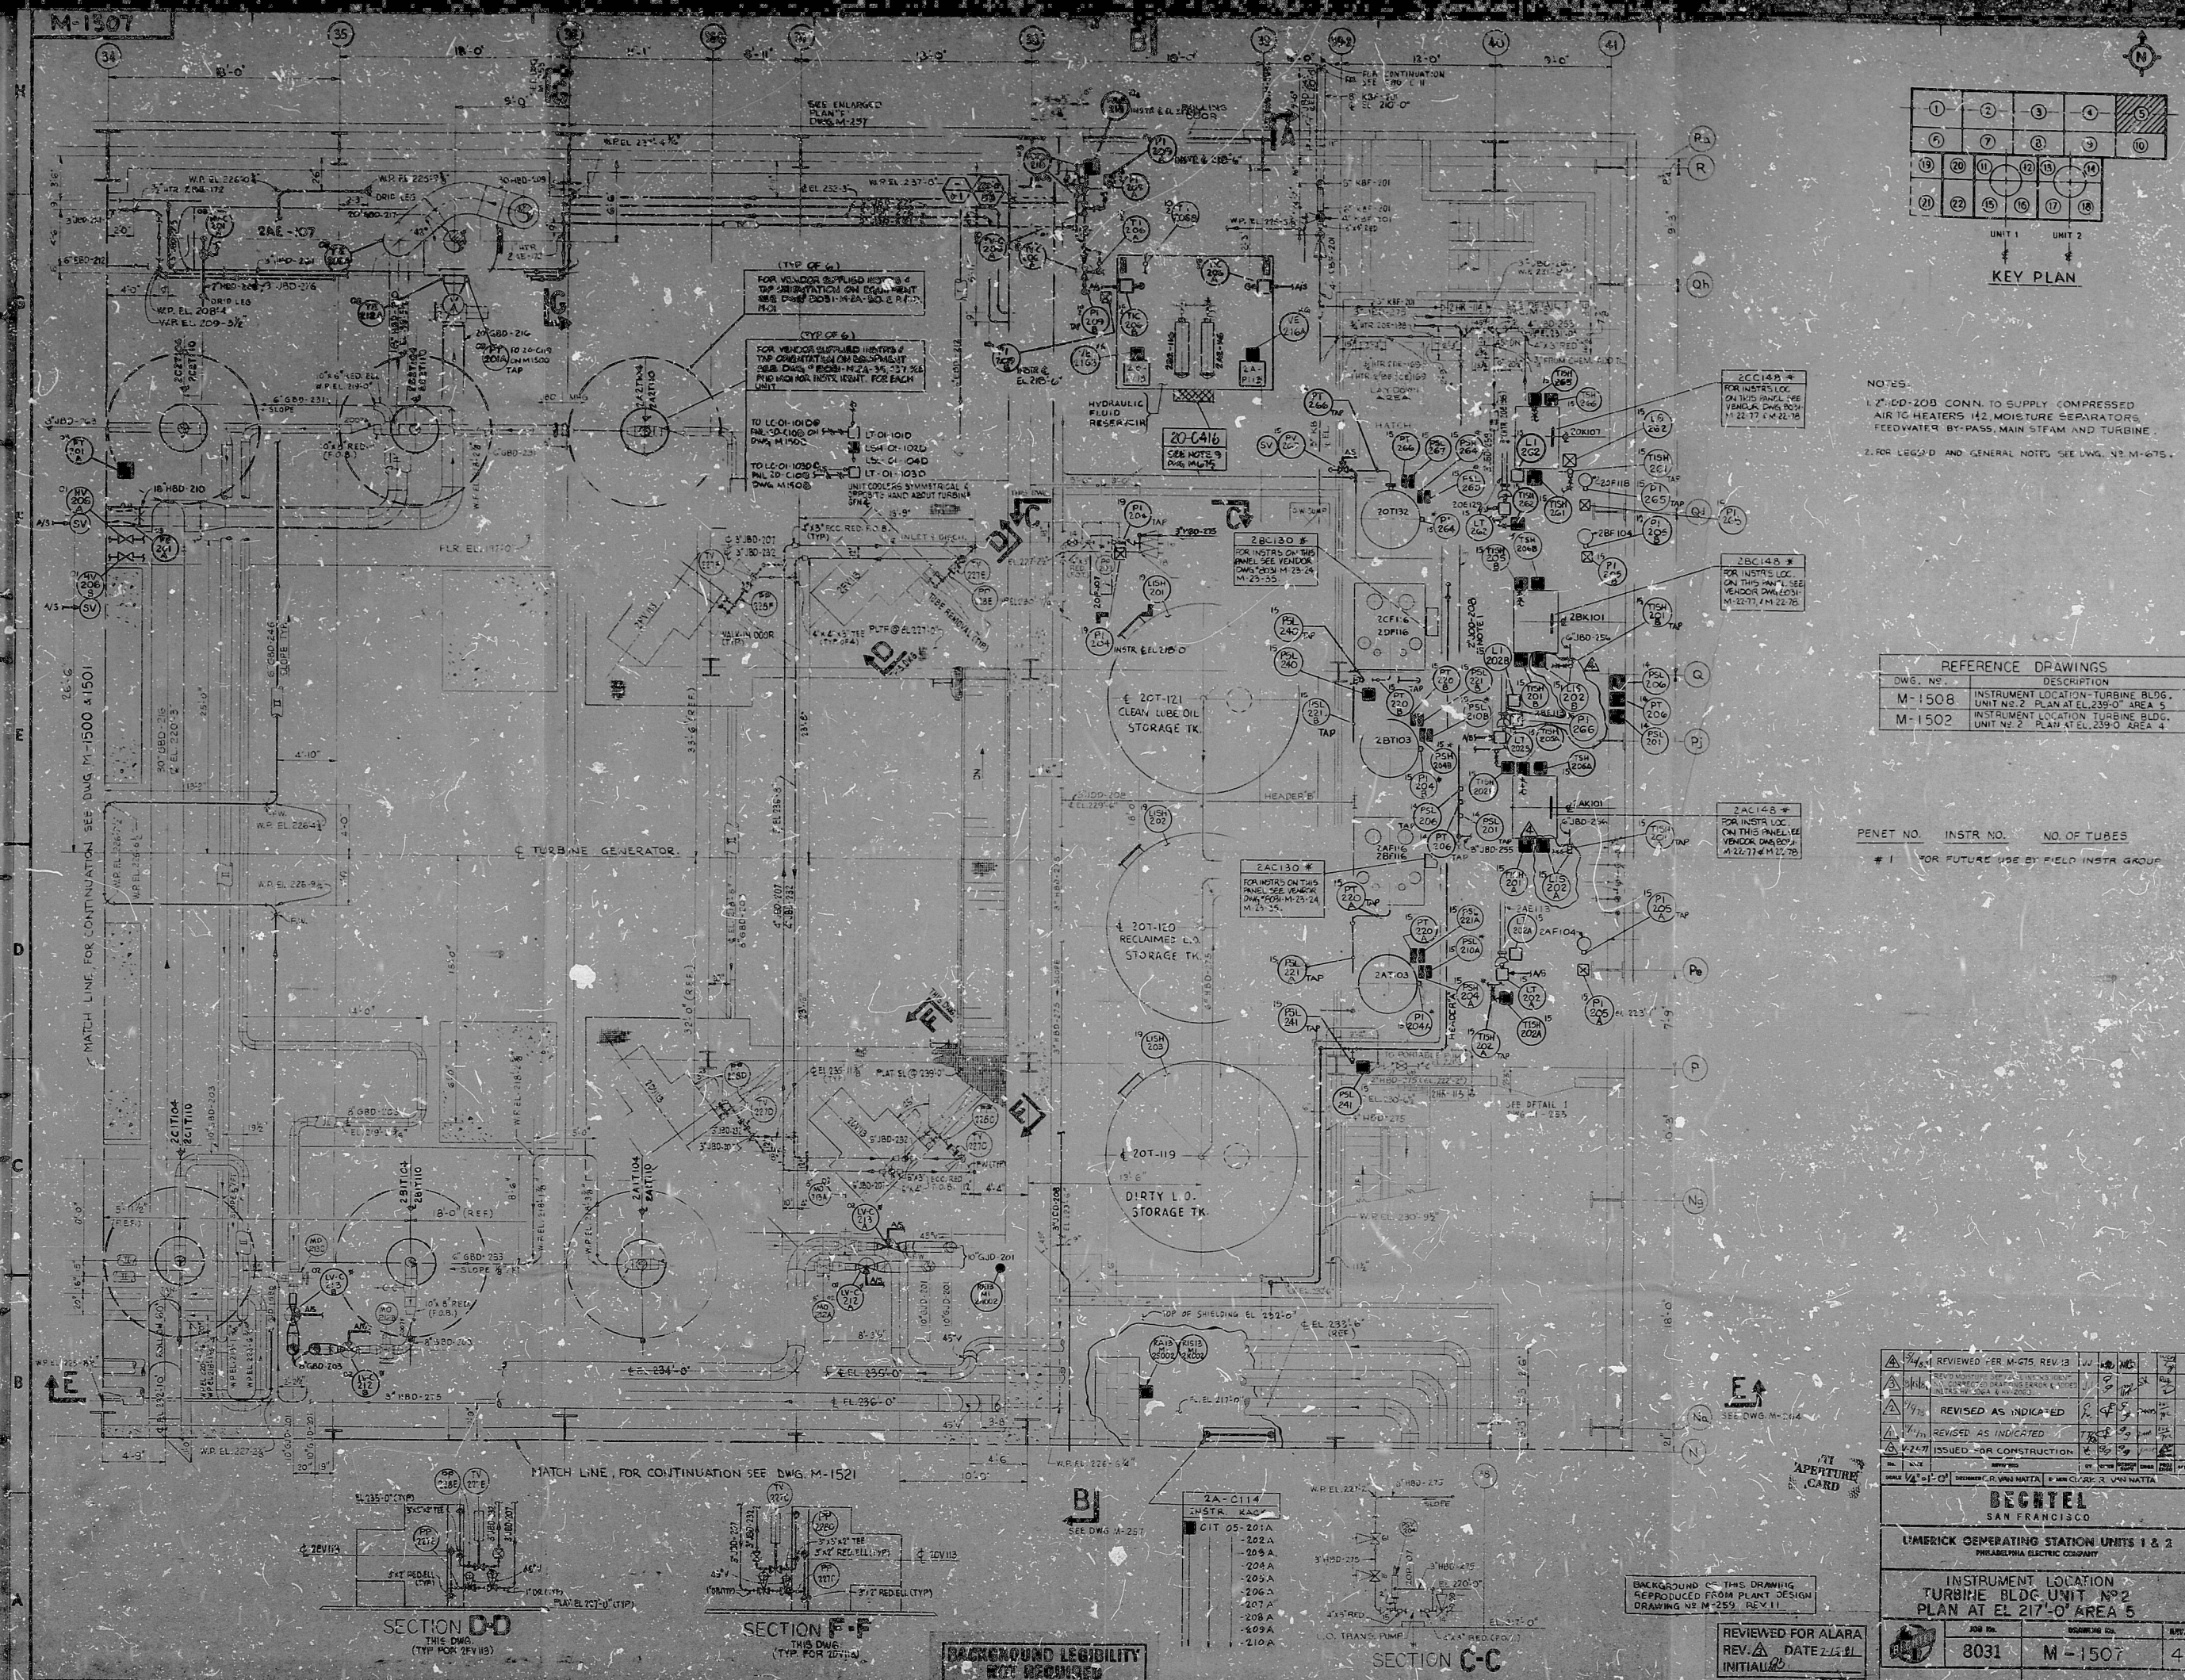

REFERENCE DRAWINGS	
DWG. NO.	DESCRIPTION
M-1508	INSTRUMENT LOCATION-TURBINE BLDG. UNIT NO.2 PLAN AT EL.239'-0" AREA 5
M-1502	INSTRUMENT LOCATION-TURBINE BLDG. UNIT NO.2 PLAN AT EL.239'-0" AREA 4

PENET NO. INSTR NO. NO. OF TUBES

1 FOR FUTURE USE BY FIELD INSTR GROUP

[illegible]

PDR RIDS

8405310510

