


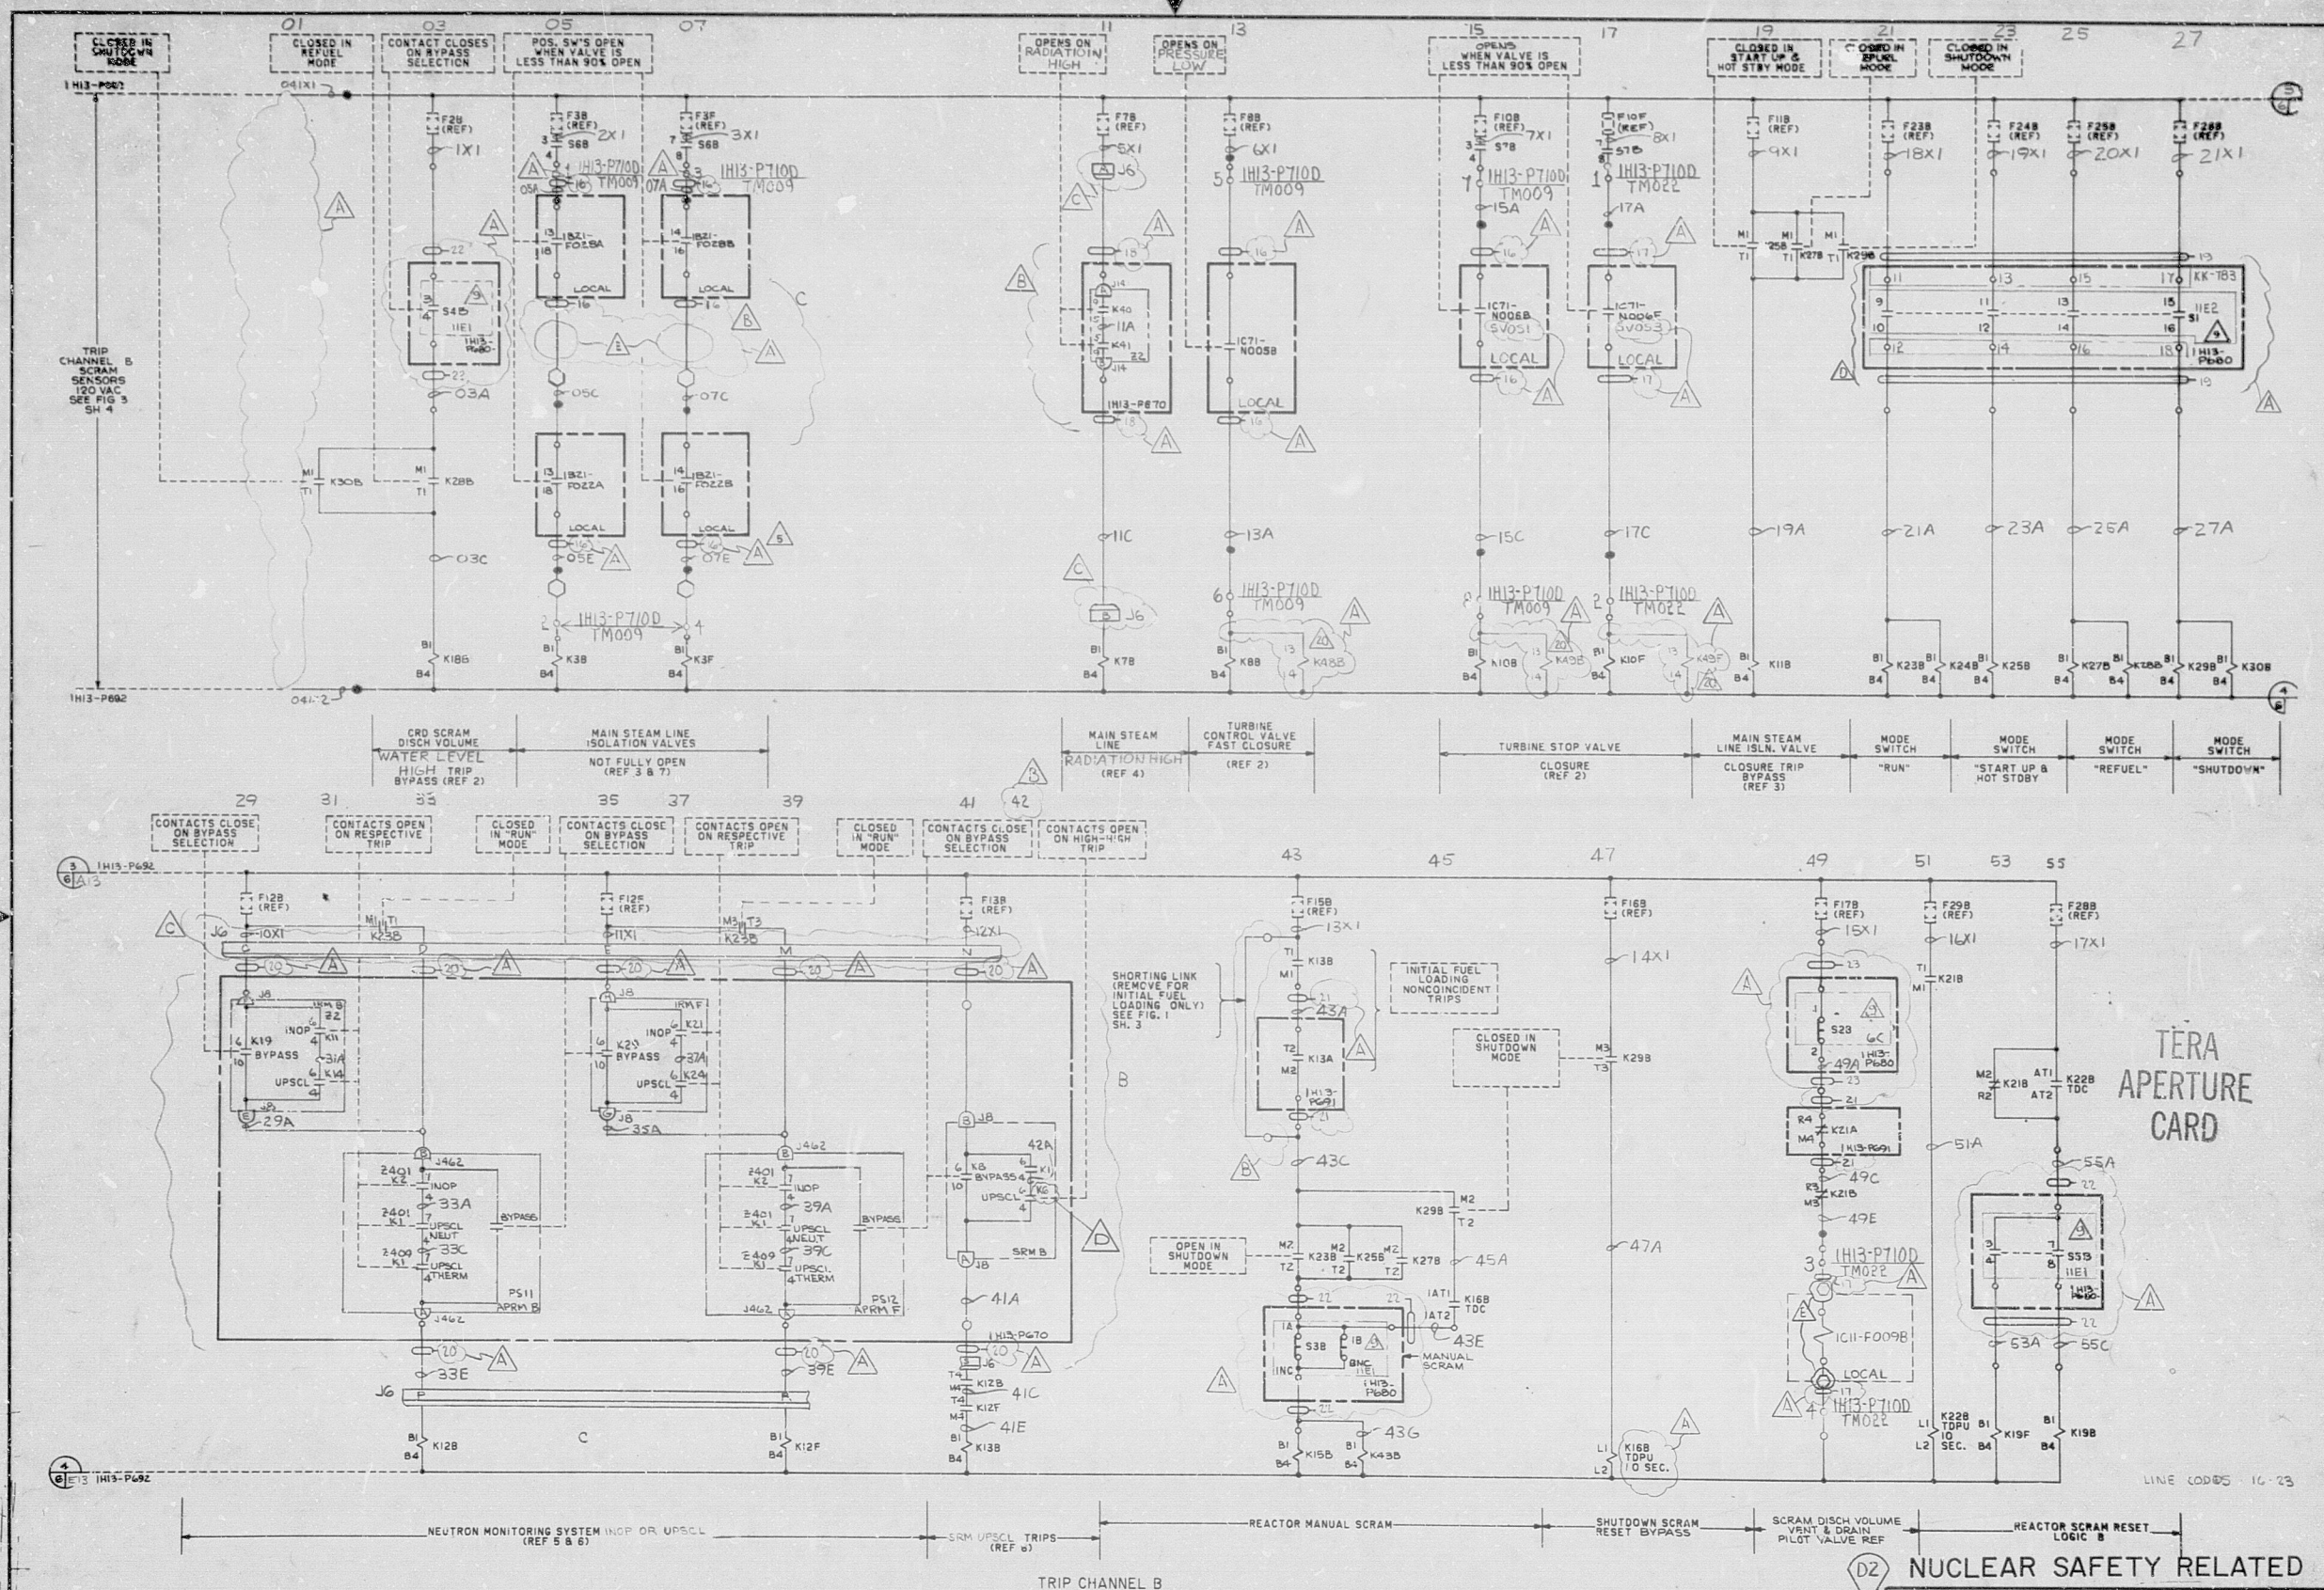

REMOVED LIMIT SW ADDED PENETRATION				REVISED AS PER GE DWG. REV. 5				ADDED 3RD MSIV LIMIT SW FOR LOGIC TO K3B & K3F				ADDED FITS INFORMATION AND PLUGS PER GE REV. 3				REVISED PER GE REV. C			
E	Y	Z	R	M	D	E	G	R	A	M	C	R	A	M	B	R	A	M	A
REV	MADE	CHKD	APPROVALS	DATE	REV	MADE	CHKD	APPROVALS	DATE	REV	MADE	CHKD	APPROVALS	DATE	REV	MADE	CHKD	APPROVALS	DATE
4-11-81					6/16/80					1-4-80					5-8-78				

R1DS

812030146

