


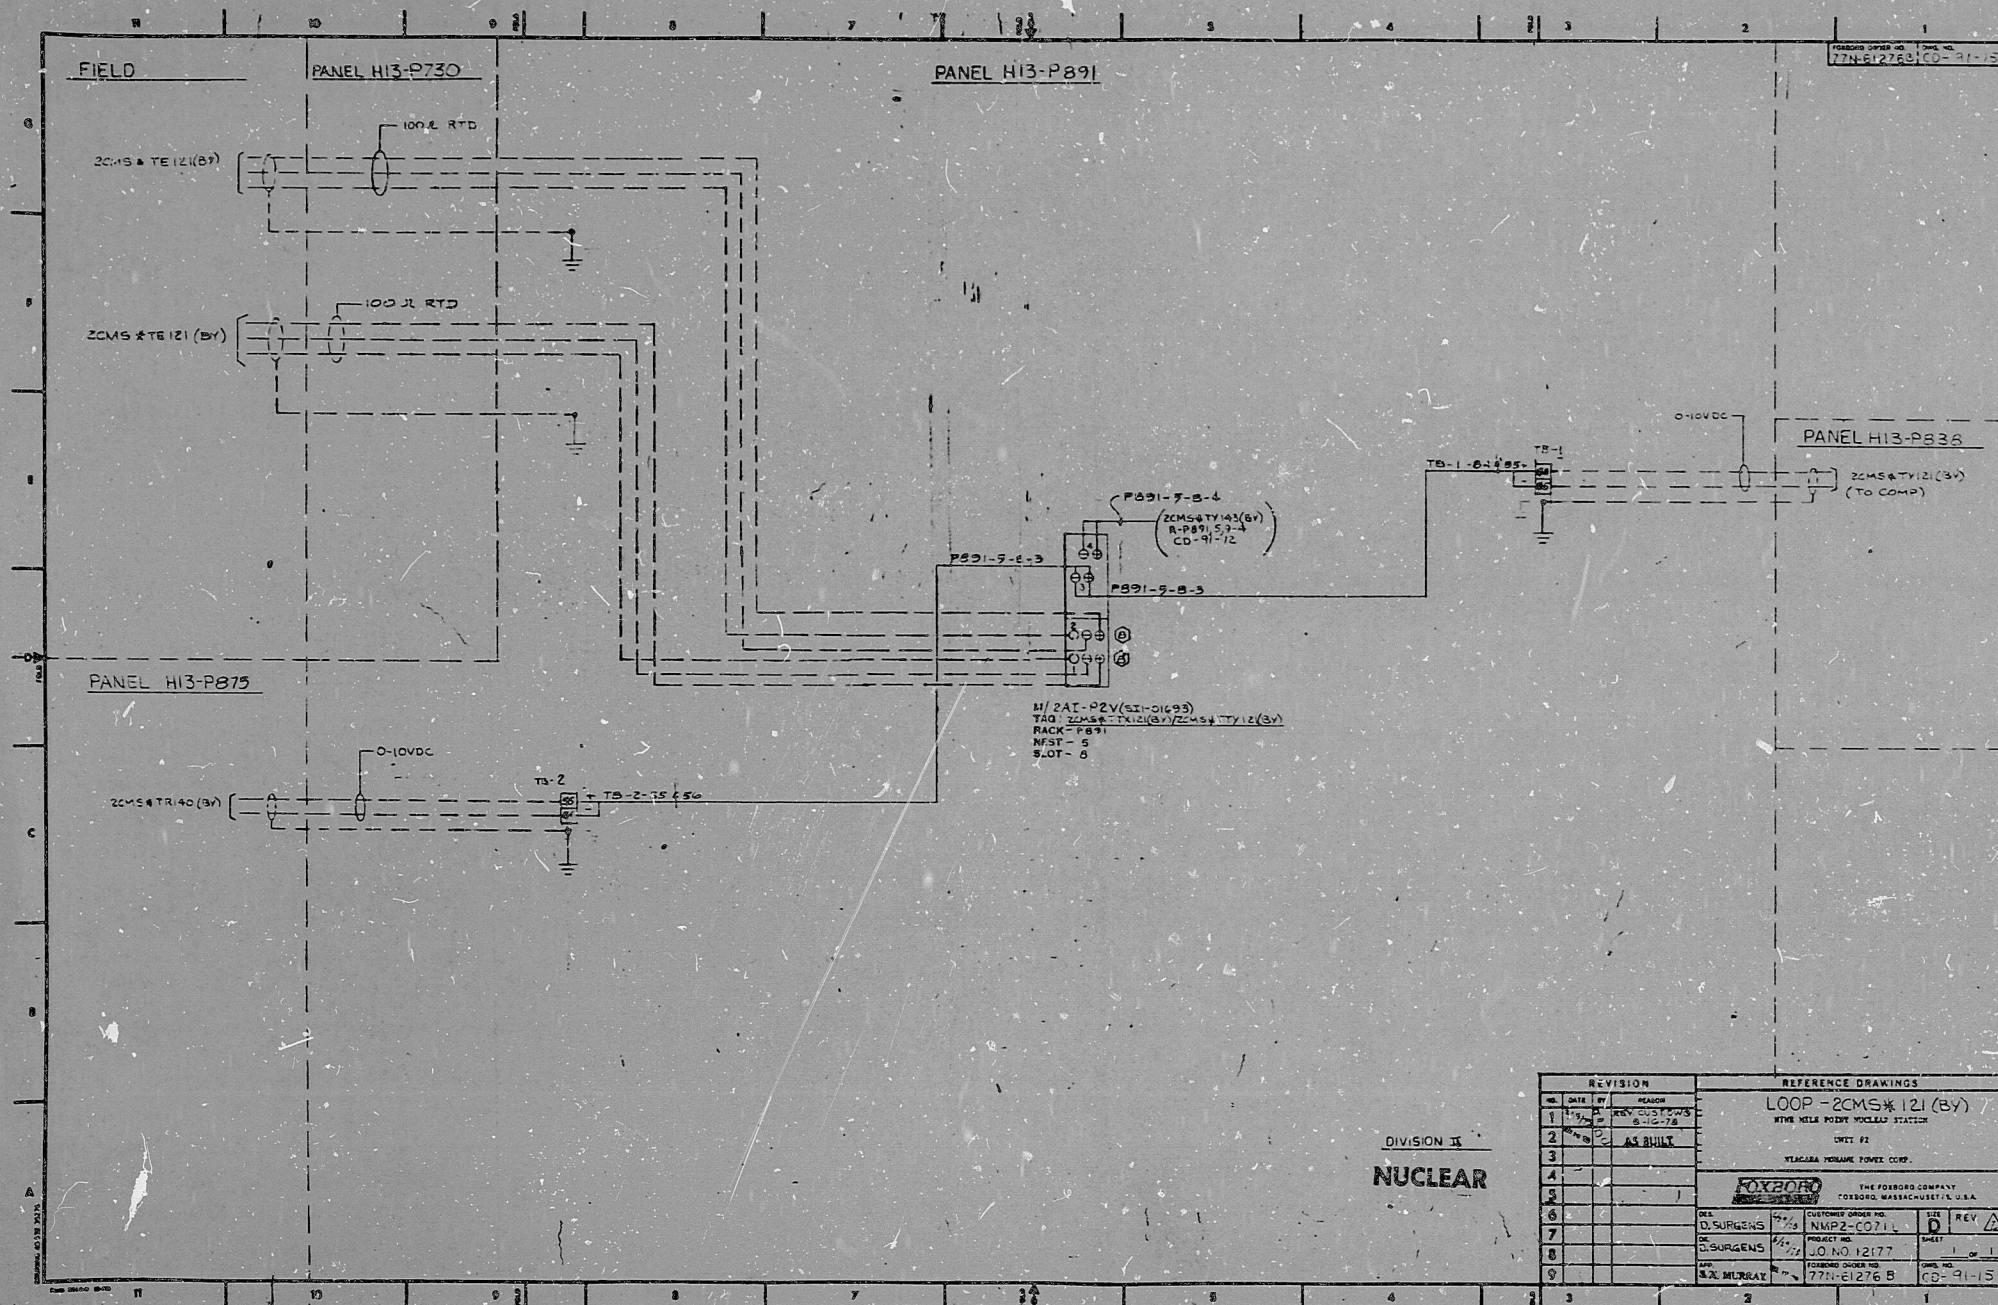

PRC
APERTURE
CARD

[illegible]

RIDS

8305040353

