


S-304

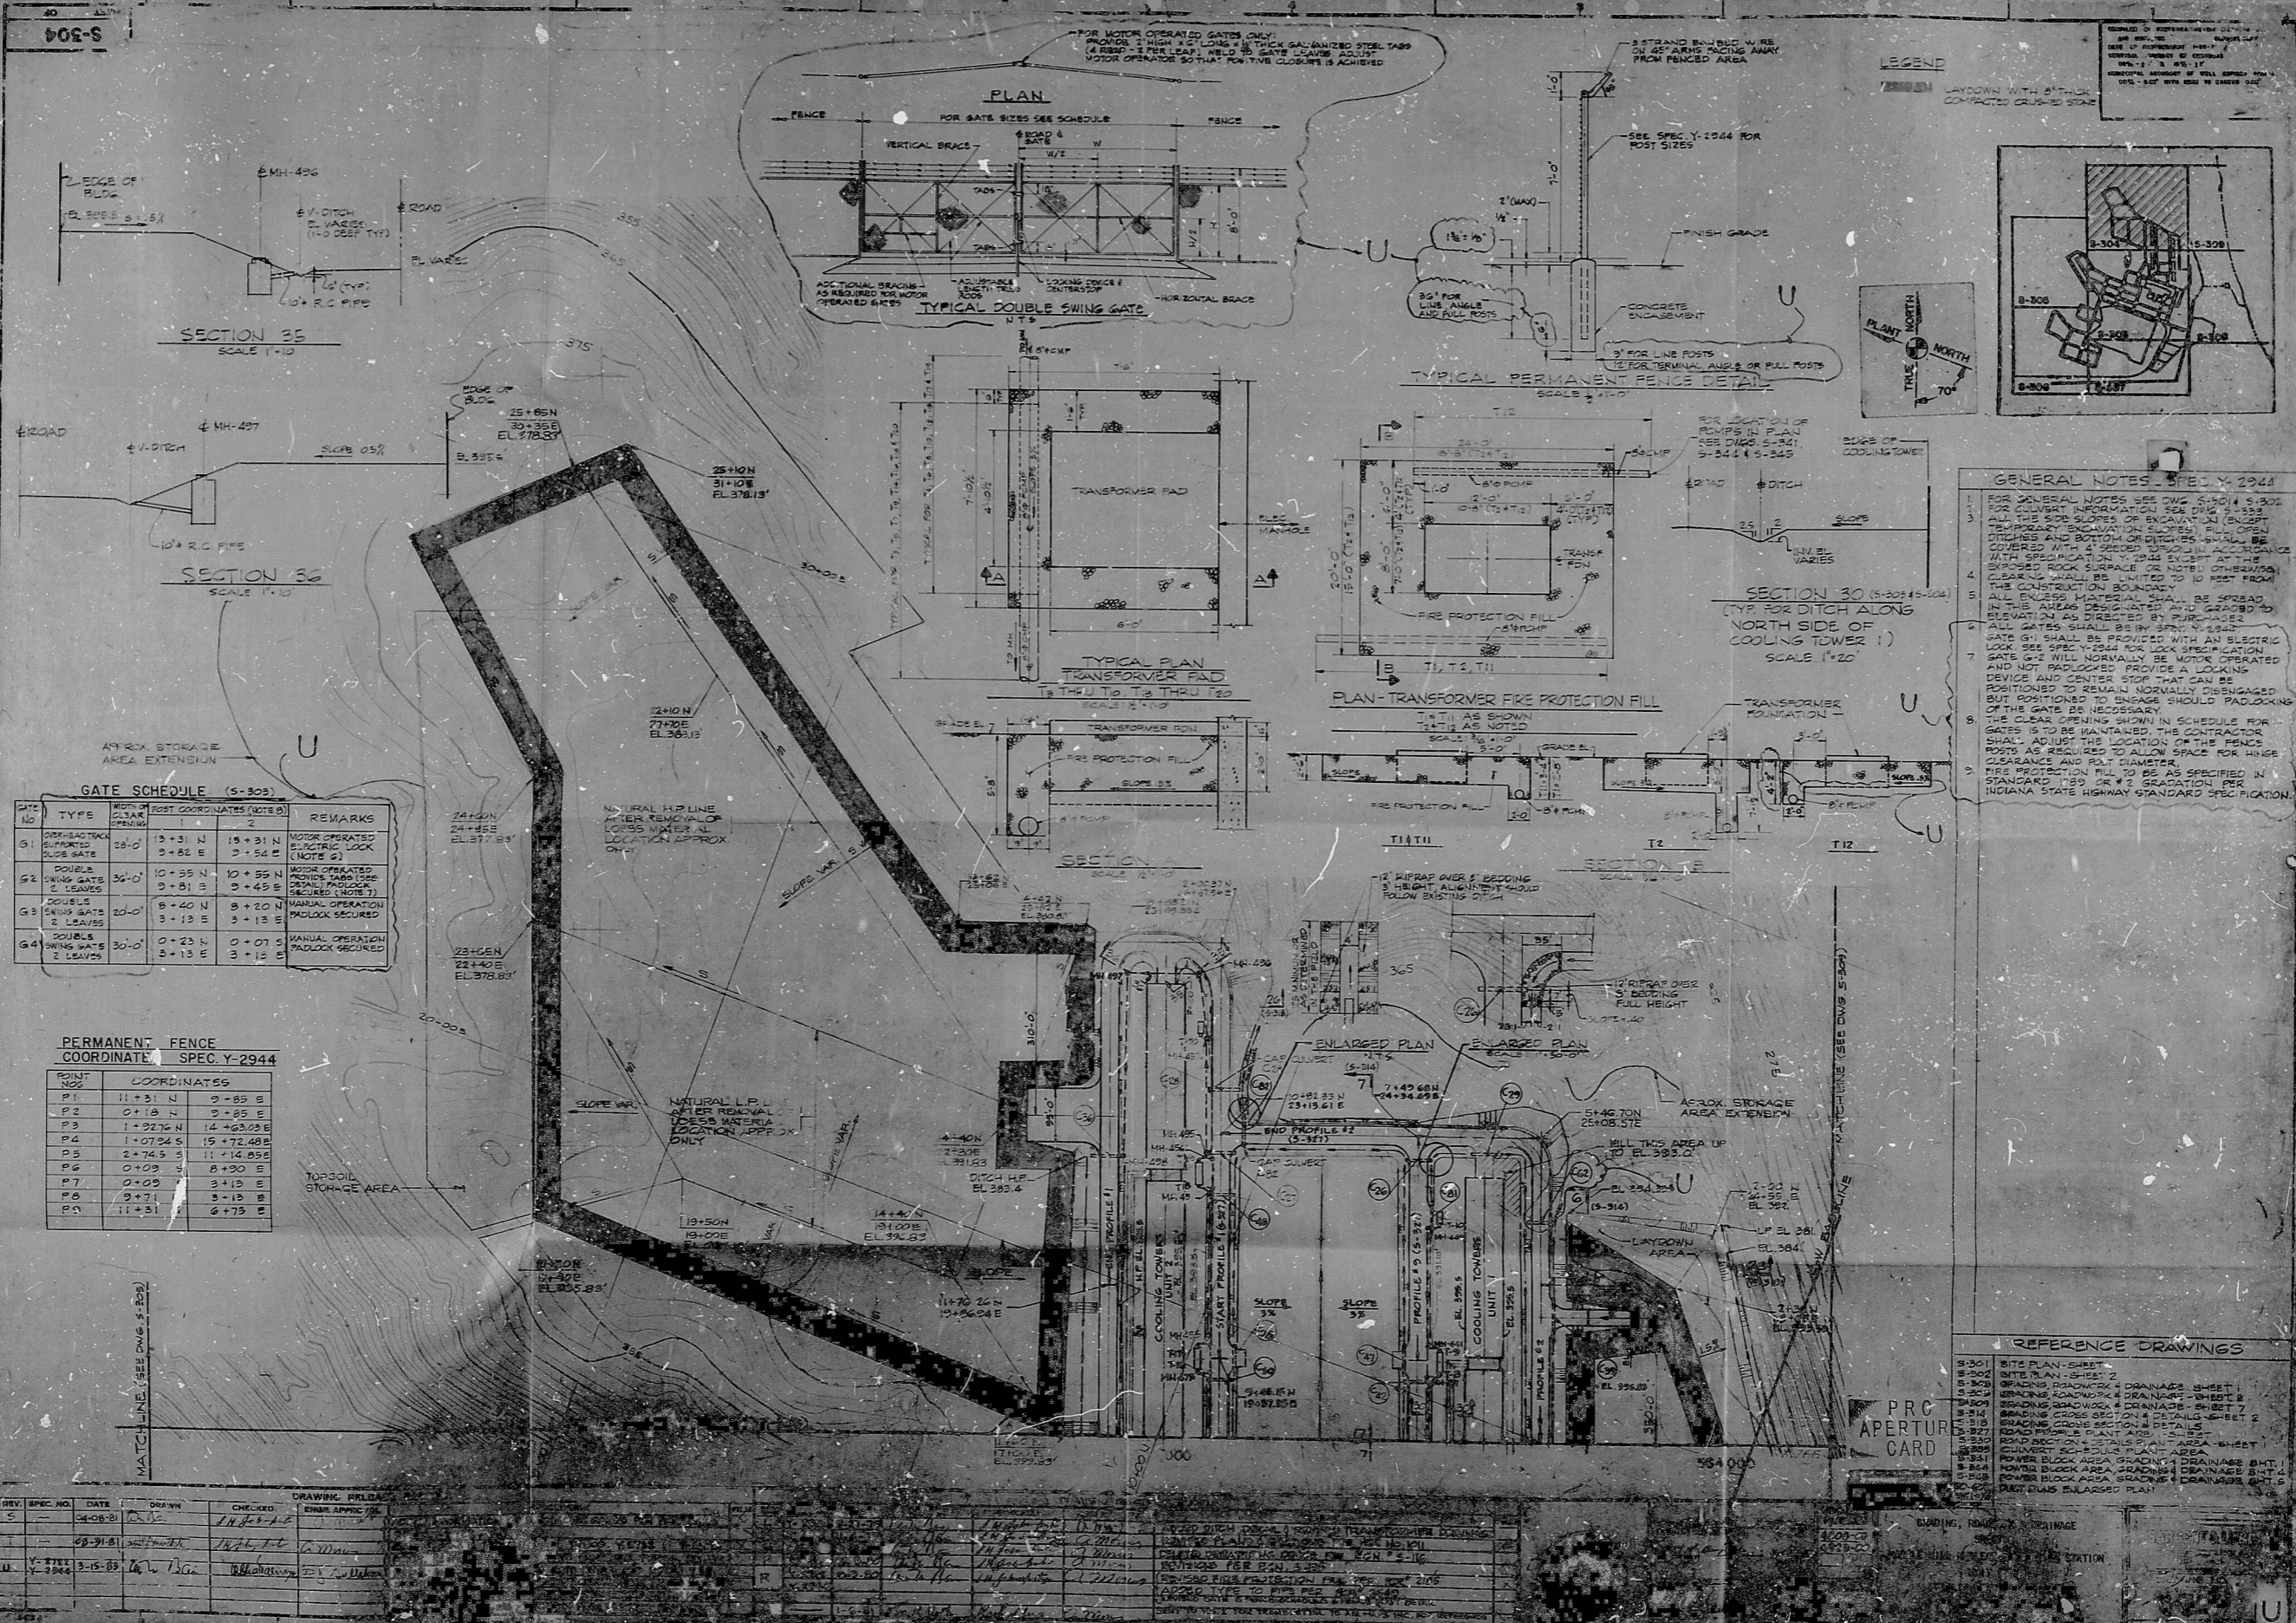

**GATE SCHEDULE (S-303)**

GATE NO.	TYPE	HEIGHT CLEAR	POST COORDINATES (NOTE B)	REMARKS
G1	ORIS-BACKSTOP SUPPORTED SLIDE GATE	28'-0"	13+31 N 9+82 E	MOTOR OPERATED ELECTRIC LOCK (NOTE 6)
G2	DOUBLE SWING GATE 2 LEAVES	36'-0"	10+35 N 9+21 E	MOTOR OPERATED DOUBLE TARGO (SEE SCHEDULE NOTE 7)
G3	DOUBLE SWING GATE 2 LEAVES	20'-0"	8+40 N 3+13 E	MANUAL OPERATION PADLOCK SECURED
G4	DOUBLE SWING GATE 2 LEAVES	30'-0"	0+23 N 3+13 E	MANUAL OPERATION PADLOCK SECURED

**PERMANENT FENCE COORDINATE SPEC. Y-2944**

POST NO.	COORDINATES
P1	11+31 N 0+85 E
P2	0+18 N 2+85 E
P3	1+22 N 14+63 E
P4	1+07 S 15+72 E
P5	2+74 S 11+14 E
P6	0+09 S 8+30 E
P7	0+09 S 3+13 E
P8	9+71 S 3+13 E
P9	11+31 N 6+73 E

**DRAWING REVISIONS**

REV.	DATE	BY	CHKD.	DESCRIPTION

- GENERAL NOTES - SPEC. Y-2944**
- FOR GENERAL NOTES SEE DWG. S-301 & S-302 FOR CURBET INFORMATION SEE DWG. S-303
  - ALL THE SIDE SLOPES OF EXCAVATION (EXCEPT TEMPORARY EXCAVATION ON SLOPES) SHALL BE COVERED WITH 4" GRADE OR DITCHES SHALL BE COVERED WITH 4" GRADE EXIST AT THE EXPOSED ROCK SURFACE OR NOTED OTHERWISE. CLEARING SHALL BE LIMITED TO 10 FEET FROM THE CONSTRUCTION BOUNDARY.
  - ALL EXCESS MATERIAL SHALL BE SPREAD IN THE AREAS DESIGNATED AND GRADED TO ELEVATION AS DIRECTED BY PURCHASER.
  - ALL GATES SHALL BE PROVIDED BY SPEC. Y-2944. GATE G1 SHALL BE PROVIDED WITH AN ELECTRIC LOCK SEE SPEC. Y-2944 FOR LOCK SPECIFICATION. GATE G2 WILL NORMALLY BE MOTOR OPERATED AND NOT PADLOCKED PROVIDE A LOCKING DEVICE AND CENTER STOP THAT CAN BE POSITIONED TO REMAIN NORMALLY ENGAGED AND NOT PADLOCKED TO ENGAGE SHOULD PADLOCKING OF THE GATE BE NECESSARY.
  - THE CLEAR OPENING SHOWN IN SCHEDULE FOR GATES IS TO BE MAINTAINED. THE CONTRACTOR SHALL ADJUST THE LOCATION OF THE FENCE POSTS AS REQUIRED TO ALLOW SPACE FOR HINGE CLEARANCE AND POST DIAMETER.
  - THE PROTECTION FILL TO BE AS SPECIFIED IN STANDARD 189 OR #2 GRADATION PER INDIANA STATE HIGHWAY STANDARD SPECIFICATION.

**REFERENCE DRAWINGS**

S-301	SITE PLAN - SHEET 1
S-302	SITE PLAN - SHEET 2

PRC APERTURE CARD

8305040367

RIDS

