
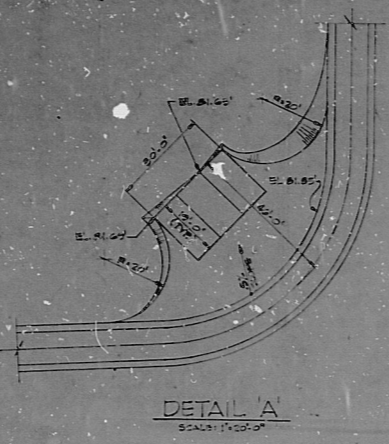





S-308



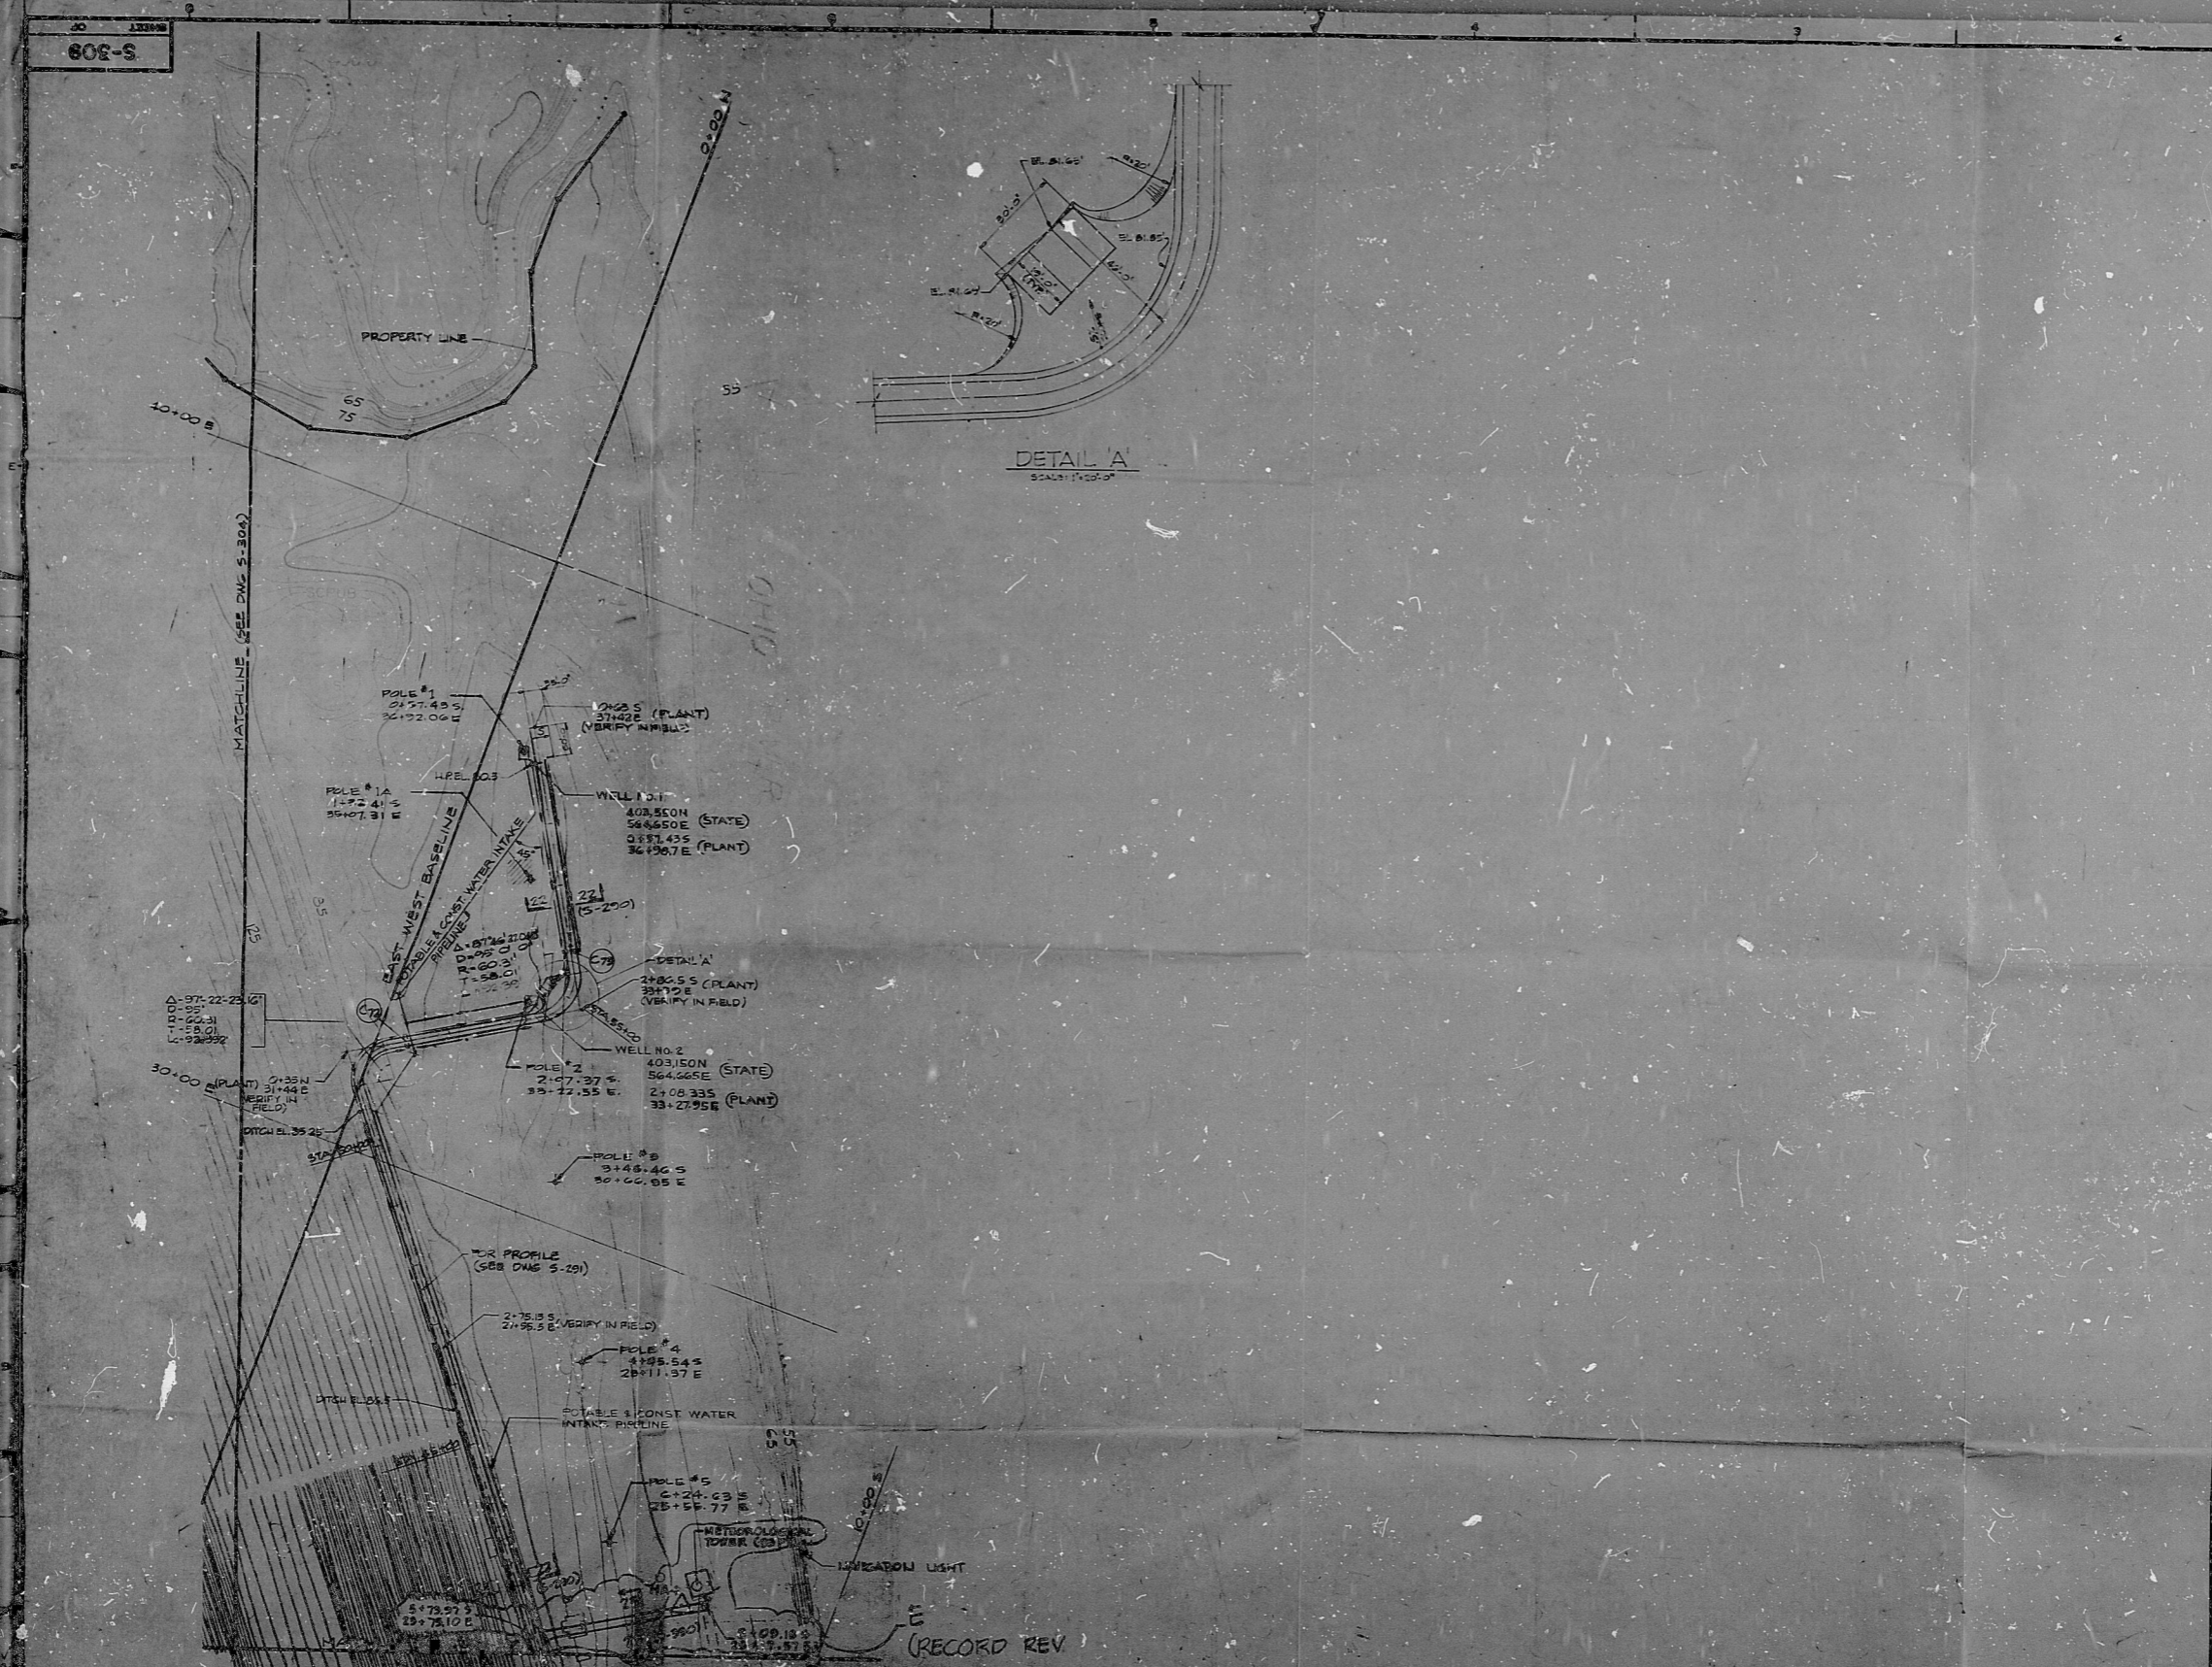


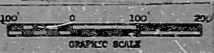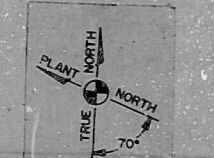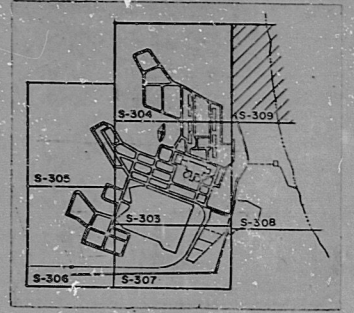

NOTES
 1. FOR GENERAL NOTES SEE DWG. S-301 & S-302.

REFERENCE DRAWINGS
 S-301 SITE PLAN, SHEET 1
 S-302 SITE PLAN, SHEET 2
 S-304 GRADING, ROADWORK & DRAINAGE - SHEET 2
 S-305 GRADING, ROADWORK & DRAINAGE - SHEET 3
 S-306 ROAD SECTION & DETAILS PLANT AREA SHEET

PRC
 APERTURE
 CARD


FOR CONCRETE STRUCTURE & SITEWORK BIDDING
 SEE SPECIFICATIONS & R.F.I.'S
 GENERAL REVISION
 REVISION NO. 11/16/81




GRADING, ROADWORK & DRAINAGE
 SHEET 7
 MARBLE HILL NUCLEAR GENERATING STATION
 UNIT 1 & 2
 PUBLIC SERVICE INDIANA
 PLAINFIELD, INDIANA

BARCLAY
 S-308
 E

8305040401

RIDS
RIDS

