


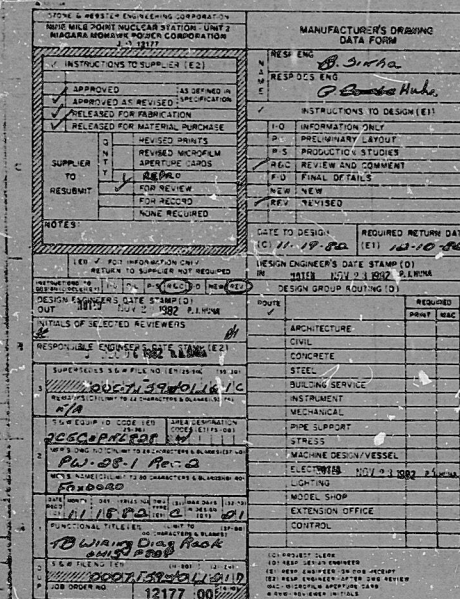



RIDS

8305040590

