

PRC APERTURE CARD

PLAN EL. 401'-0"

NOTES:  
 1. LPM ORE-PROU4, IRE-PRO27 AND 288-PRO27 ARE LOCATED IN TURBINE BUILDING ELEV. 401.

ARM No.	INSTRUMENT No.
ORE-ARO11	
ORE-ARO12	
ORE-ARO13	
ORE-ARO31	

REV.	DATE	BY	CHKD.	DESCRIPTION
1	11-10-70	...	...	PROVIDED WALL AND 1/2" OPENINGS LAUNDRY DRAIN TANK...
2	11-10-70	...	...	REVISED DRAWINGS...
3	11-10-70	...	...	REVISED RADWASTE ROOM FLOOR DIMENSIONS...
4	11-10-70	...	...	ADDED RADWASTE MONITORS AND INSTRUMENT CALIBRATION TAG...

REV.	DATE	FIELD	PREPARED	REVIEWED	APPROVED	PURPOSE
A	11-10-70	...	...	...	...	BYRON REV. J. DATED 11-10-70 ADDED UNIQUE FEATURE FOR INFORMATION PER SPEC. Y-2722 AND SPEC. Y-2739
B	7-16-82	...	...	...	...	ADDED UNIQUE FEATURE ECR. C-6376 FOR INFORMATION PER SPEC. Y-2722 & Y-2739.

**GENERAL ARRANGEMENT  
 AUX. BLDG. RADIATION SHIELDING  
 BYRON SHADWOOD STATION UNIT 1 & 2  
 COMMONWEALTH DIVISION CO.  
 CHICAGO, ILLINOIS**

SCALE: 1/8" = 1'-0"

PROJECT NUMBER: 480500  
 482300

DRAWING NO. REL. M-24 SHEET 6 OF 20

DESIGNED BY: I. ROSE  
 CHECKED BY: J. ROSE  
 DATE: 10-1-70


APPROVED BY: [Signature]

DATE: 10-1-70

PROJECT: MARBLE HILL NUCLEAR GENERATING STATION 1 & 2 PUBLIC SERVICE, INDIANA PLAINFIELD, INDIANA

DESIGNED BY: [Signature]  
 CHECKED BY: [Signature]  
 DATE: 10-1-70

DRAWING NO. REL. M-24 SHEET 6 OF 20

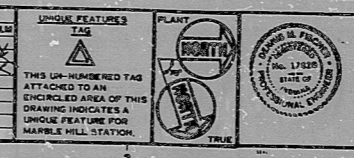

8305050356

**RIDS**

