

PRC
APERTURE
CARD




REV.	DATE	DESCRIPTION
C	1-28-78	CHANGED WALL THICKNESS ADDED REINFORCING BARS
D	2-2-78	PROVIDED OPENING IN WALL
E	11-1-78	CHANGED WALL THICKNESS
F	12-13-78	PROVIDED SUMP PITS
G	11-11-78	ADDED RADIATION MONITORS

REV.	DATE	PREPARED	REVIEWED	APPROVED	PURPOSE
A	12-12-78				BYRON REV 'G' DATED 11-18-79 ADDED UNIQUE FEATURES FOR INFORMATION PER SPEC-T-2722 AND SPEC-T-2739


FOR NOTES SEE M-24 SH 1

NO.	DATE	DESCRIPTION
1	11-1-78	GENERAL ARRANGEMENT FUEL HANDLING BLDG. RADIATION SHIELDING
2	11-1-78	FOR INFORMATION PER SPEC-T-2722 AND SPEC-T-2739

REV.	DATE	PREPARED	REVIEWED	APPROVED	PURPOSE
A	12-12-78				BYRON REV 'G' DATED 11-18-79 ADDED UNIQUE FEATURES FOR INFORMATION PER SPEC-T-2722 AND SPEC-T-2739

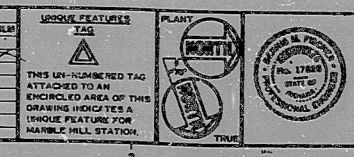

SCALE	1/4" = 1'-0"
PROJECT NUMBER	10000
DRAWING NO.	M-24
SHEET NO.	14 OF 20

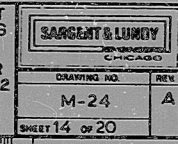

17
11
8.5
8.5
11
8.5
11
17

17
11
8.5
8.5
11
8.5
11
17

RIDS

8B05050380

