


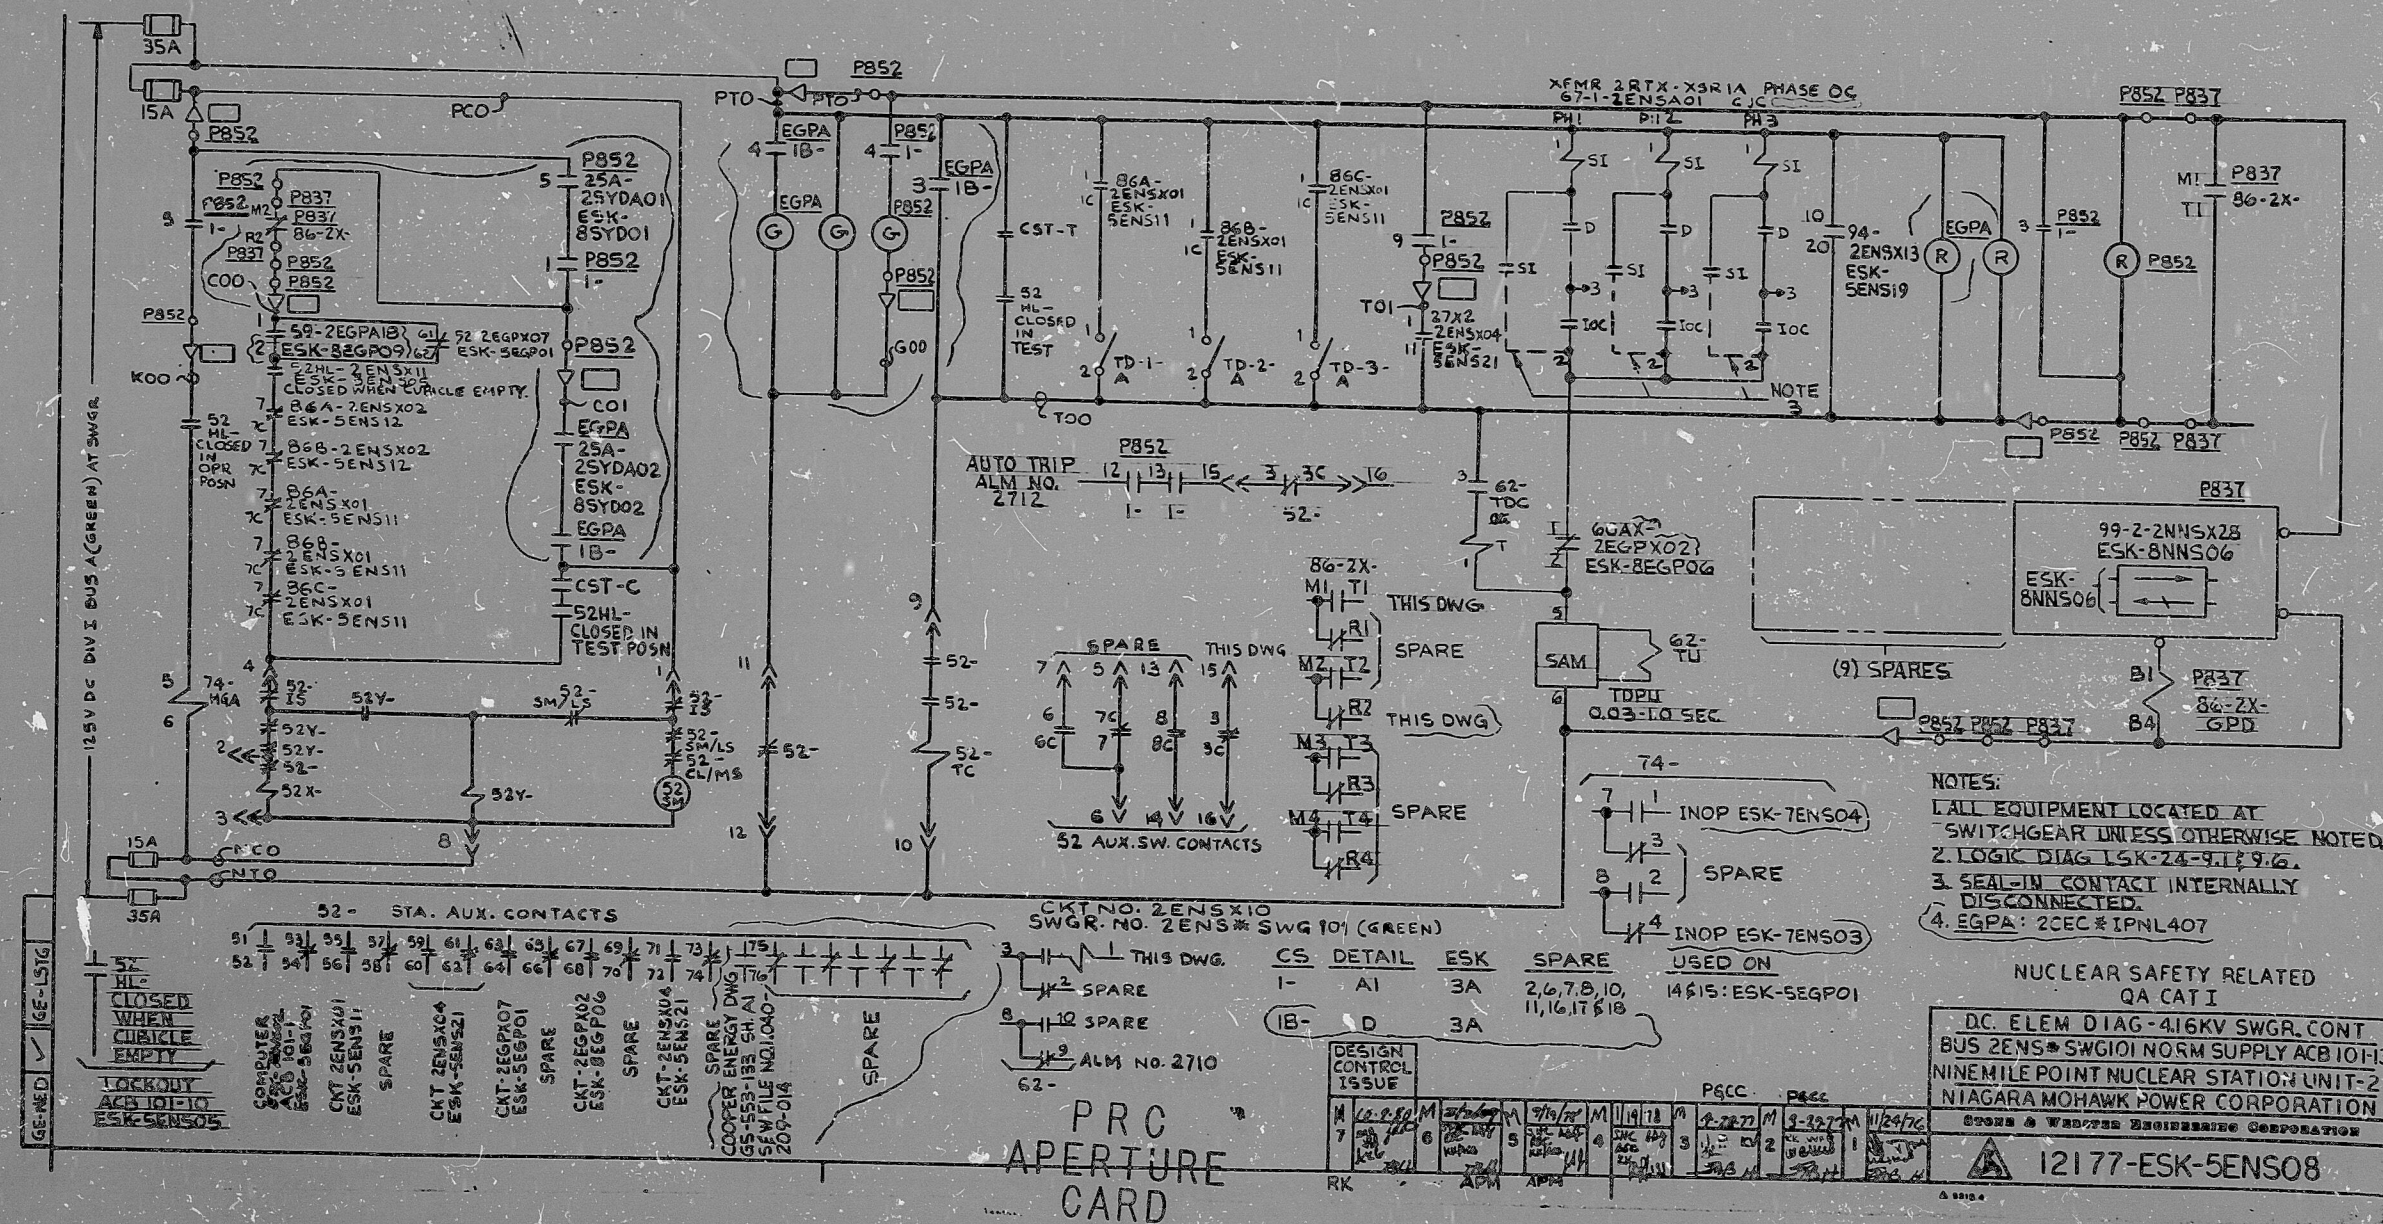



RIDS

4305060371

