


# PRC APERTURE CARD

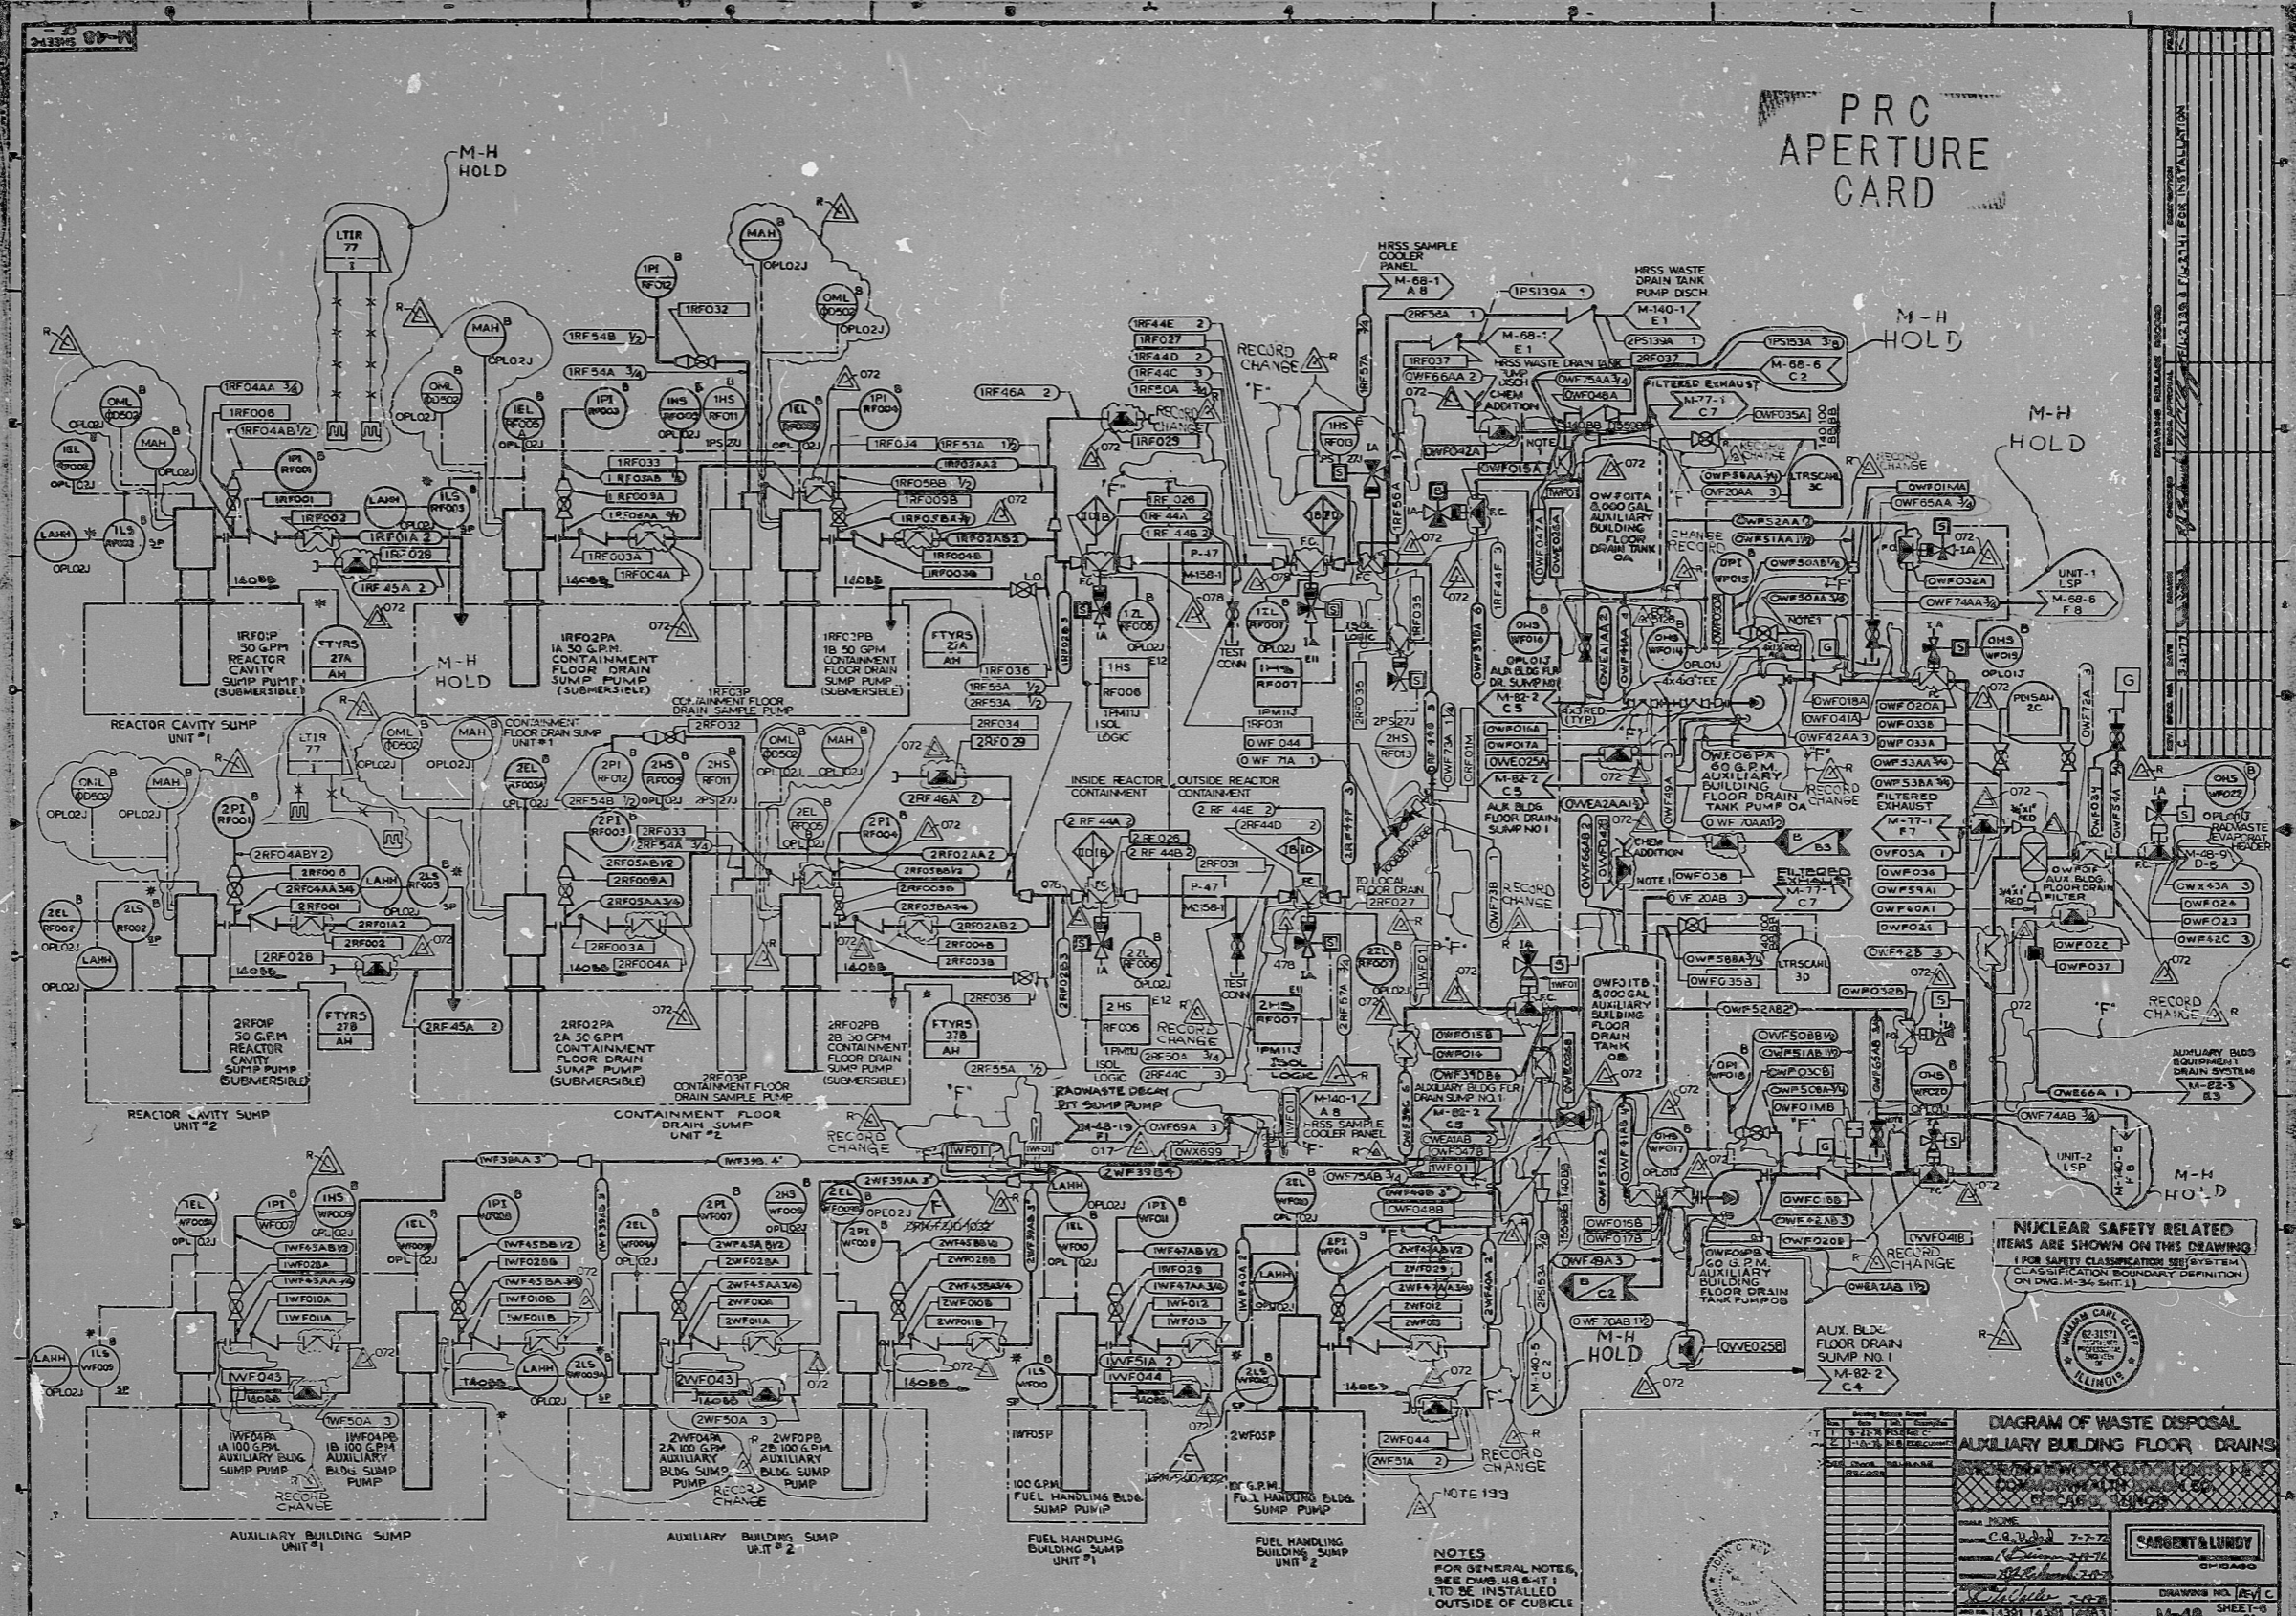

NUCLEAR SAFETY RELATED ITEMS ARE SHOWN ON THIS DRAWING FOR SAFETY CLASSIFICATION SYSTEM CLASSIFICATION BOUNDARY DEFINITION (ON DWG. M-34 SHT. 1)

DIAGRAM OF WASTE DISPOSAL AUXILIARY BLDG FLOOR DRAINS	
DATE	7-7-77
BY	W. J. ...
CHECKED	...
APPROVED	...
DRAWING NO.	M-48
SHEET	OF-21

NOTES FOR GENERAL NOTE, SEE DWG. M-34 SHT. 1 TO BE INSTALLED OUTSIDE OF CUBICLE

DRAWING RELEASE RECORD				DRAWING REVISION RECORD			
REV.	DATE	BY	REASON	REV.	DATE	BY	REASON

DIAGRAM OF WASTE DISPOSAL AUXILIARY BLDG FLOOR DRAINS


DRAWING NO. M-48  
SHEET OF-21

8305060588

RIDS

