


DATE: 08-12-78
 INT. NO. 11
 FILE NO. 11

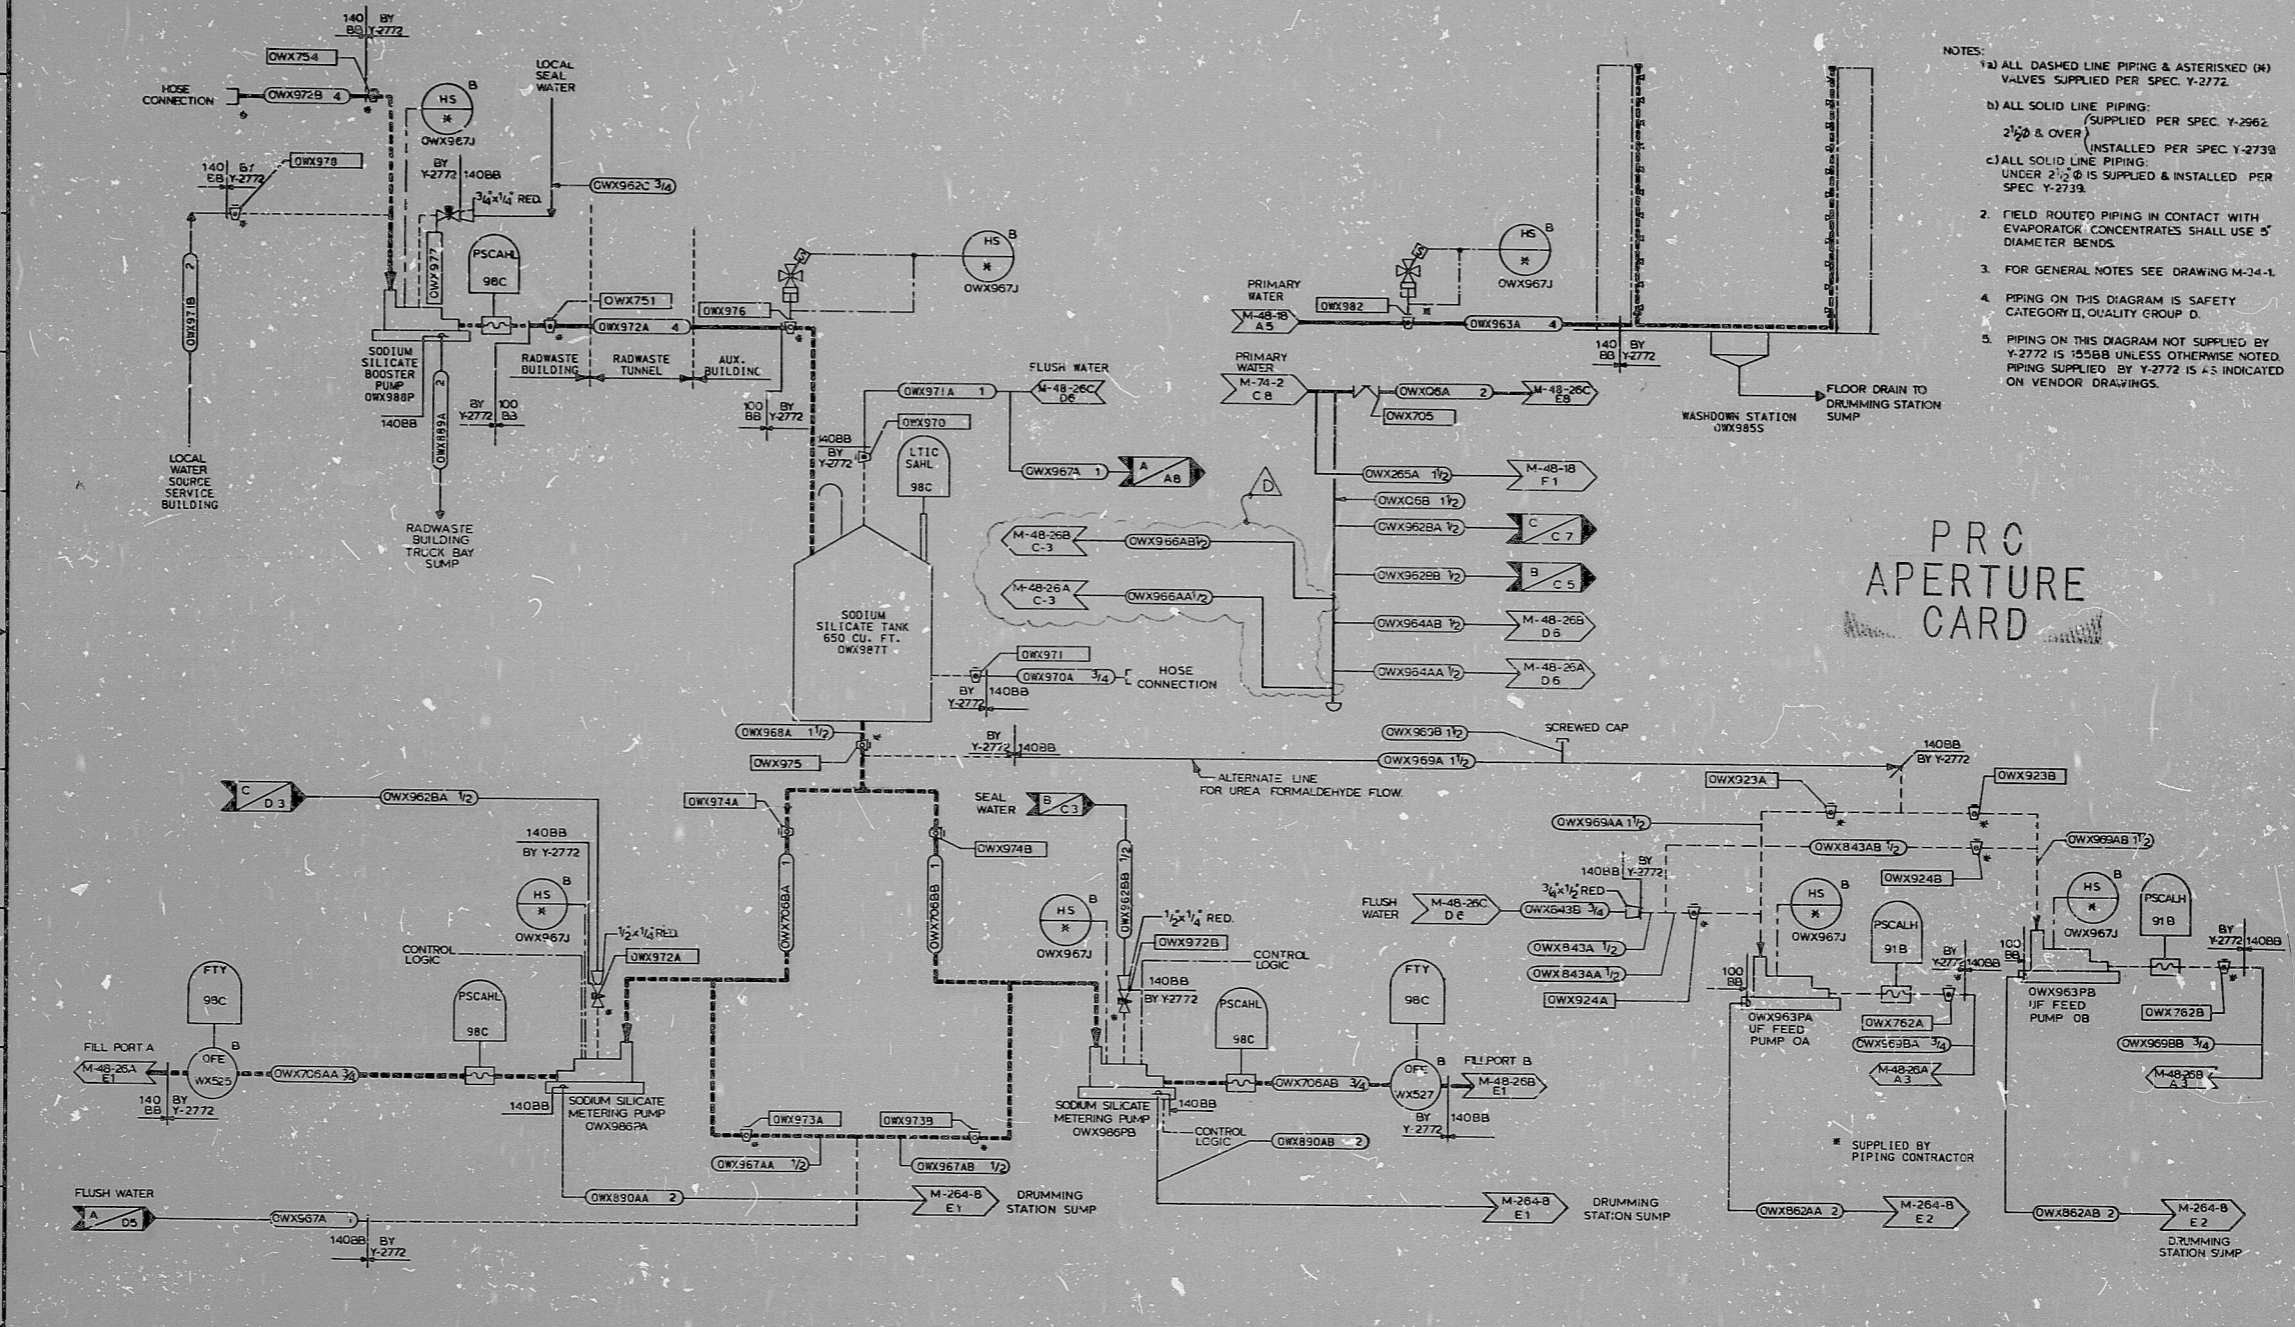

- NOTES:
- 1) ALL DASHED LINE PIPING & ASTERISKED (H) VALVES SUPPLIED PER SPEC. Y-2772.
 - 2) ALL SOLID LINE PIPING: (SUPPLIED PER SPEC. Y-2662, 2 1/2" & OVER) (INSTALLED PER SPEC. Y-2739 UNDER 2 1/2" IS SUPPLIED & INSTALLED PER SPEC. Y-2739).
 - 3) ALL SOLID LINE PIPING UNDER 2 1/2" IS SUPPLIED & INSTALLED PER SPEC. Y-2739.
 - 4) FIELD ROUTED PIPING IN CONTACT WITH EVAPORATOR CONCENTRATES SHALL USE 5" DIAMETER BENDS.
 - 5) FOR GENERAL NOTES SEE DRAWING M-34-1.
 - 6) PIPING ON THIS DIAGRAM IS SAFETY CATEGORY II, QUALITY GROUP D.
 - 7) PIPING ON THIS DIAGRAM NOT SUPPLIED BY Y-2772 IS 155BB UNLESS OTHERWISE NOTED. PIPING SUPPLIED BY Y-2772 IS AS INDICATED ON VENDOR DRAWINGS.

PRC
 APERTURE
 CARD

REV.	DATE	FIELD	PREPARED	REVIEWED	APPROVED	PURPOSE
B	5-22-77					GEN'L REV - FOR FAB PER SPEC. Y-2962 & CONSTR. PER SPEC. Y-2739
C	12-24-80					GENERAL REVISION - FOR FAB Y-2962 & Y-2772, CONSTR. PER Y-2739
D	08-11-81					GENERAL REVISION - FOR FAB PER SPEC. Y-2772 & CONSTR. PER SPEC. Y-2739 - FOR RECORD Y-2962




DIAGRAM OF RADWASTE SOLIDIFICATION SYSTEM
 MARELE HILL NUCLEAR GENERATING STATION
 UNIT 1 & 2
 PUBLIC SERVICE INDIANA
 PLAINFIELD, INDIANA

SARGENT & LUNDY
 ENGINEERS
 CHICAGO, ILL.

DRAWING NO. M-48
 SHEET 27 OF 28

RIDS

8305060705

