


PRC APERTURE CADD

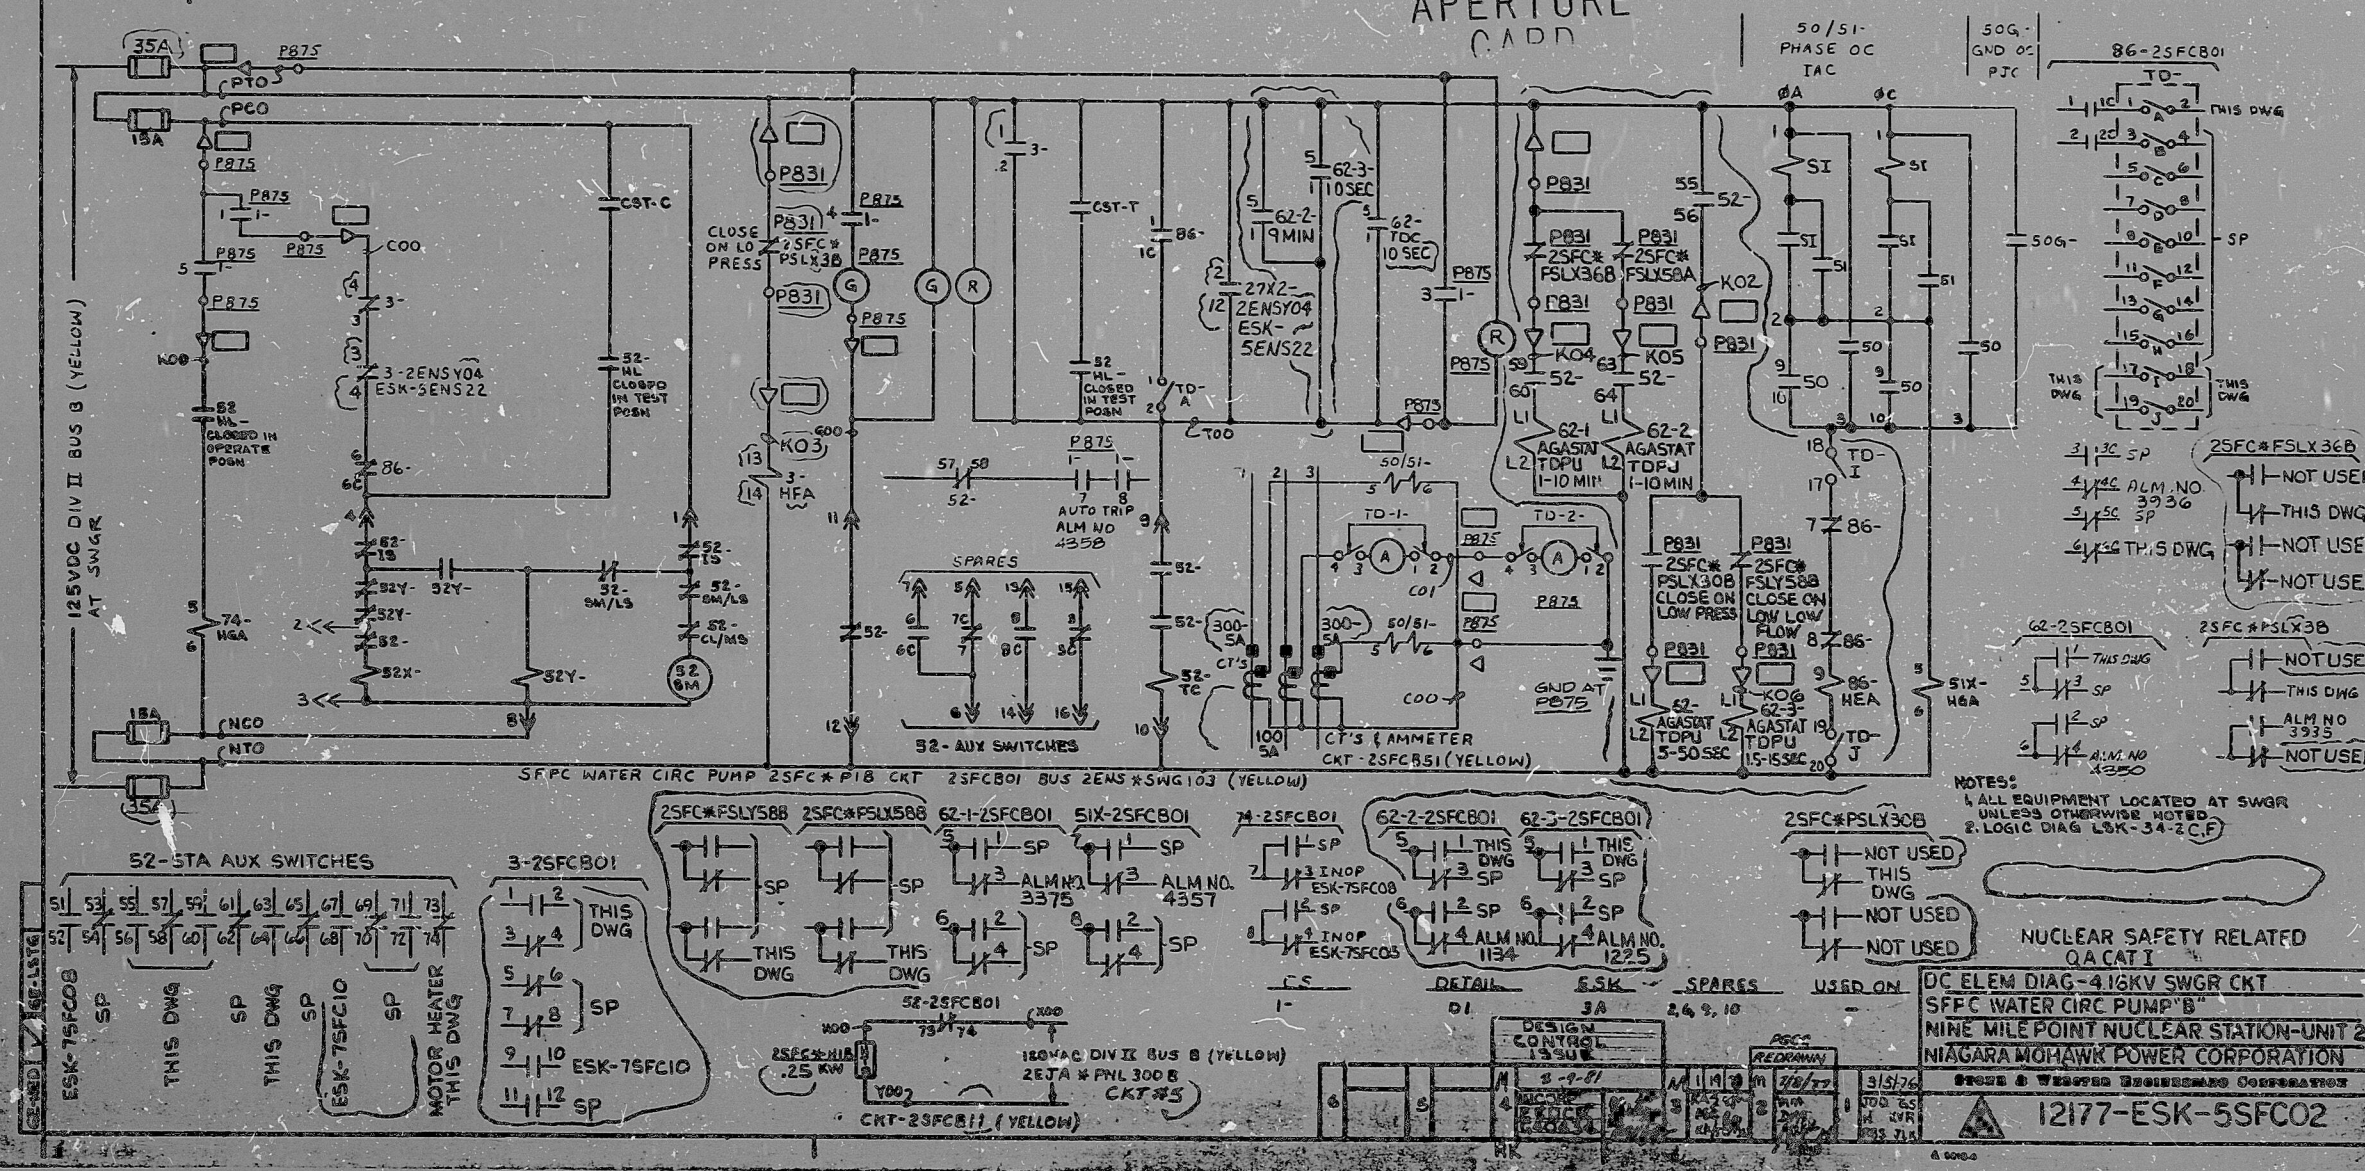

RIDS

8305090063

