


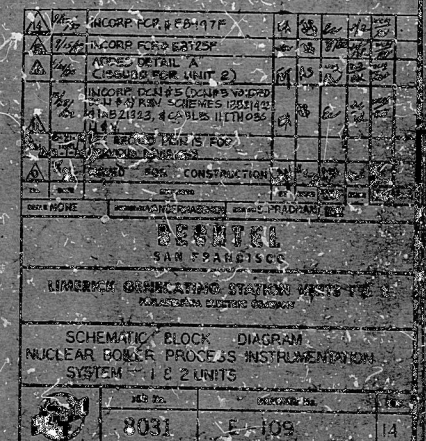



PDR RIDS

8406020 267

