


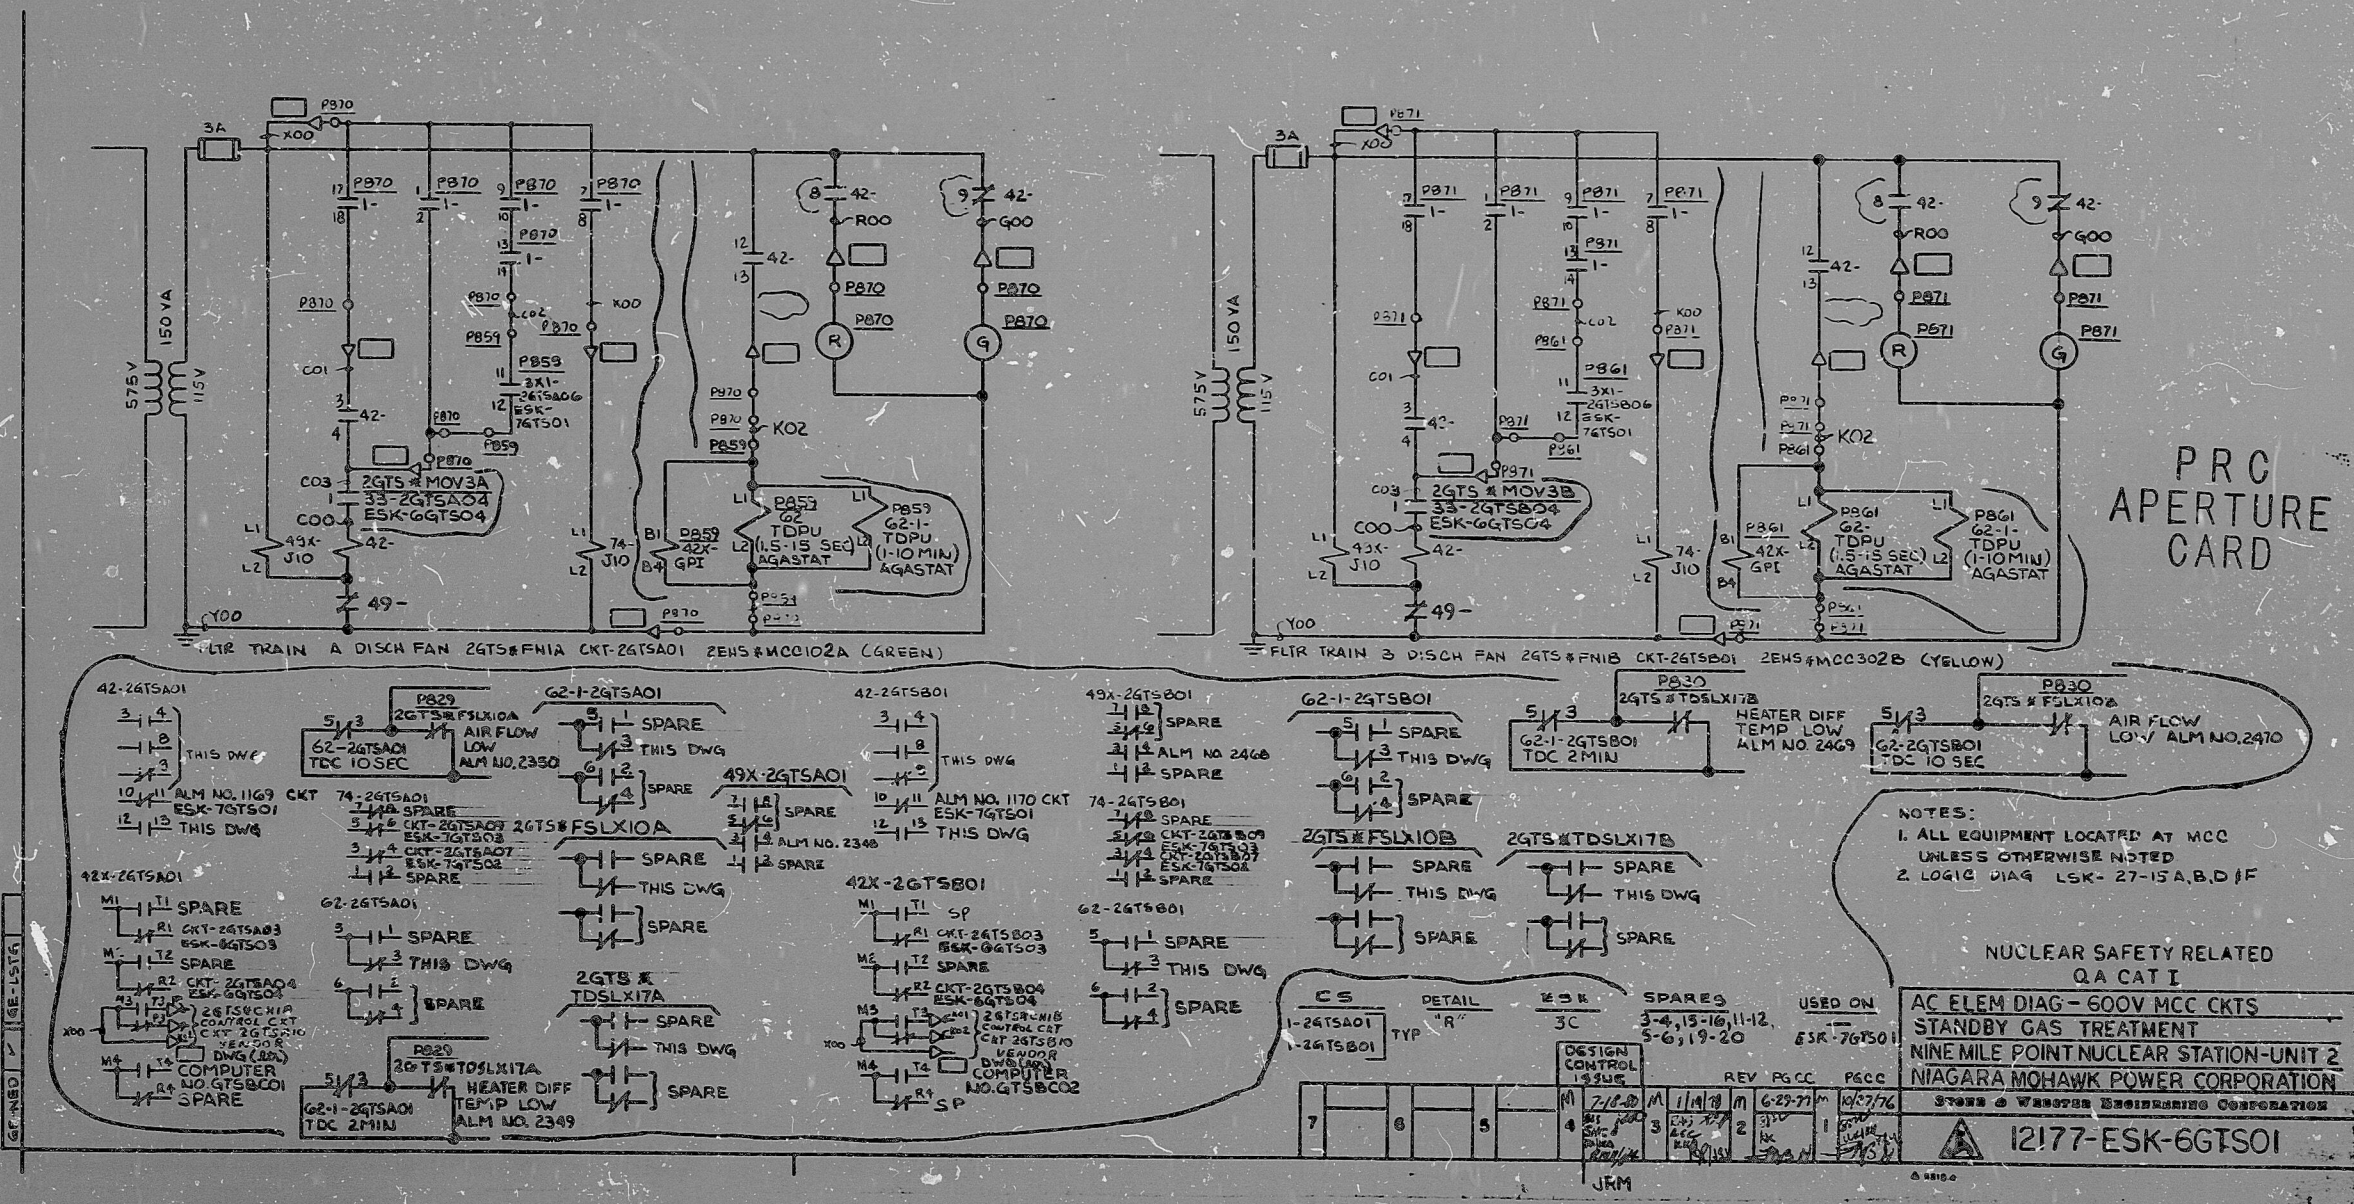

RIDS

835090181

