


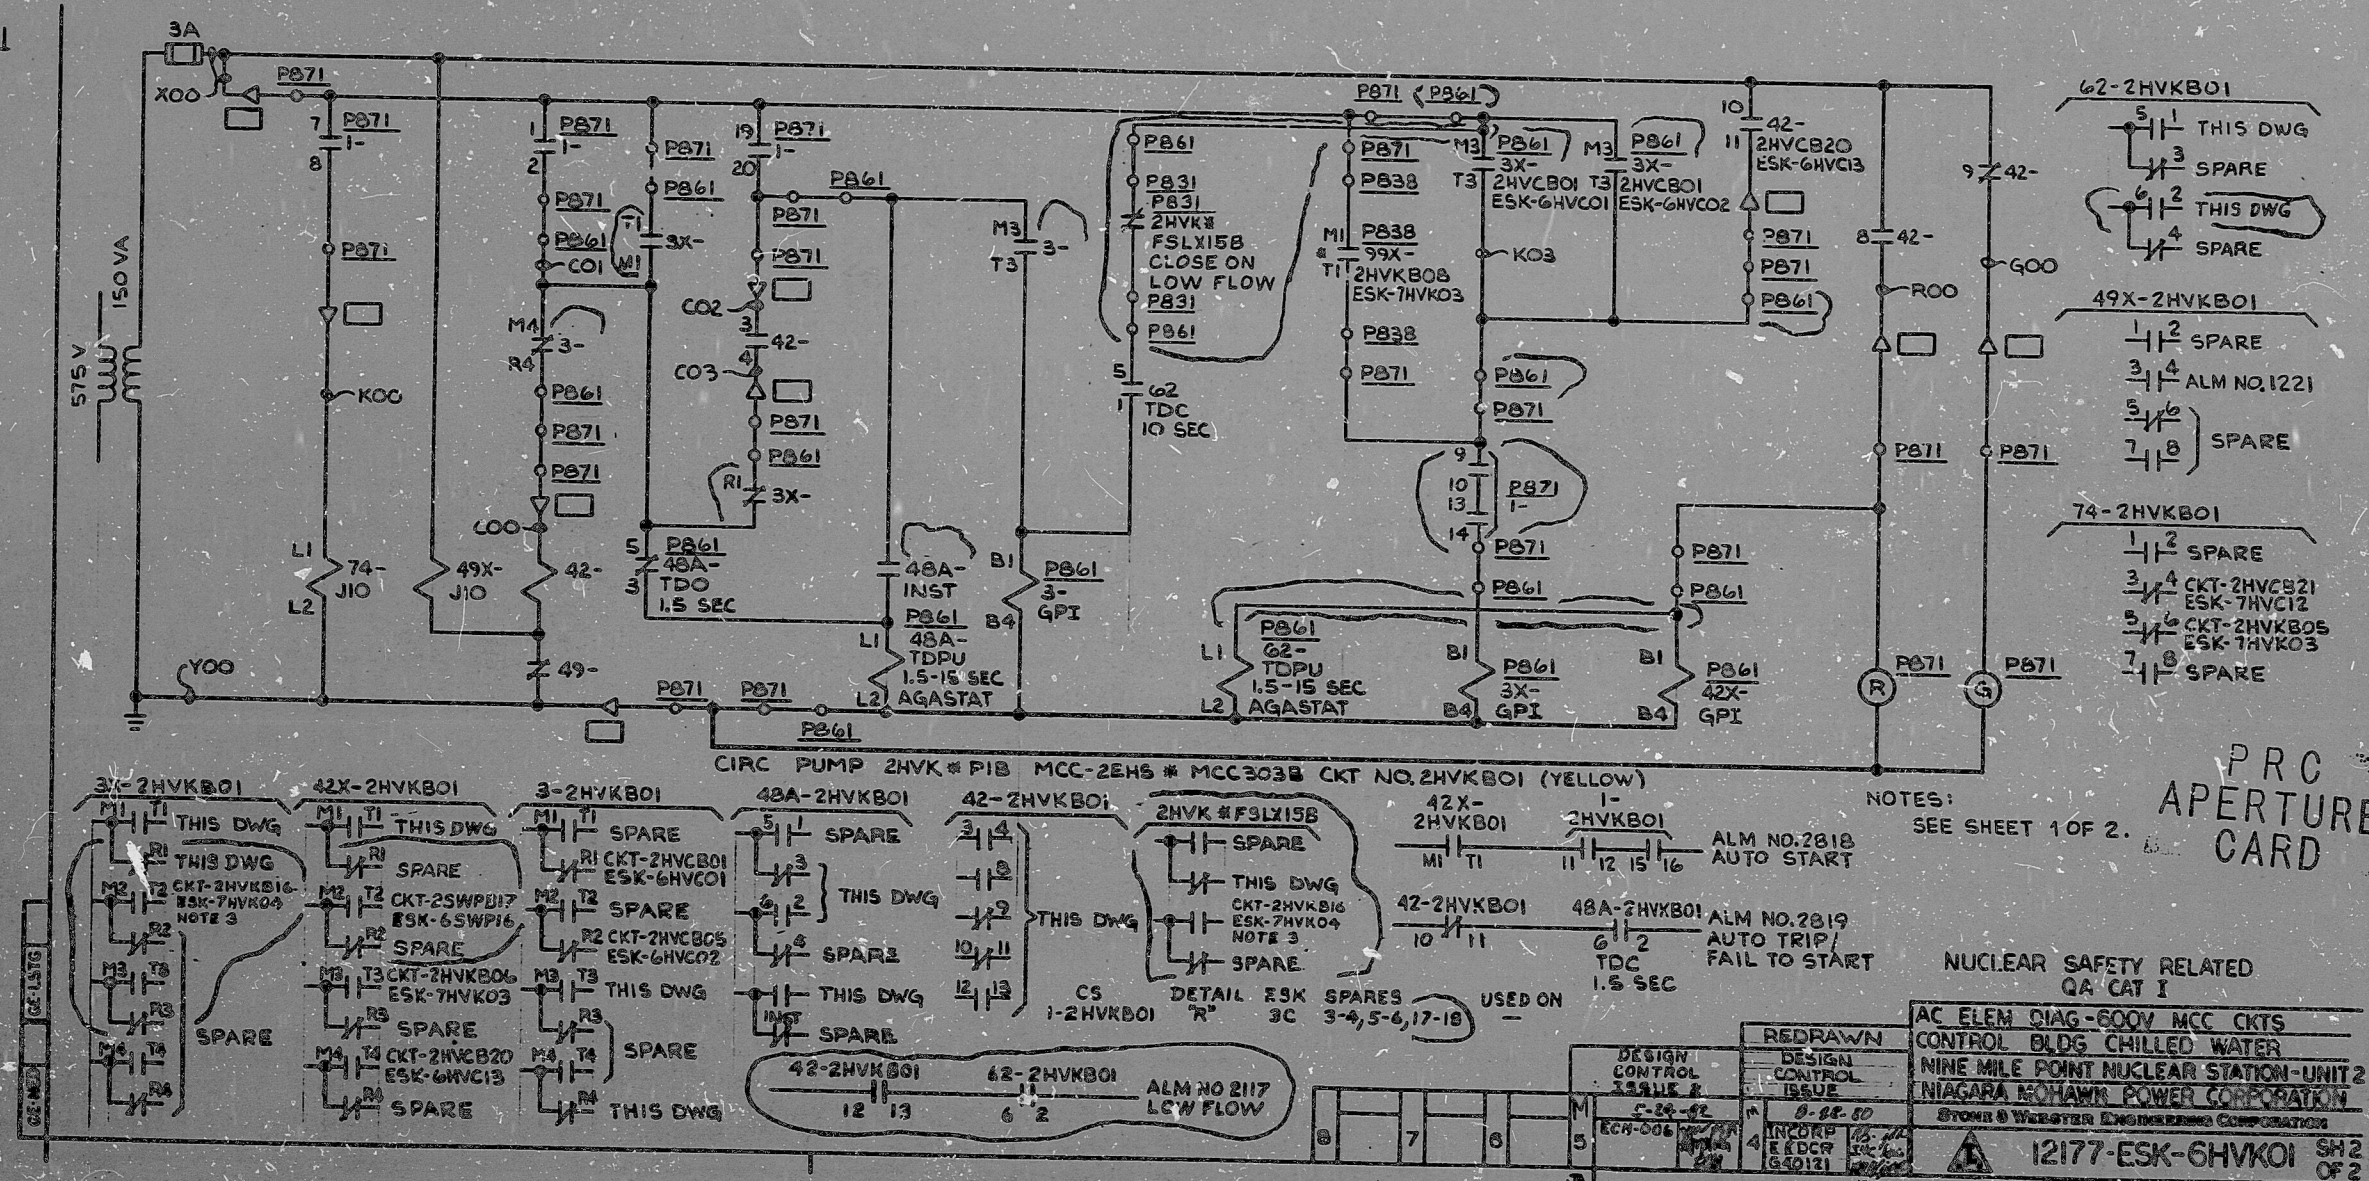

PRC
APERTURE
CARD

NUCLEAR SAFETY RELATED
QA CAT I

AC ELEM DIAG-600V MCC CKTS
CONTROL BLDG CHILLED WATER
NINE MILE POINT NUCLEAR STATION-UNIT 2
NIAGARA MOHAWK POWER CORPORATION
STONE & WEBSTER ENGINEERING CORPORATION
12177-ESK-6HVKOI SH 2
OF 2

RIDS

8305Q90283

