



DS-M
SAP UNIT 0-2A
61-90-10-10-31YB
00-25-0-11-1

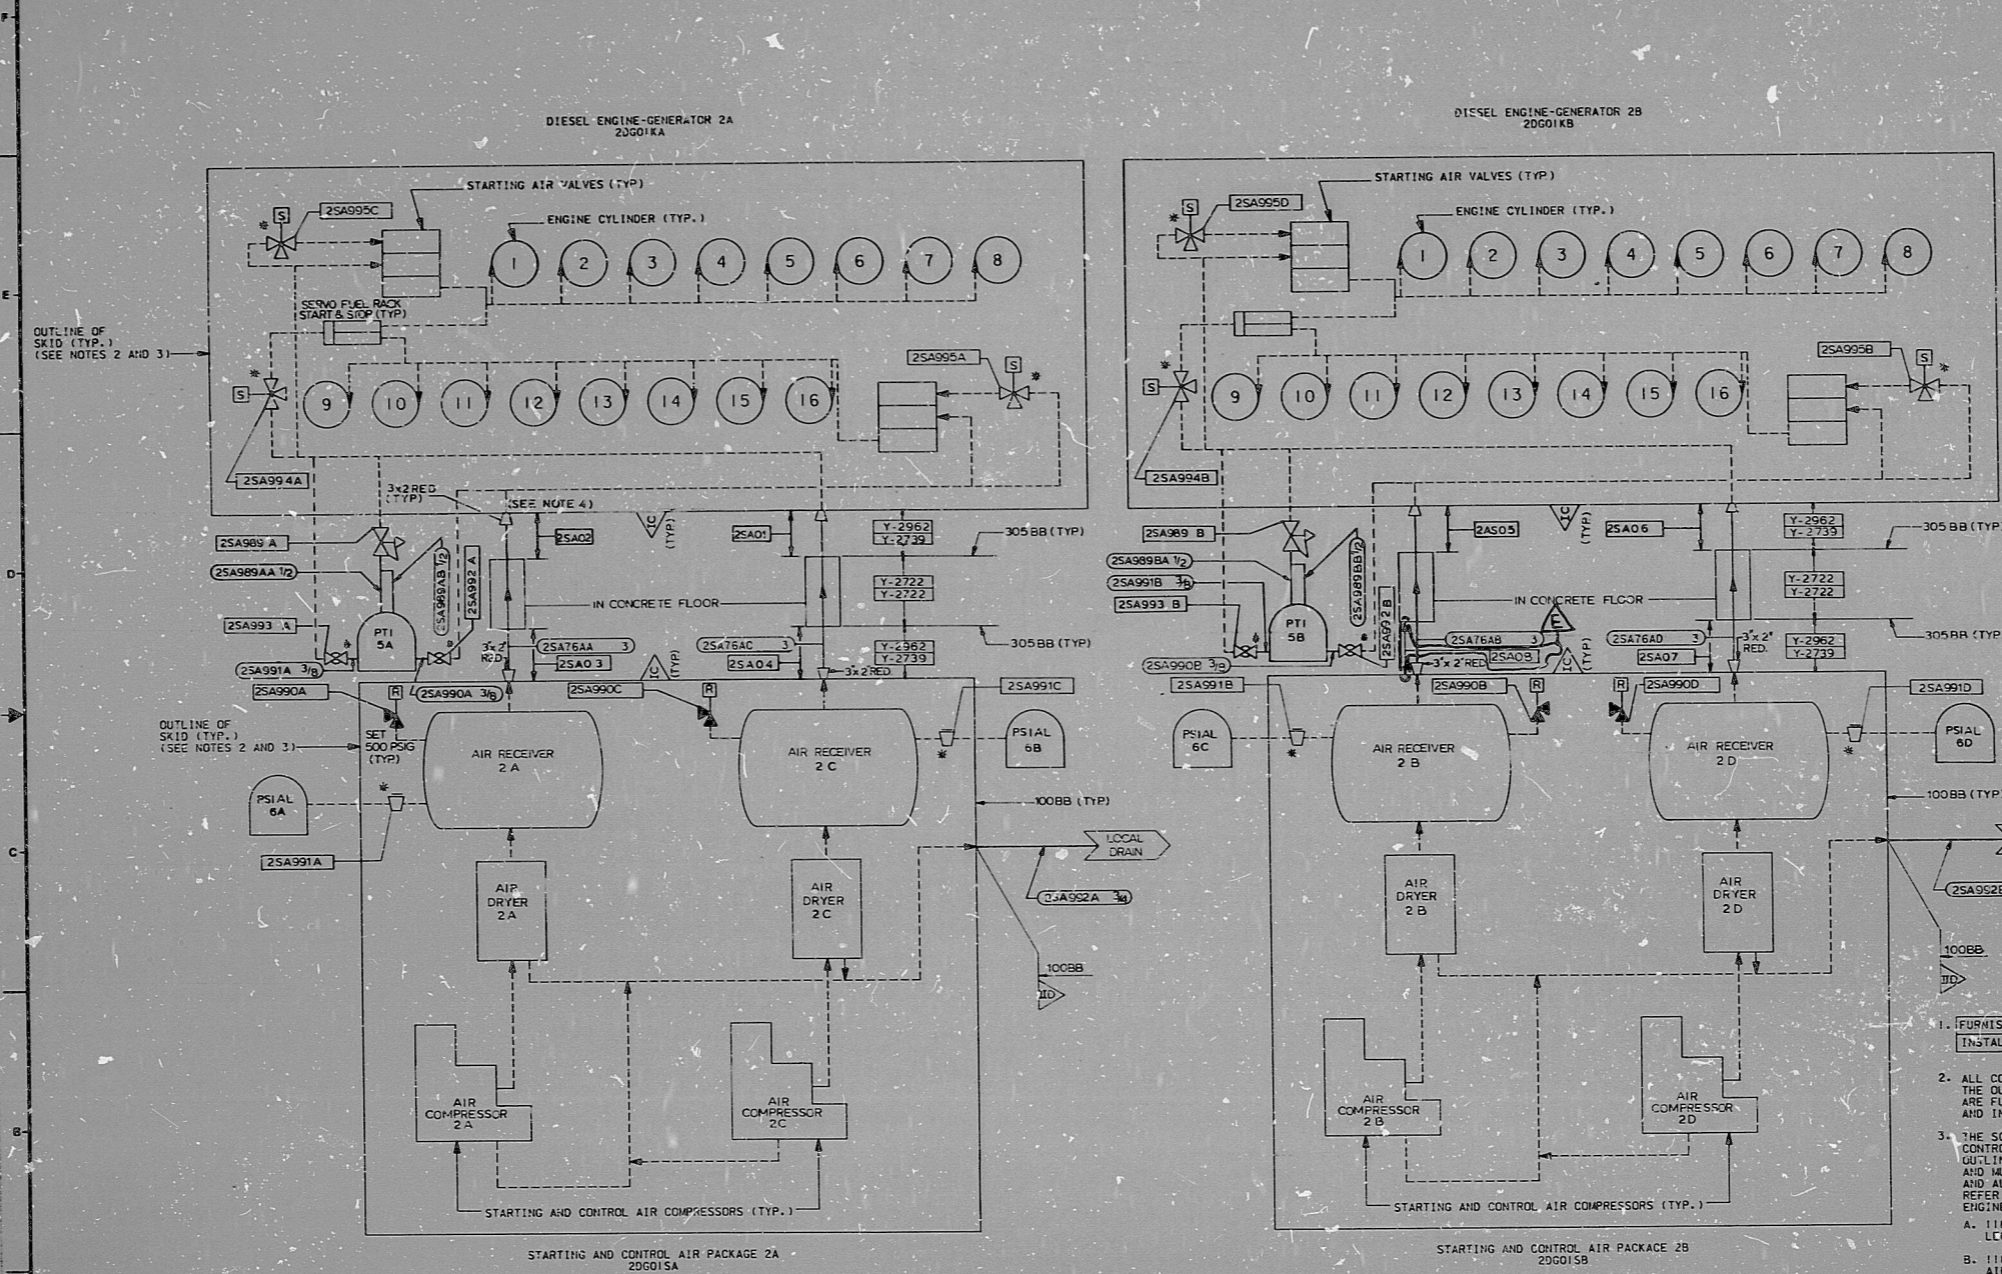

PRC
APERTURE
CARD

1. FURNISH DENOTES SPECIFICATION THAT IS RESPONSIBLE FOR THE INDICATED SCOPE OF WORK.
2. ALL COMPONENTS SHOWN WITHIN THE OUTLINE OF THE SKID ARE FURNISHED BY Y-2742, DRWG 11870589 AND INSTALLED BY Y-2773.
3. THE SCHEMATIC OF THE STARTING AND CONTROL AIR FLOW THAT IS SHOWN WITHIN THE OUTLINE OF THE SKID IS DIAGRAMMATIC ONLY AND MUST NOT BE INTERPRETED AS COMPLETE AND ALL INCLUSIVE. FOR COMPLETE INFORMATION REFER TO THE FOLLOWING FAIRBANKS MORSE ENGINE DIV., COLT INDUSTRIES, DRAWINGS:
A. 1187322; PIPING SCHEMATICS INDEX, LEGEND, GENERAL NOTES.
B. 1187327; STARTING & CONTROL AIR SYSTEM.
4. SMALLER END OF REDUCER SHALL BE FLANGED IN ACCORDANCE WITH PIPING DESIGN TABLE 1058B.

NUCLEAR SAFETY RELATED
ITEMS ARE SHOWN ON THIS DRAWING
FOR SAFETY CLASSIFICATION SEE SYSTEM
CLASSIFICATION BOUNDARY DEFINITION
ON DWG. M-34, SHT. 1.

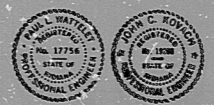

DRAWING RELEASE RECORD				DRAWING RELEASE RECORD			
REV	DATE	PREPARED	REVIEWED	APPROVED	PURPOSE	REV	DATE
A	8-31-79				INITIAL ISSUE FOR FAB PER Y-2742, Y-2962 & CONST PER Y-2739, Y-2773A		
B	11-21-80				GENL REVISION FOR FAB Y-2742, Y-2962 & CONST Y-2739, Y-2773A		
C	12-08-81				GENERAL REVISION PER FORMAL ANALYSIS & PER SA SYSTEM REVIEW FOR FAB & CONST PER SPEC Y-2739 FOR INFO Y-2702		
D	12-23-82				GENERAL REVISION PER FORMAL ANALYSIS FOR FAB AND CONSTRUCTION PER Y-2739 FOR INFO Y-2702		
E	01-14-83				GENERAL REVISION PER FORMAL ANALYSIS FOR FAB AND CONSTRUCTION PER Y-2739 FOR INFO Y-2702		

SCALE: NONE
PROJECT NUMBER: 4923-003
DIAGRAM OF SERVICE AIR (DIESEL GEN. STARTING AIR)
MARBLE HILL GENERATING STA
UNIT 2
PUBLIC SERVICE INDIANA
PLAINFIELD, INDIANA
DRAWING NO. M-54
SHEET 7 OF E

RIDS

8305090320

