


SAFETY-RELATED
 ITEMS AND SHOWN ON THIS DRAWING
 CLASSIFICATION BOUNDARY DEFINITION
 M-34 SHT.1

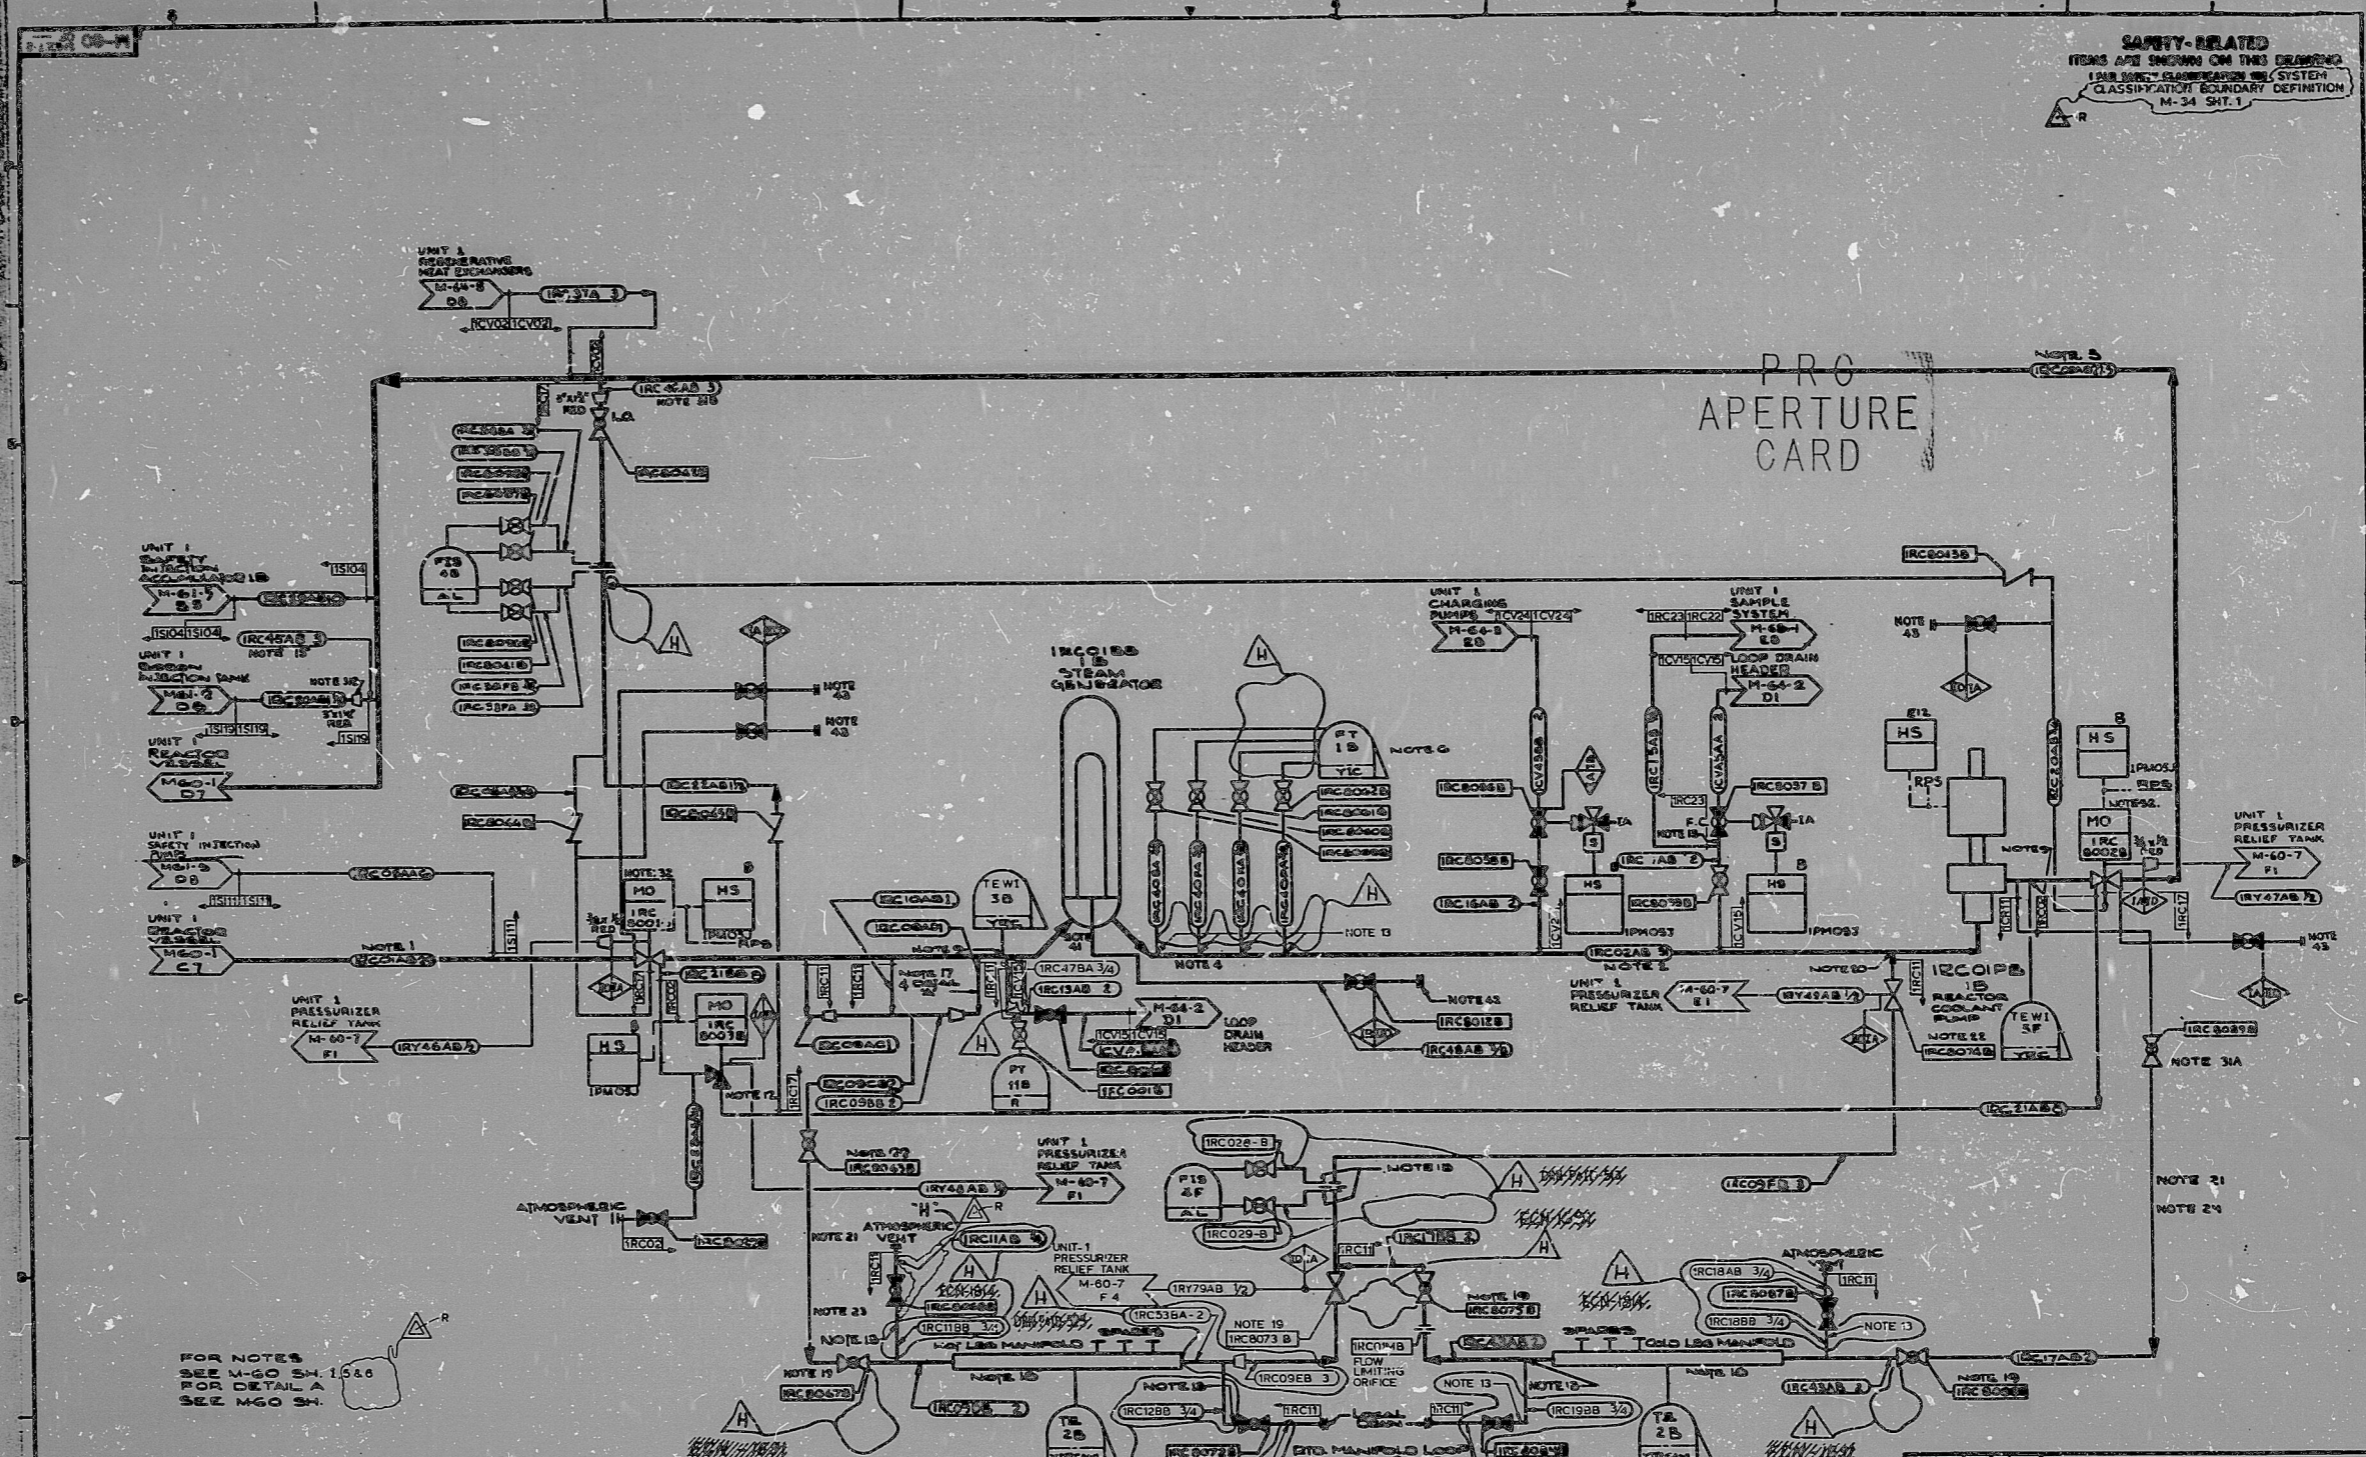

FOR NOTES
 SEE M-60 S4.15&6
 FOR DETAIL A
 SEE M-60 S4.

REV	DATE	DESCRIPTION	APPROVED
1	3-2-80	PREVIOUSLY RELEASED FOR FAB. PER Y-2741 & CONSTR. Y-2741 & CONSTR. Y-2739	
2	3-16-80	INCORP. FROM M-60 S4.15-22-80, & P. 6-23-80--ADD UNCLE FEATURE--FOR FAB. PER SPEC. Y-2741 & CONSTR. PER SPEC. Y-2739	
3	03-17-80	INCORP. FROM M-60 S4.15-22-80, & P. 6-23-80--ADD UNCLE FEATURE--FOR FAB. PER Y-2741 & CONSTR. PER Y-2739.	





DIAGRAM OF REACTOR COOLANT LOOP-2
 MARBLE HILL NUCLEAR
 GENERATING STATION UNIT 1
 PUBLIC SERVICE INDIANA
 PLAINFIELD, INDIANA

M-60
 S4.15-22
 OF 6

SHEET 2 OF 6

RIDS

8305090340

