


SAFETY-RELATED
 ITEMS ARE SHOWN ON THIS DRAWING
 1. FOR SAFETY CLASSIFICATION SEE SYSTEM
 CLASSIFICATION BOUNDARY DEFINITION
 ON M-34 SHEET 1)

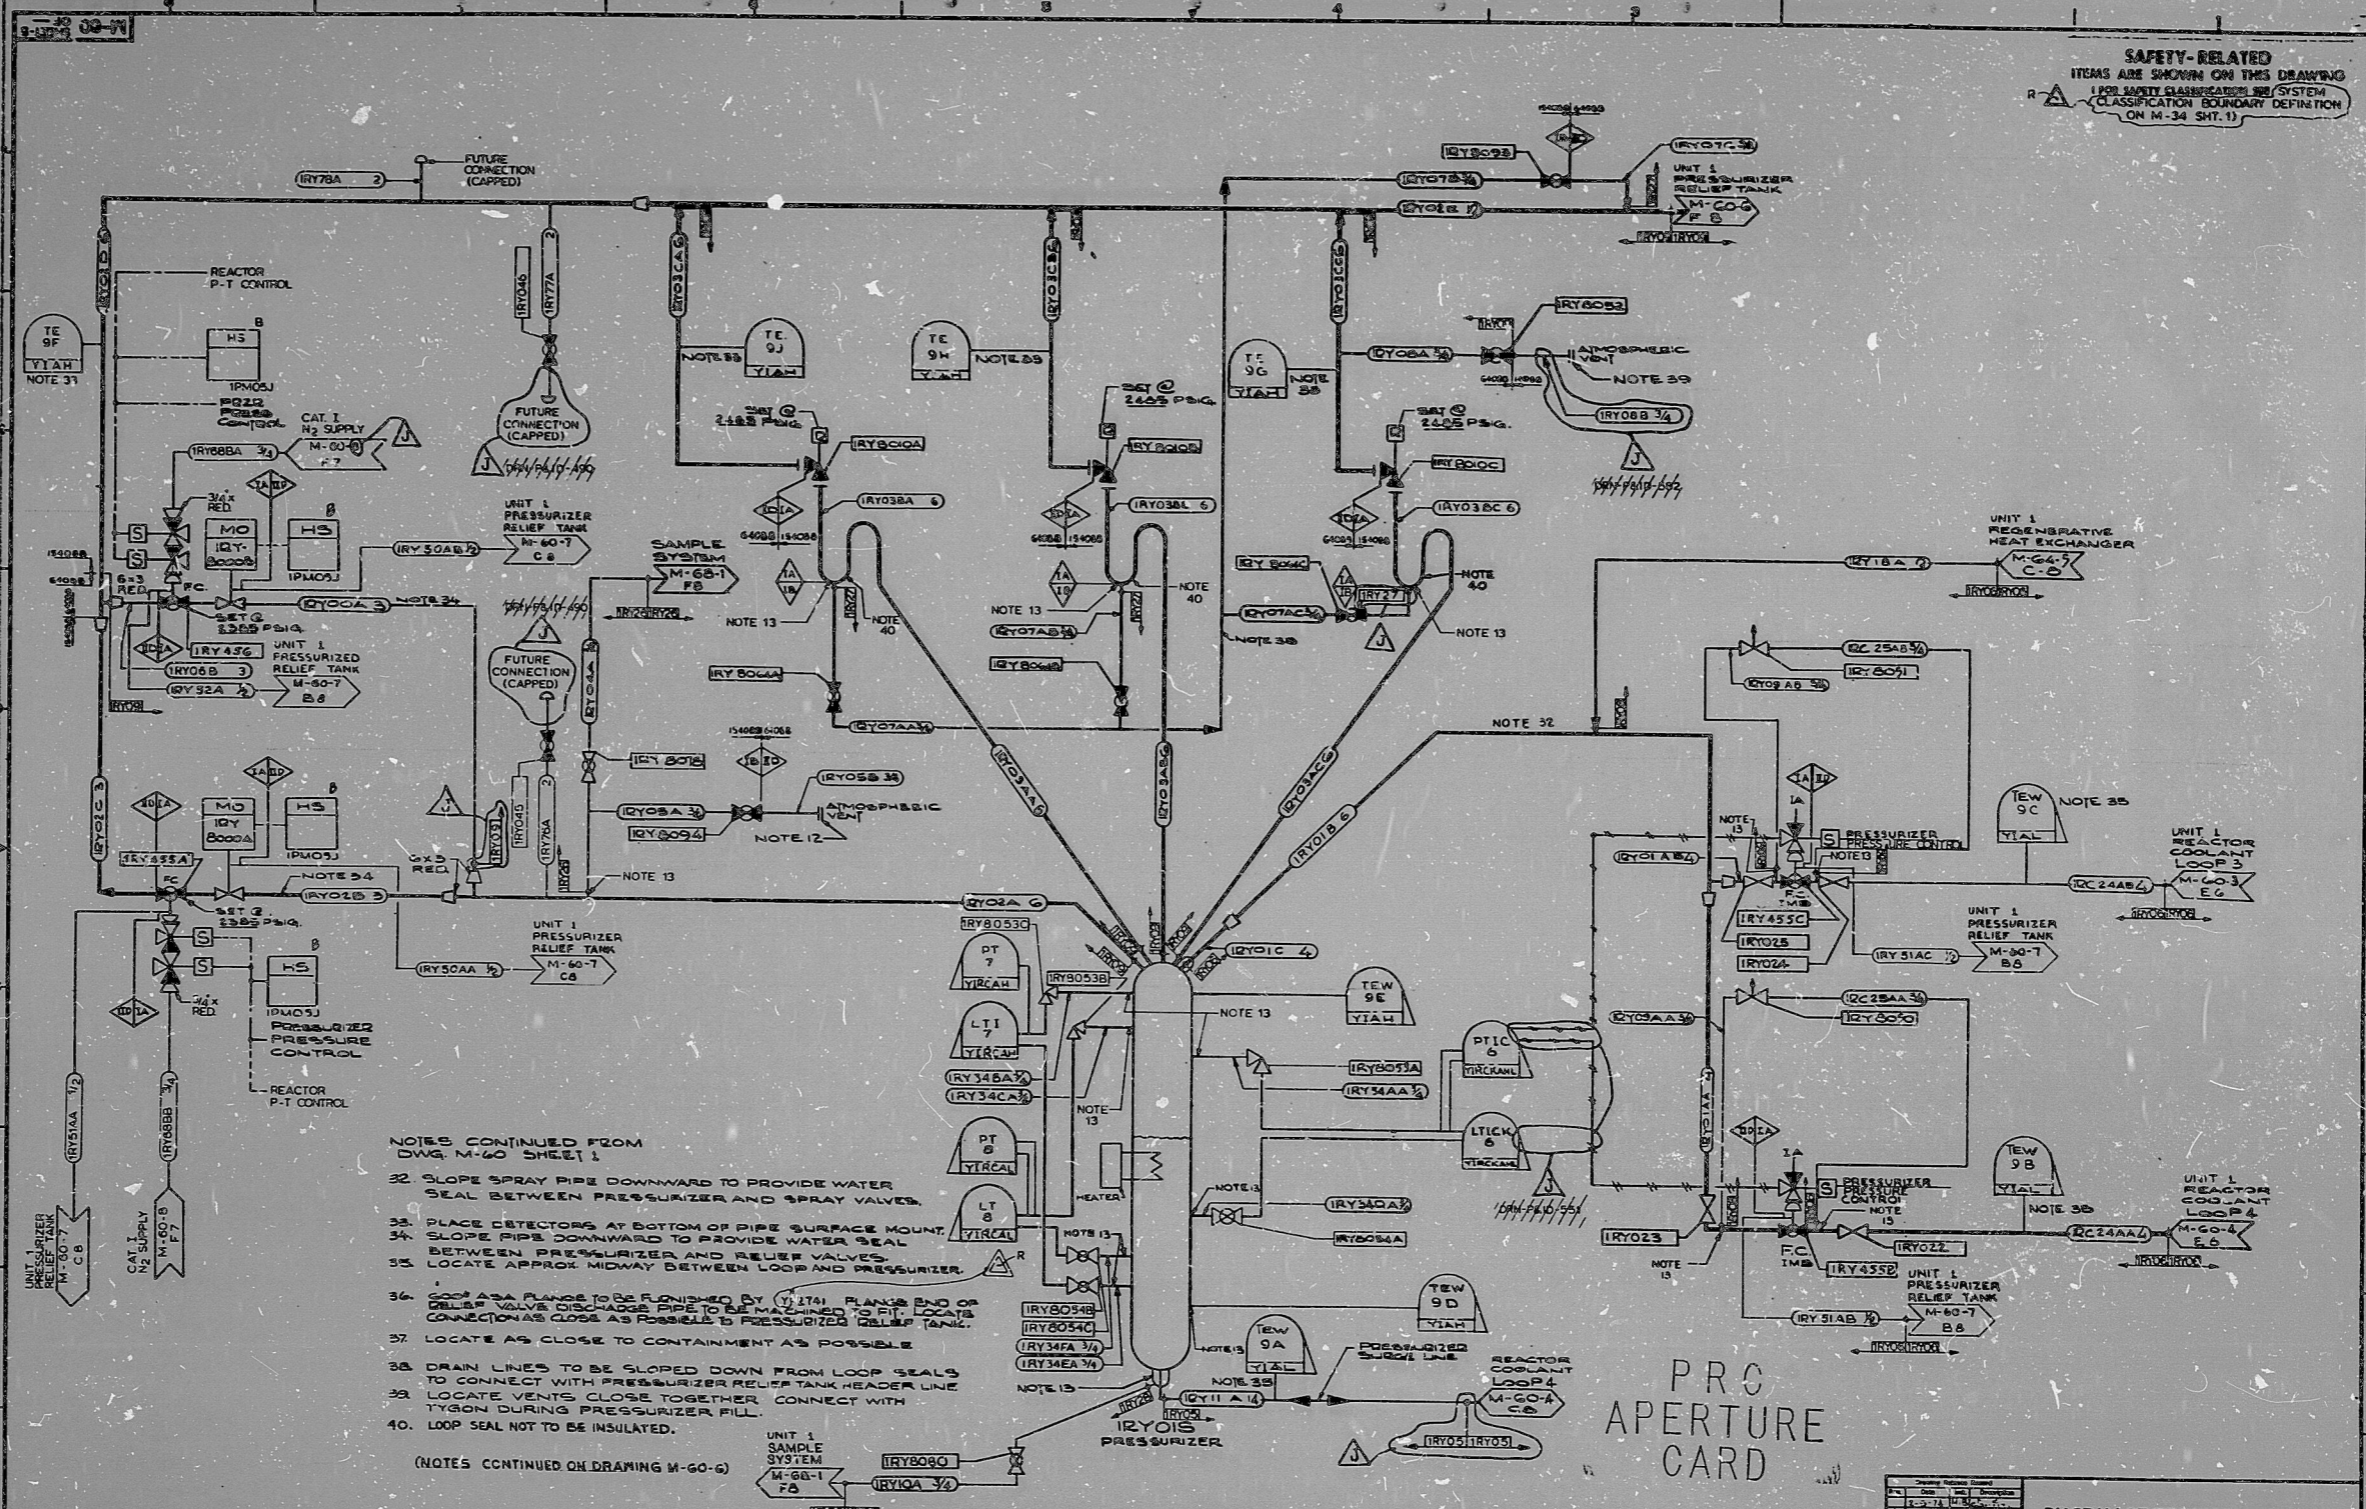

- NOTES CONTINUED FROM
 DWG M-60 SHEET 1
- 32. SLOPE SPRAY PIPE DOWNWARD TO PROVIDE WATER SEAL BETWEEN PRESSURIZER AND SPRAY VALVE.
 - 33. PLACE DETECTORS AT BOTTOM OF PIPE SURFACE MOUNT.
 - 34. SLOPE PIPE DOWNWARD TO PROVIDE WATER SEAL BETWEEN PRESSURIZER AND RELIEF VALVE.
 - 35. LOCATE APPROX MIDWAY BETWEEN LOOP AND PRESSURIZER.
 - 36. GASKET AREA FLANGE TO BE FINISHED BY (VITAI) FLANGE END OF RELIEF VALVE DISCHARGE PIPE TO BE MAINTAINED TO PIT. LOCATE CONNECTION AS CLOSE AS POSSIBLE TO PRESSURIZED RELIEF TANK.
 - 37. LOCATE AS CLOSE TO CONTAINMENT AS POSSIBLE.
 - 38. DRAIN LINES TO BE SLOPED DOWN FROM LOOP SEALS TO CONNECT WITH PRESSURIZER RELIEF TANK HEADER LINE WITH YIGON DURING PRESSURIZER FILL.
 - 39. LOCATE VENTS CLOSE TOGETHER. CONNECT WITH YIGON DURING PRESSURIZER FILL.
 - 40. LOOP SEAL NOT TO BE INSULATED.
- (NOTES CONTINUED ON DRAWING M-60-G)

PRO
 APERTURE
 CARD



DIAGRAM OF REACTOR COOLANT SYSTEM
 MARBLE HILL NUCLEAR GENERATING STATION UNIT 1
 PUBLIC SERVICE INDIANA
 PLAINFIELD, INDIANA



DRAWING NO. M-60
 SHEET 3 OF 3

RIDS

8305090344

