




RIDS

8305090662

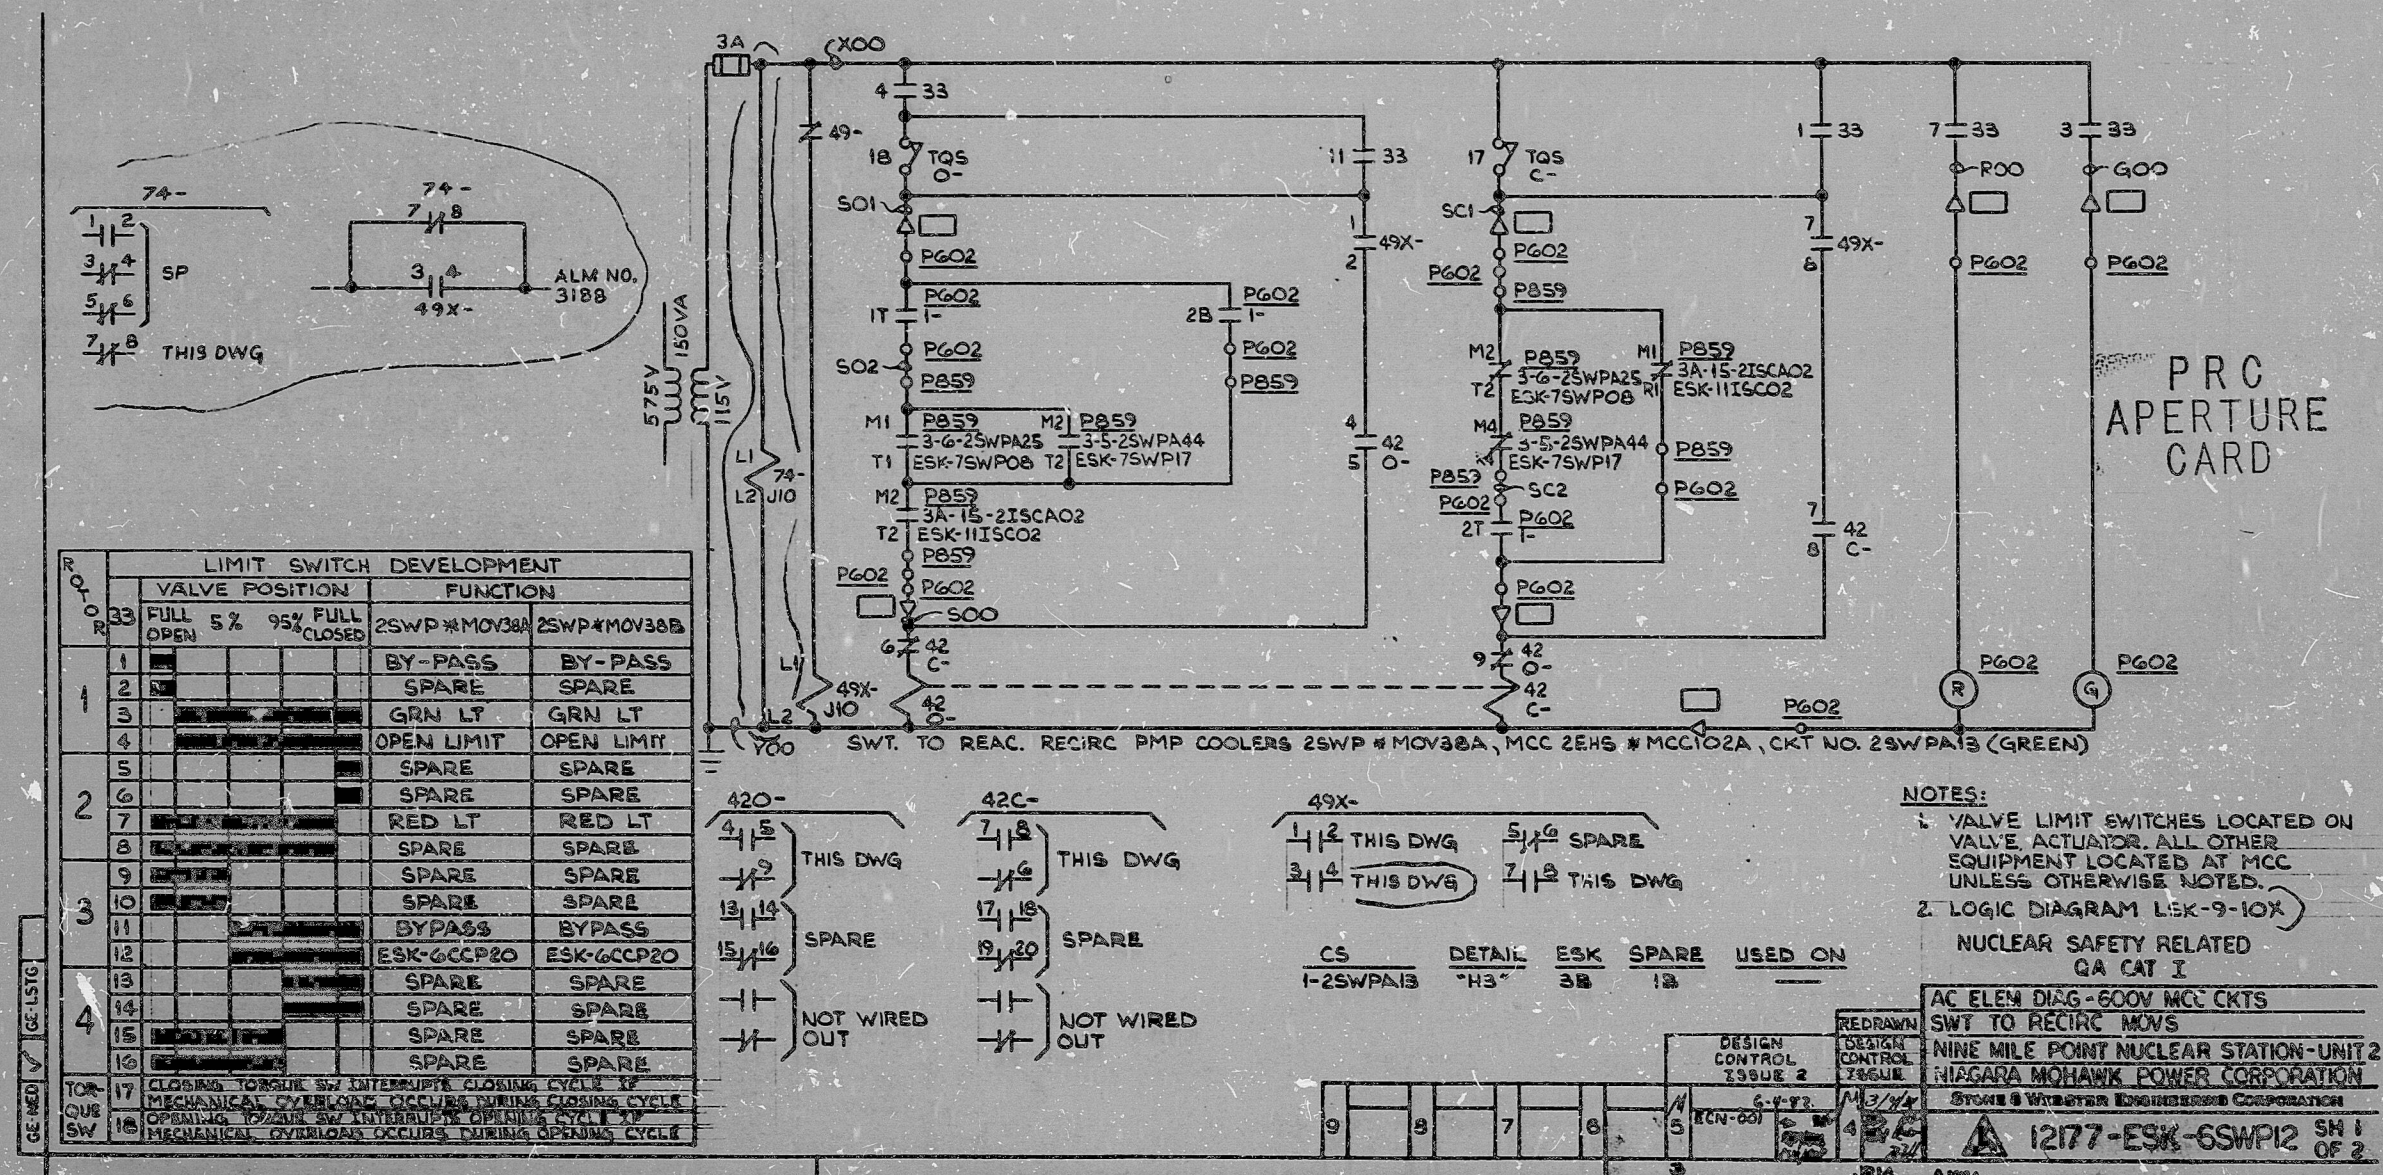