

VALVE BODY TYPES

- GATE VALVE
- GLOBE VALVE
- PLUG VALVE
- FLUID CHECK VALVE
- BALL VALVE
- DIAPHRAGM VALVE
- HERMETICALLY SEALED VALVE
- THREE WAY VALVE
- FOOT VALVE WITH STRAINER
- STOP CHECK VALVE (NORMALLY CLOSED)
- STOP CHECK VALVE (NORMALLY OPEN)
- SAFETY & RELIEF VALVE
- QUICK DISCONNECT COUPLING
- FLOAT CHECK VALVE
- AIR RELEASE VALVE
- VACUUM BREAKER
- CHECK VALVE
- BUTTERFLY VALVE (FLANGED OR WAVER TYPE - NORMALLY CLOSED)
- BUTTERFLY VALVE (FLANGED OR WAVER TYPE - NORMALLY OPEN)
- DOUBLE DISC GATE VALVE
- VARIABLE CAPILLARY PRESSURE ELEMENT
- FOOT RETURN VALVE
- BLOW OFF VALVE
- Y PAY TERM VALVE
- FIRE PROTECTION POST INDICATOR VALVE

VALVE OPERATOR TYPES

- DIAPHRAGM
- ELECTRIC MOTOR
- SOLENOID
- PISTON
- MANUAL GEAR OPERATED
- EXTENSION STEM OPERATOR
- QUICK OPERATING
- SELF-CONTAINED PRESSURE REGULATOR
- THROTTLING
- PROCESS ACTUATED AIR DIAPHRAGM OPERATOR WITH VALVE POSITIONER
- INSTRUMENT ACTUATED AIR DIAPHRAGM OPERATOR WITH VALVE POSITIONER

VALVE ACCESSORIES, DEFINITIONS AND ABBREVIATIONS

- STEEL LEAKOFF
- BELLOWS SEAL
- CAPPED STEM
- FLANGES AT VALVES ARE NORMALLY CLOSED VALVE POSITION SHOWN IN THIS DRAWING POWER OPERATION
- EXTENSION STEM THROUGH SHIELD WALL OR FLOOR
- EXTENSION STEM NO WALL OR FLOOR PENETRATION
- F.C. FAIL CLOSED
- F.O. FAIL OPEN
- F.A.I. FAIL A F I S
- L.C. LOCKED CLOSED
- L.O. LOCKED OPEN
- L.I.P. LOCKED IN POSITION
- N.C. NORMALLY CLOSED
- N.O. NORMALLY OPEN
- T.C. TEST CONNECTION
- V. VENT
- D. DRAIN

PIPE & EQUIPMENT ACCESSORIES

- VESSEL MANWAY
- RUPTURE DISC
- FLOW RESTRICTION ORIFICE
- SIGHT FLOW INDICATION
- THERMAL SLEEVE
- BLIND FLANGE
- CAPPED STUB
- REDUCER
- EXPANSION JOINT
- SPRAY NOZZLES
- SPARGER (INSIDE VESSEL)
- EDUCTOR OR EJECTOR
- BLENDER
- LOCK SEAL TRAP
- FLEXIBLE CONN.
- HOSE CONNECTION
- FLOOR DRAIN
- BREAKDOWN ORIFICE
- TEMPORARY STRAINER
- SPECTACLE FLANGE
- WILD CAP
- THREAD OR SOCKET WELDED C/P
- OPEN FUNNEL DRAIN SYSTEM
- PENETRATION
- FLOW NOZZLE
- ANNULAR FLOW MEASUREMENT
- PRESSURE CLASS TRANSITION

EQUIPMENT

- VERT. STACK
- VERTICAL U-TUBE STEAM GENERATOR
- STRAIGHT TUBE HEAT EXCHANGER
- SHAFT SEAL PUMP
- POSITIVE DISPLACEMENT PUMP
- CENTRIFUGAL PUMP
- SMALL CANNED MOTOR PUMP
- FAN, SLOWER OR COMPRESSOR
- WATER METER
- MIXER
- ACCUMULATOR
- IMERSION HEATER (STEAM OR ELECTRICAL)
- FIRE HYDRANT
- DASKE'S STRAINER
- SEPARATOR
- DOUBLE BASKET STRAINER
- STEAM TRAP
- JOHNSON SCREEN
- Y-STRAINER
- FILTER
- FORWARD-REVERSE PITOT
- COVER
- VENT CONDENSER
- FI FLOW INDICATOR
- VERTICAL CANNED PUMP
- TEMPORARY CONE TYPE STRAINER
- ORIFICE TYPE FLOW MEASUREMENT
- U-TUBE HEAT EXCHANGER
- COIL TYPE HEAT EXCHANGER

INSTRUMENTATION & CONTROL SYMBOLS

- LOCAL MOUNTED INSTRUMENT WITH SINGLE SERVICE & FUNCTION
- BOARD REAR MOUNTED INSTRUMENT
- BOARD FRONT MOUNTED INSTRUMENT
- CONNECTIVITY
- TEMPERATURE
- PRESSURE
- LEVEL
- ANALOG
- ANALYSIS
- TRIP
- ALARM
- VALVE DAMPER OR LOUVER
- SWITCH
- TRANSMITTER
- CLASS
- POWER SUPPLY
- INDICATING
- RECORD OR PRINT
- CONTROL

TYPICAL INSTRUMENT CONNECTIONS

LEVEL

VALVE LOCATION NUMBER IDENTIFICATION SYSTEM

ITEM

LINE DESIGNATIONS

UNIT No.

REFERENCE BLOCK

LINE CODING

INSTRUMENT LINE

CLASSIFICATIONS

TYPICAL REPRESENTATION OF UNIT & EQUIPMENT

TYPICAL REPRESENTATION OF VALVED PACKAGE

LINE SYMBOLS

- MAIN PROCESS FLOW LINES (OUT OF SYSTEM OR UNIT TWO DASHED)
- SECONDARY PROCESS FLOW LINES (OUT OF SYSTEM OR UNIT TWO DASHED)
- PNEUMATIC INSTRUMENT LINES
- INSTRUMENT AIR SUPPLY FIXED PRESSURE
- AREA BOUNDARIES
- ELECTRICAL SIGNALS
- INSTRUMENT CAPILLARY TUBING
- ELECTRICAL HEAT TRACING
- TRANSITION PIECE (STAINLESS TO CARBON STEEL)
- TRANSITION PIECE (TYPICAL FOR FLANGED CONN.)
- SHIELD WALL PENETRATION
- FLANGE CONNECTION (PIPING OR EQUIPMENT)
- TEST CONNECTION LOCATION
- TEST VENT LOCATION

GENERAL NOTES

1. THESE NOTES APPLY TO ALL DRAWINGS UNLESS OTHERWISE SPECIFIED IN THE APPLICABLE SPECIFICATIONS.
9. IN SAFETY CLASS 1 PIPING A FLOW RESTRICTION IS REQUIRED IN 3/4" PIPING TO ALLOW TRAFFIC FROM SAFETY CLASS 1 TO SAFETY CLASS 2.
10. TYPICAL FLOW RESTRICTION SHALL BE:

REFERENCES

1. EQUIPMENT LIST
2. LINE LIST
3. INSTRUMENT LIST
4. VALVE LIST
5. SPECIFICATION LIST
6. INSTRUMENT IDENTIFICATION SHEETS
7. INSTRUMENTATION AND CONTROL DRAWING

LEGEND

GENERAL









MECHANICAL SYMBOLS & NOTES

FOR INFORMATION ONLY

APERTURE CARD


TEXAS UTILITIES SERVICES INC.
DALLAS POWER & LIGHT COMPANY
TEXAS ELECTRIC SERVICE COMPANY
TEXAS POWER & LIGHT COMPANY

MECHANICAL SYMBOLS & NOTES

SCALE: AS SHOWN

DATE: 10/1/68

PROJECT NO: 2323-MI-0200

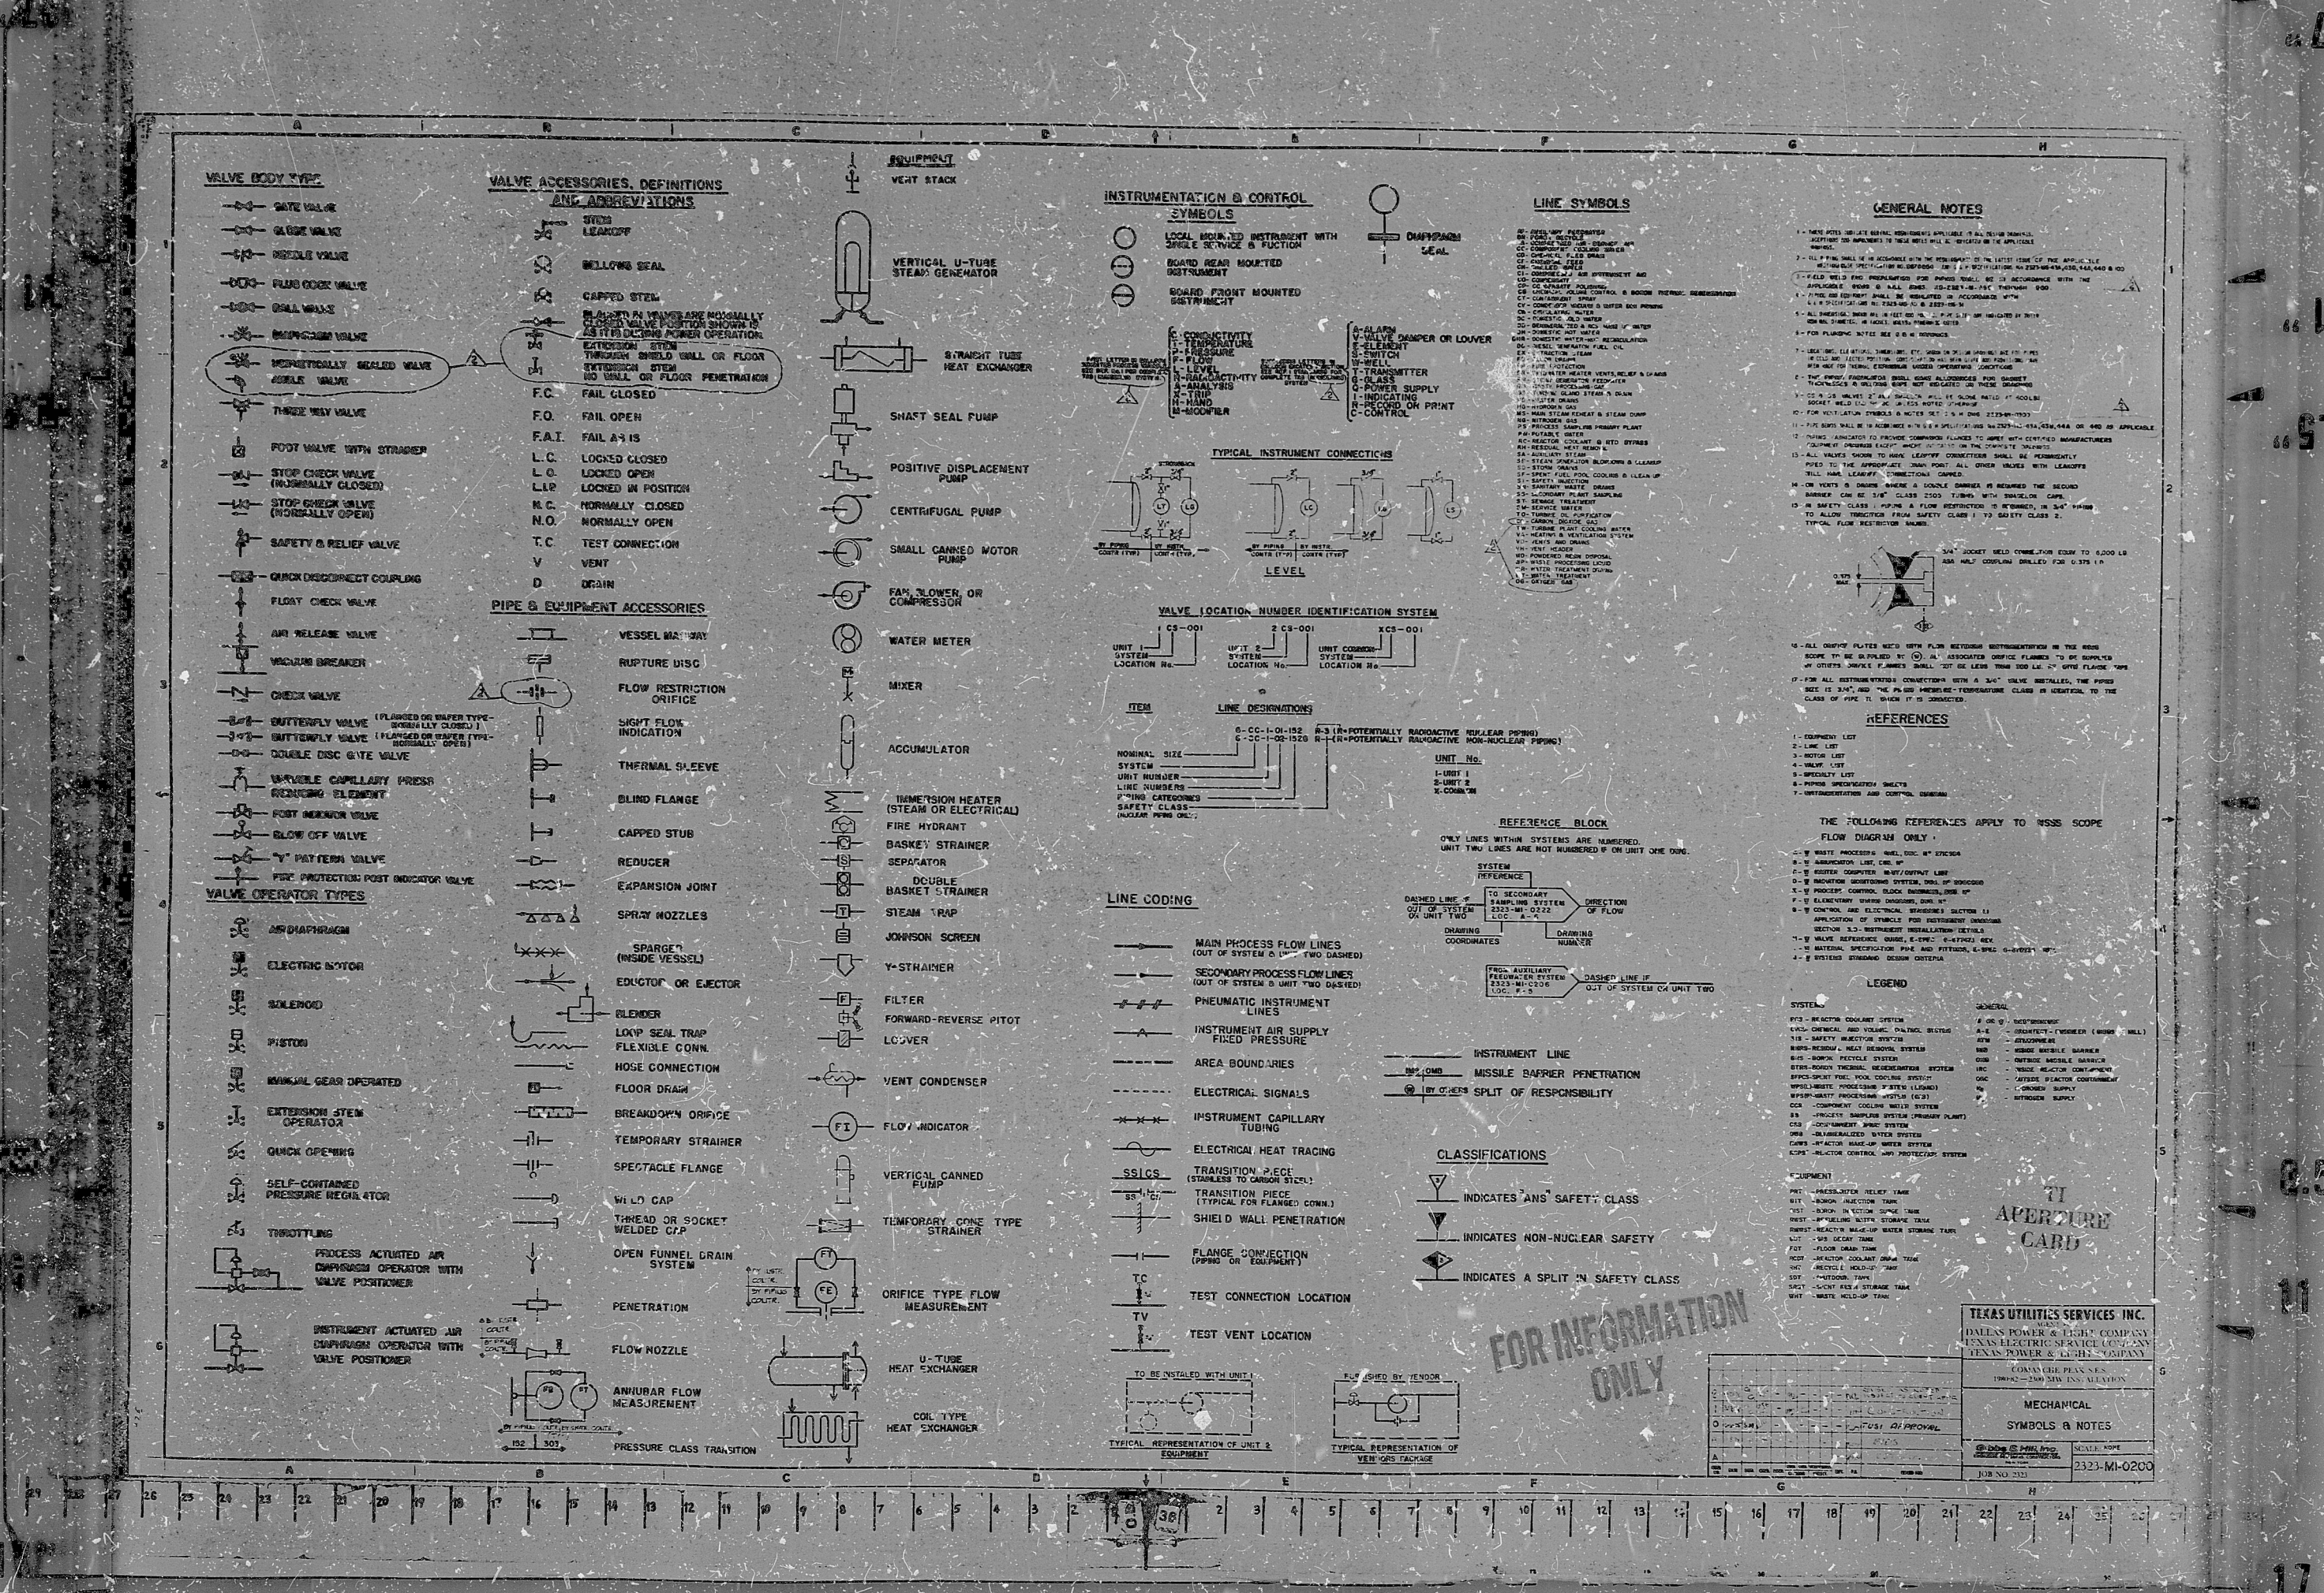

PDR RIDS

8406270304

