


POOR ORIGINAL

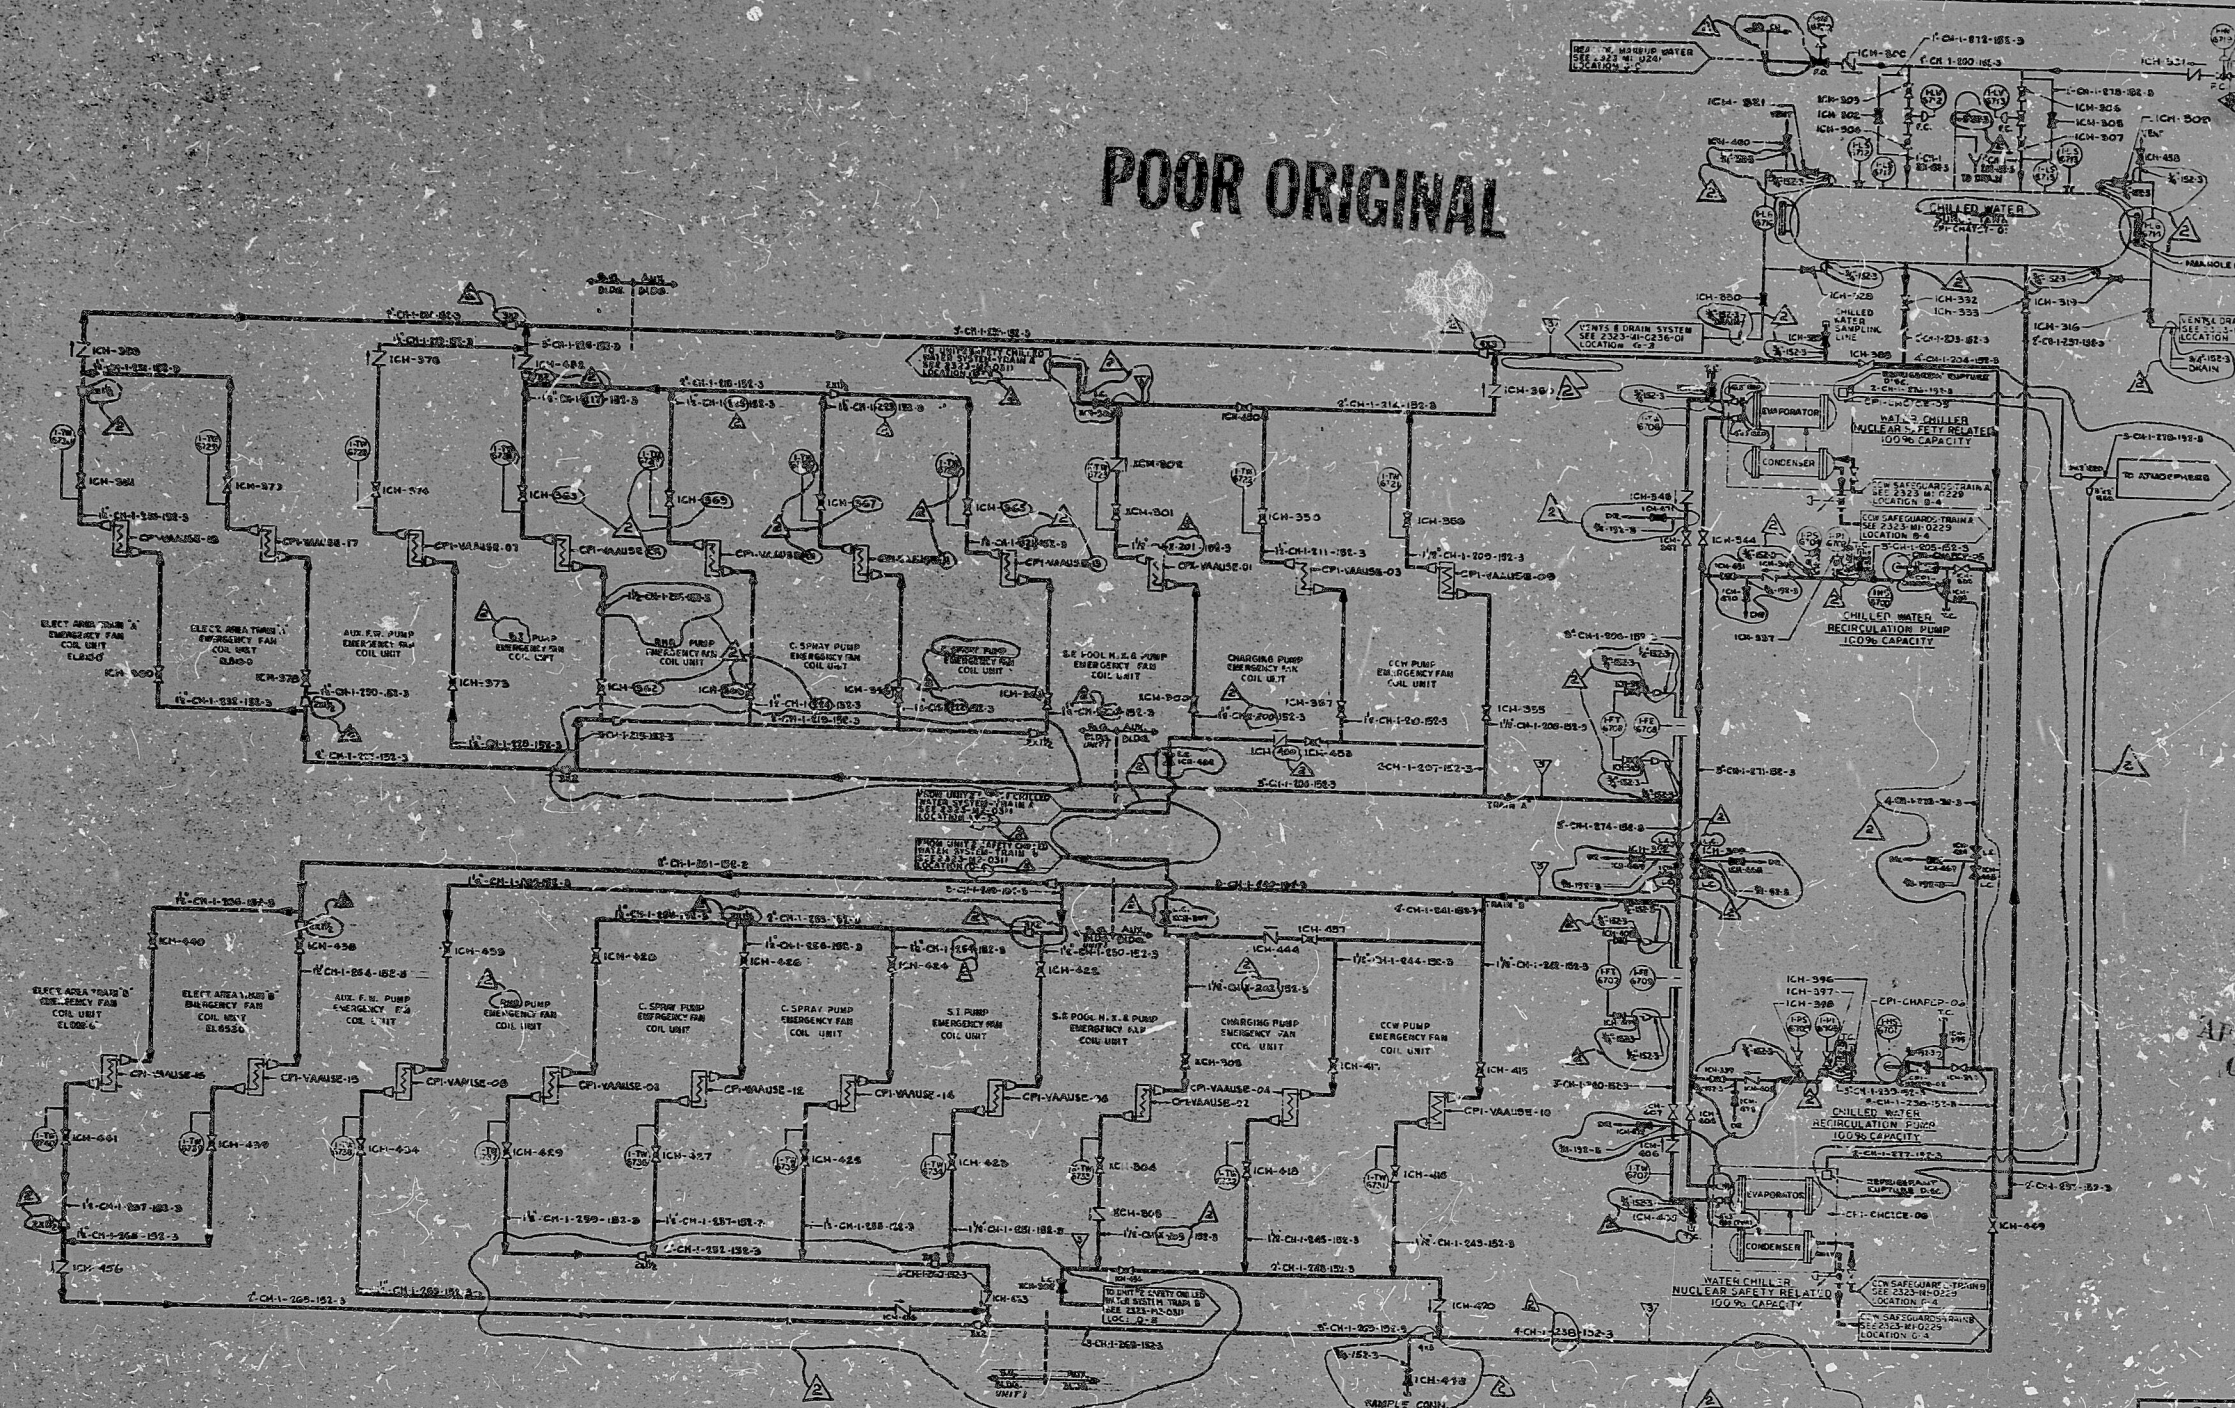

FOR INFORMATION ONLY

NOTES
1. FOR MECHANICAL SYMBOLS AND RATES SEE DRAWING 2323-MI-0200.
2. THE PIPE CATEGORY FOR ALL 80°F VALVE LINES, TEST CONNECTIONS, DRAINS, AND VENTS WILL BE THE NAME AS SHOWN ON THE MAIN PROTECT LINE UNLESS OTHERWISE NOTED.

CLASS I

TEXAS UTILITIES SERVICES INC.
DALLAS POWER & LIGHT COMPANY
TEXAS ELECTRIC SERVICE COMPANY
TEXAS POWER & LIGHT COMPANY

FLOW DIAGRAM - VENTILATION
SAFETY CHILLED WATER SYSTEM

2323-MI-0311
JOB NO. 3331


17
11
9.8
8.5
11
17

PDR RIDS

8406270325

