


40
2-1328 00-11

NUCLEAR SAFETY RELATED
ITEMS ARE SHOWN ON THIS DRAWING
LPSR SAFETY CLASSIFICATION SEE SYSTEM
CLASSIFICATION BOUNDARY DEFINITION ON
DWG. M-34, SHEET 1

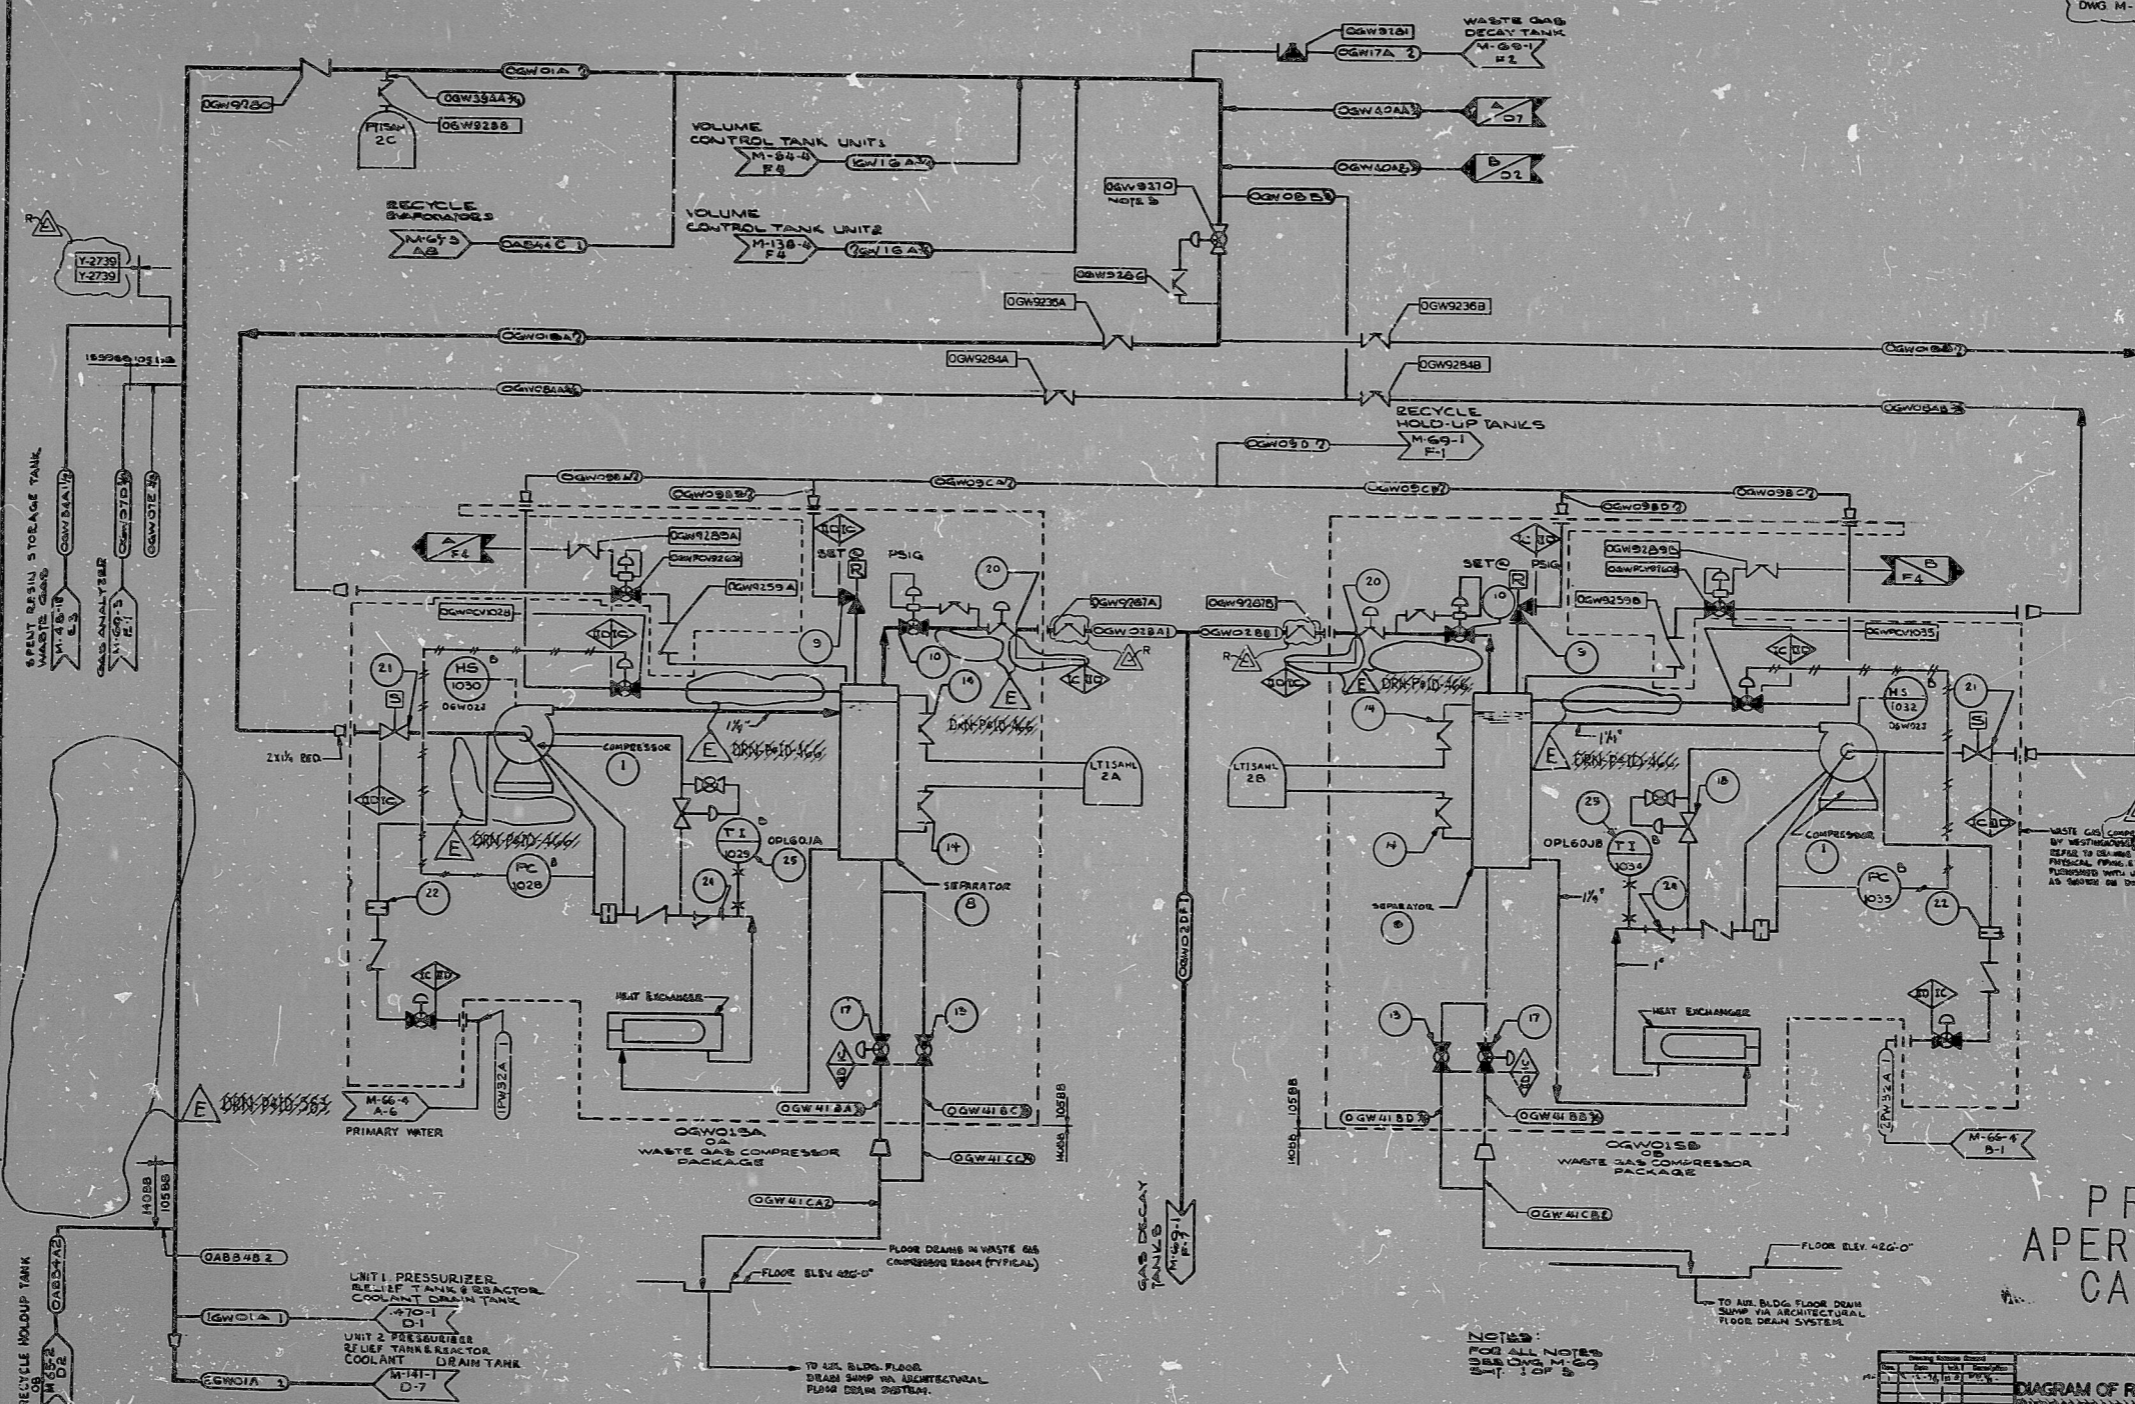


NOTES:
FOR ALL NOTES
SEE DWG. M-34
SHEET 1 OF 3

PRC
APERTURE
CARD

DRAWING RELEASE RECORD				DRAWING RELEASE RECORD			
REV	DATE	BY	REASON	REV	DATE	BY	REASON

DIAGRAM OF RADIOACTIVE WASTE GAS
MARBLE HILL NUCLEAR
GENERATING STATION UNITS 1 & 2
PUBLIC SERVICE INDIANA
PLAINFIELD, INDIANA

SCALE: NONE
PROJECT: 4800-00
DRAWING NO.: 3223-01
SHEET 2 OF 3

SARGENT & LUNDY
ENGINEERS
CHICAGO

DRAWING NO. REV. D
M-69
SHEET 2 OF 3

8305090672

RIDS

