


POOR ORIGINAL

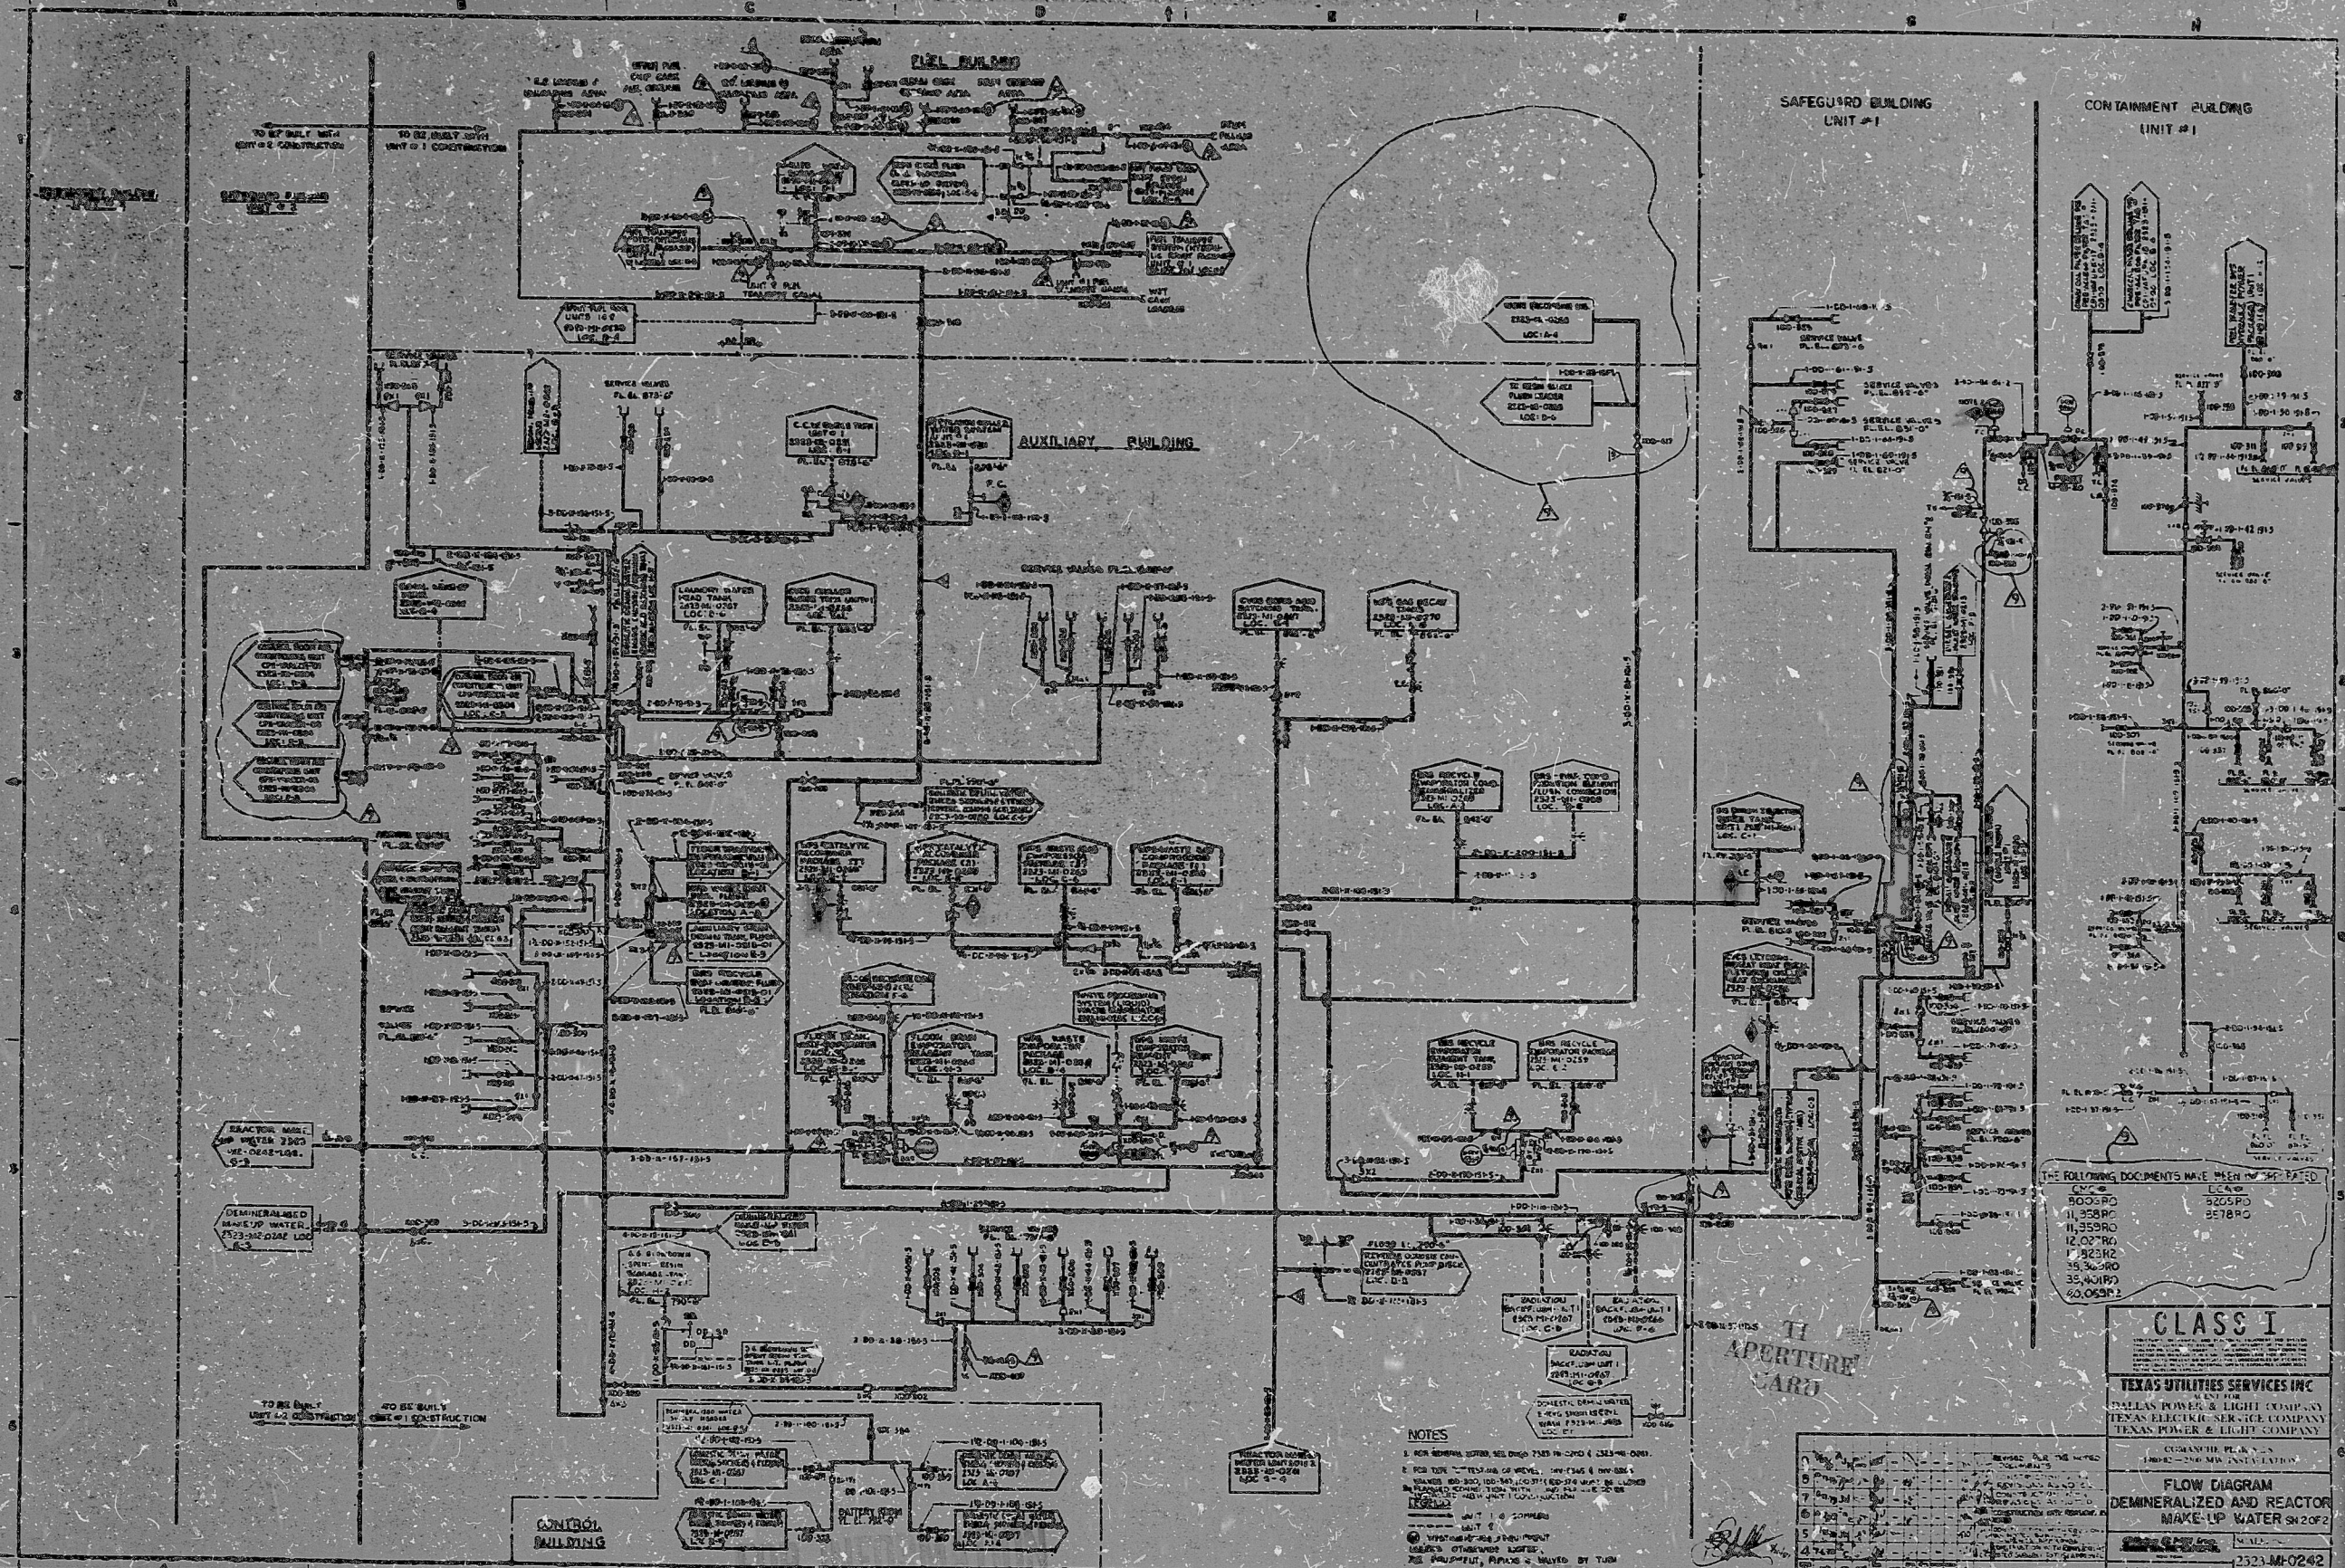

THE FOLLOWING DOCUMENTS HAVE BEEN RE-REFERENCED:


CLASS I

TEXAS UTILITIES SERVICES INC
 DALLAS POWER & LIGHT COMPANY
 TEXAS ELECTRIC SERVICE COMPANY
 TEXAS POWER & LIGHT COMPANY

FLOW DIAGRAM
 DEMINERALIZED AND REACTOR
 MAKE-UP WATER SH20F2


OB-36

PDR RIDS

8406270865

