


POOR ORIGINAL

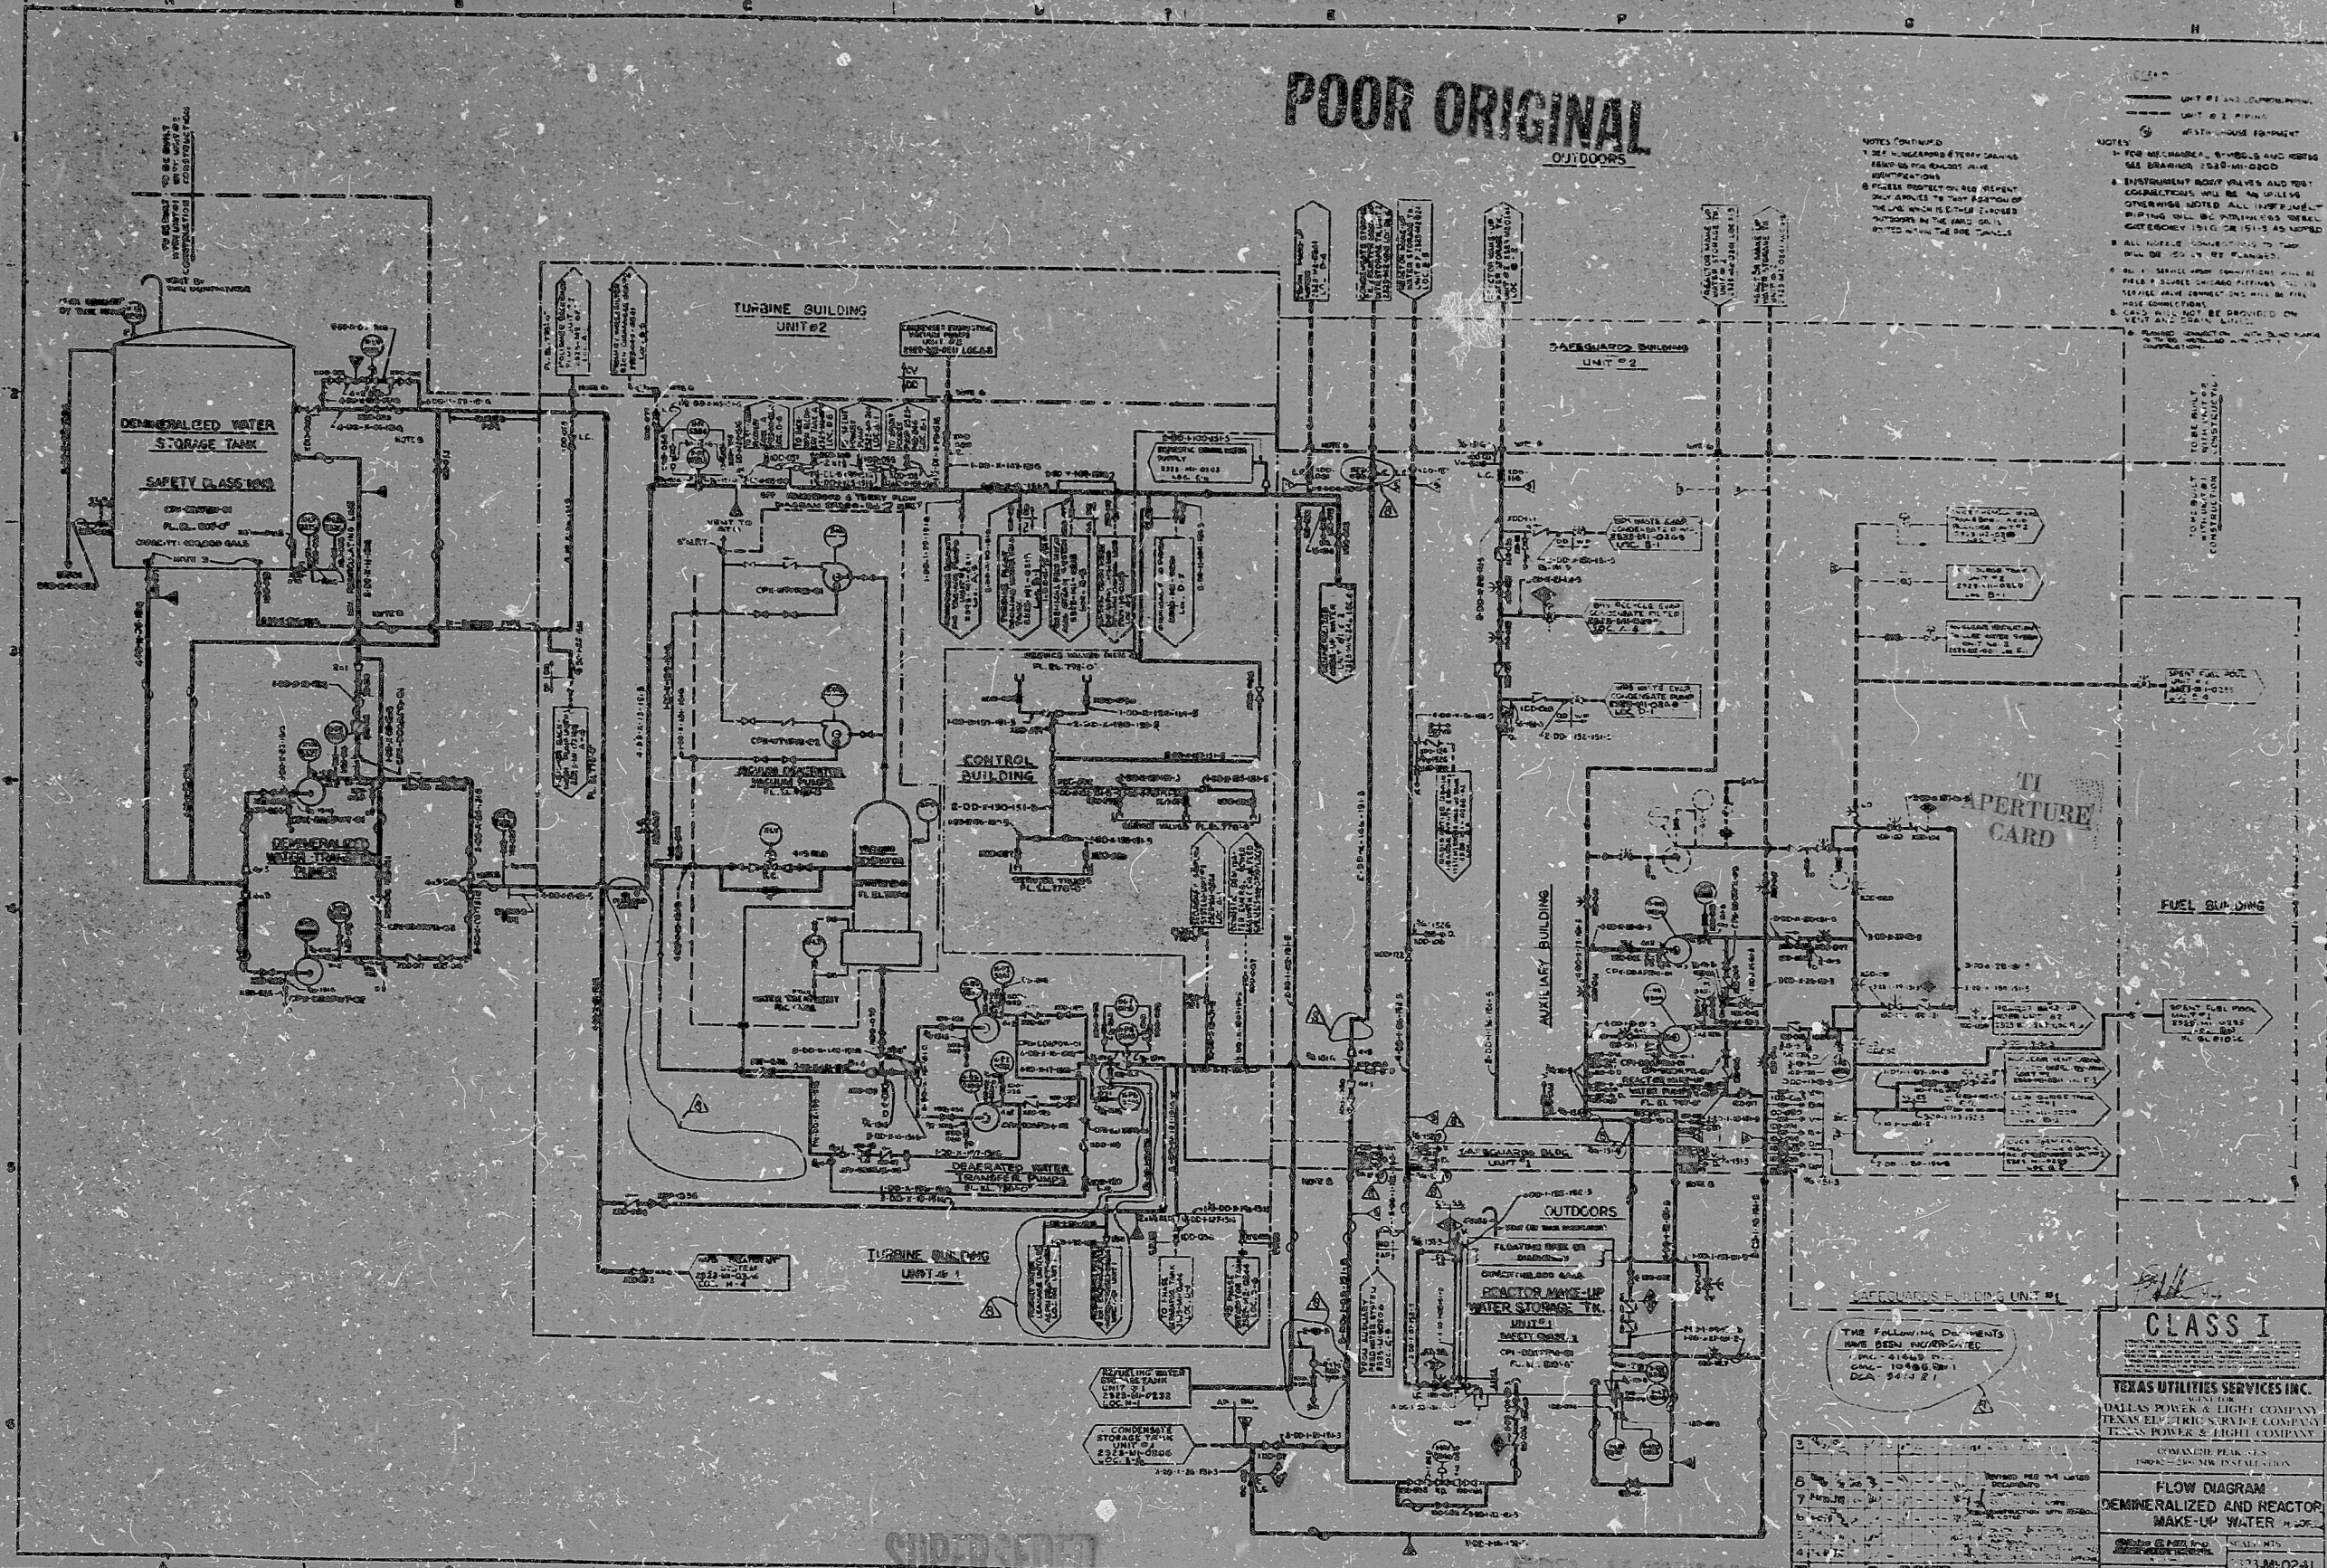



CLASS I

TEXAS UTILITIES SERVICES INC.
 DALLAS POWER & LIGHT COMPANY
 TEXAS ELECTRIC SERVICE COMPANY
 TEXAS POWER & LIGHT COMPANY

FLOW DIAGRAM
 DEMINERALIZED AND REACTOR
 MAKE-UP WATER

 DRAWN BY: [Signature]
 CHECKED BY: [Signature]

OB-36

8.5
 11
 17

PDR RIDS

8406270370

