


POOR ORIGINAL

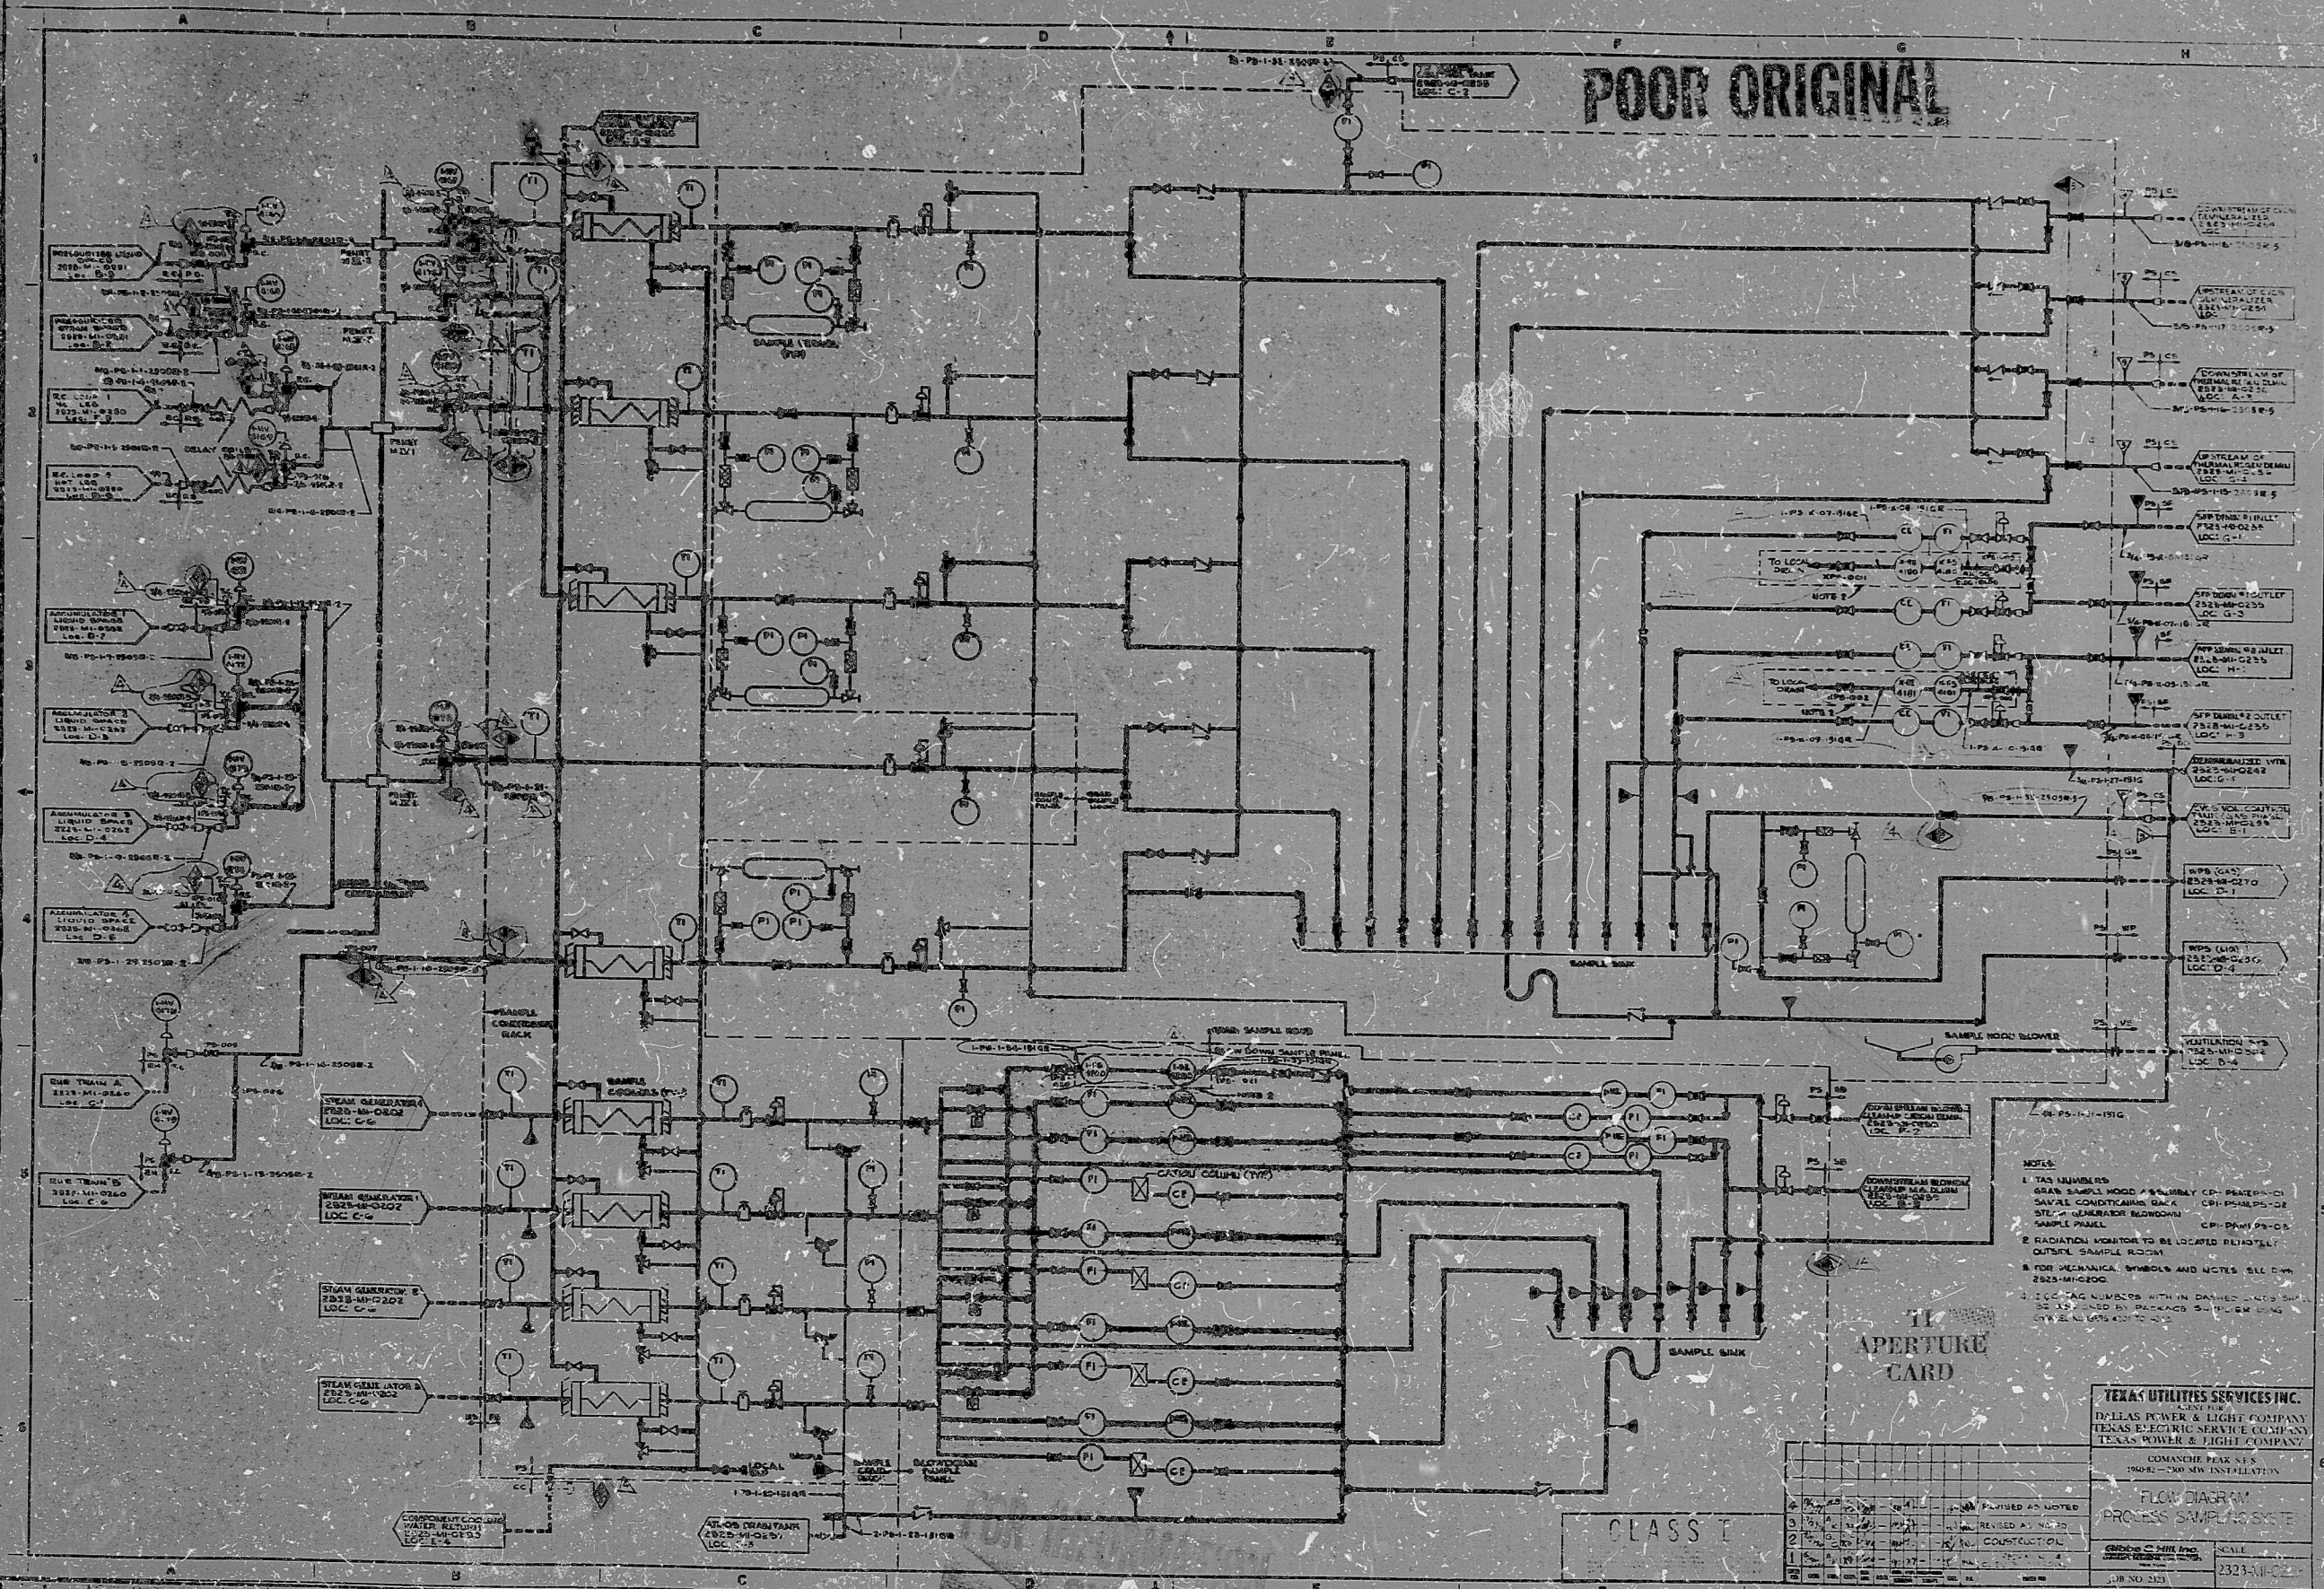

- NOTES:
- 1 TAG NUMBERS
  - 7 FOR MECHANICAL SYMBOLS AND NOTES SEE DWG 2825-MH-0200

APERTURE CARD

TEXAS UTILITIES SERVICES INC.  
 DALLAS POWER & LIGHT COMPANY  
 TEXAS ELECTRIC SERVICE COMPANY  
 TEXAS POWER & LIGHT COMPANY

COMANCHE PEAK #1  

FLOW DIAGRAM  
 PROCESS SAMPLE SYSTEM

CLASS T

|         |                 |                  |
|---------|-----------------|------------------|
| DATE    | BY              | REVISION         |

SCALE  
 2323-MH-0200



PDR RIDS

8406280002

