


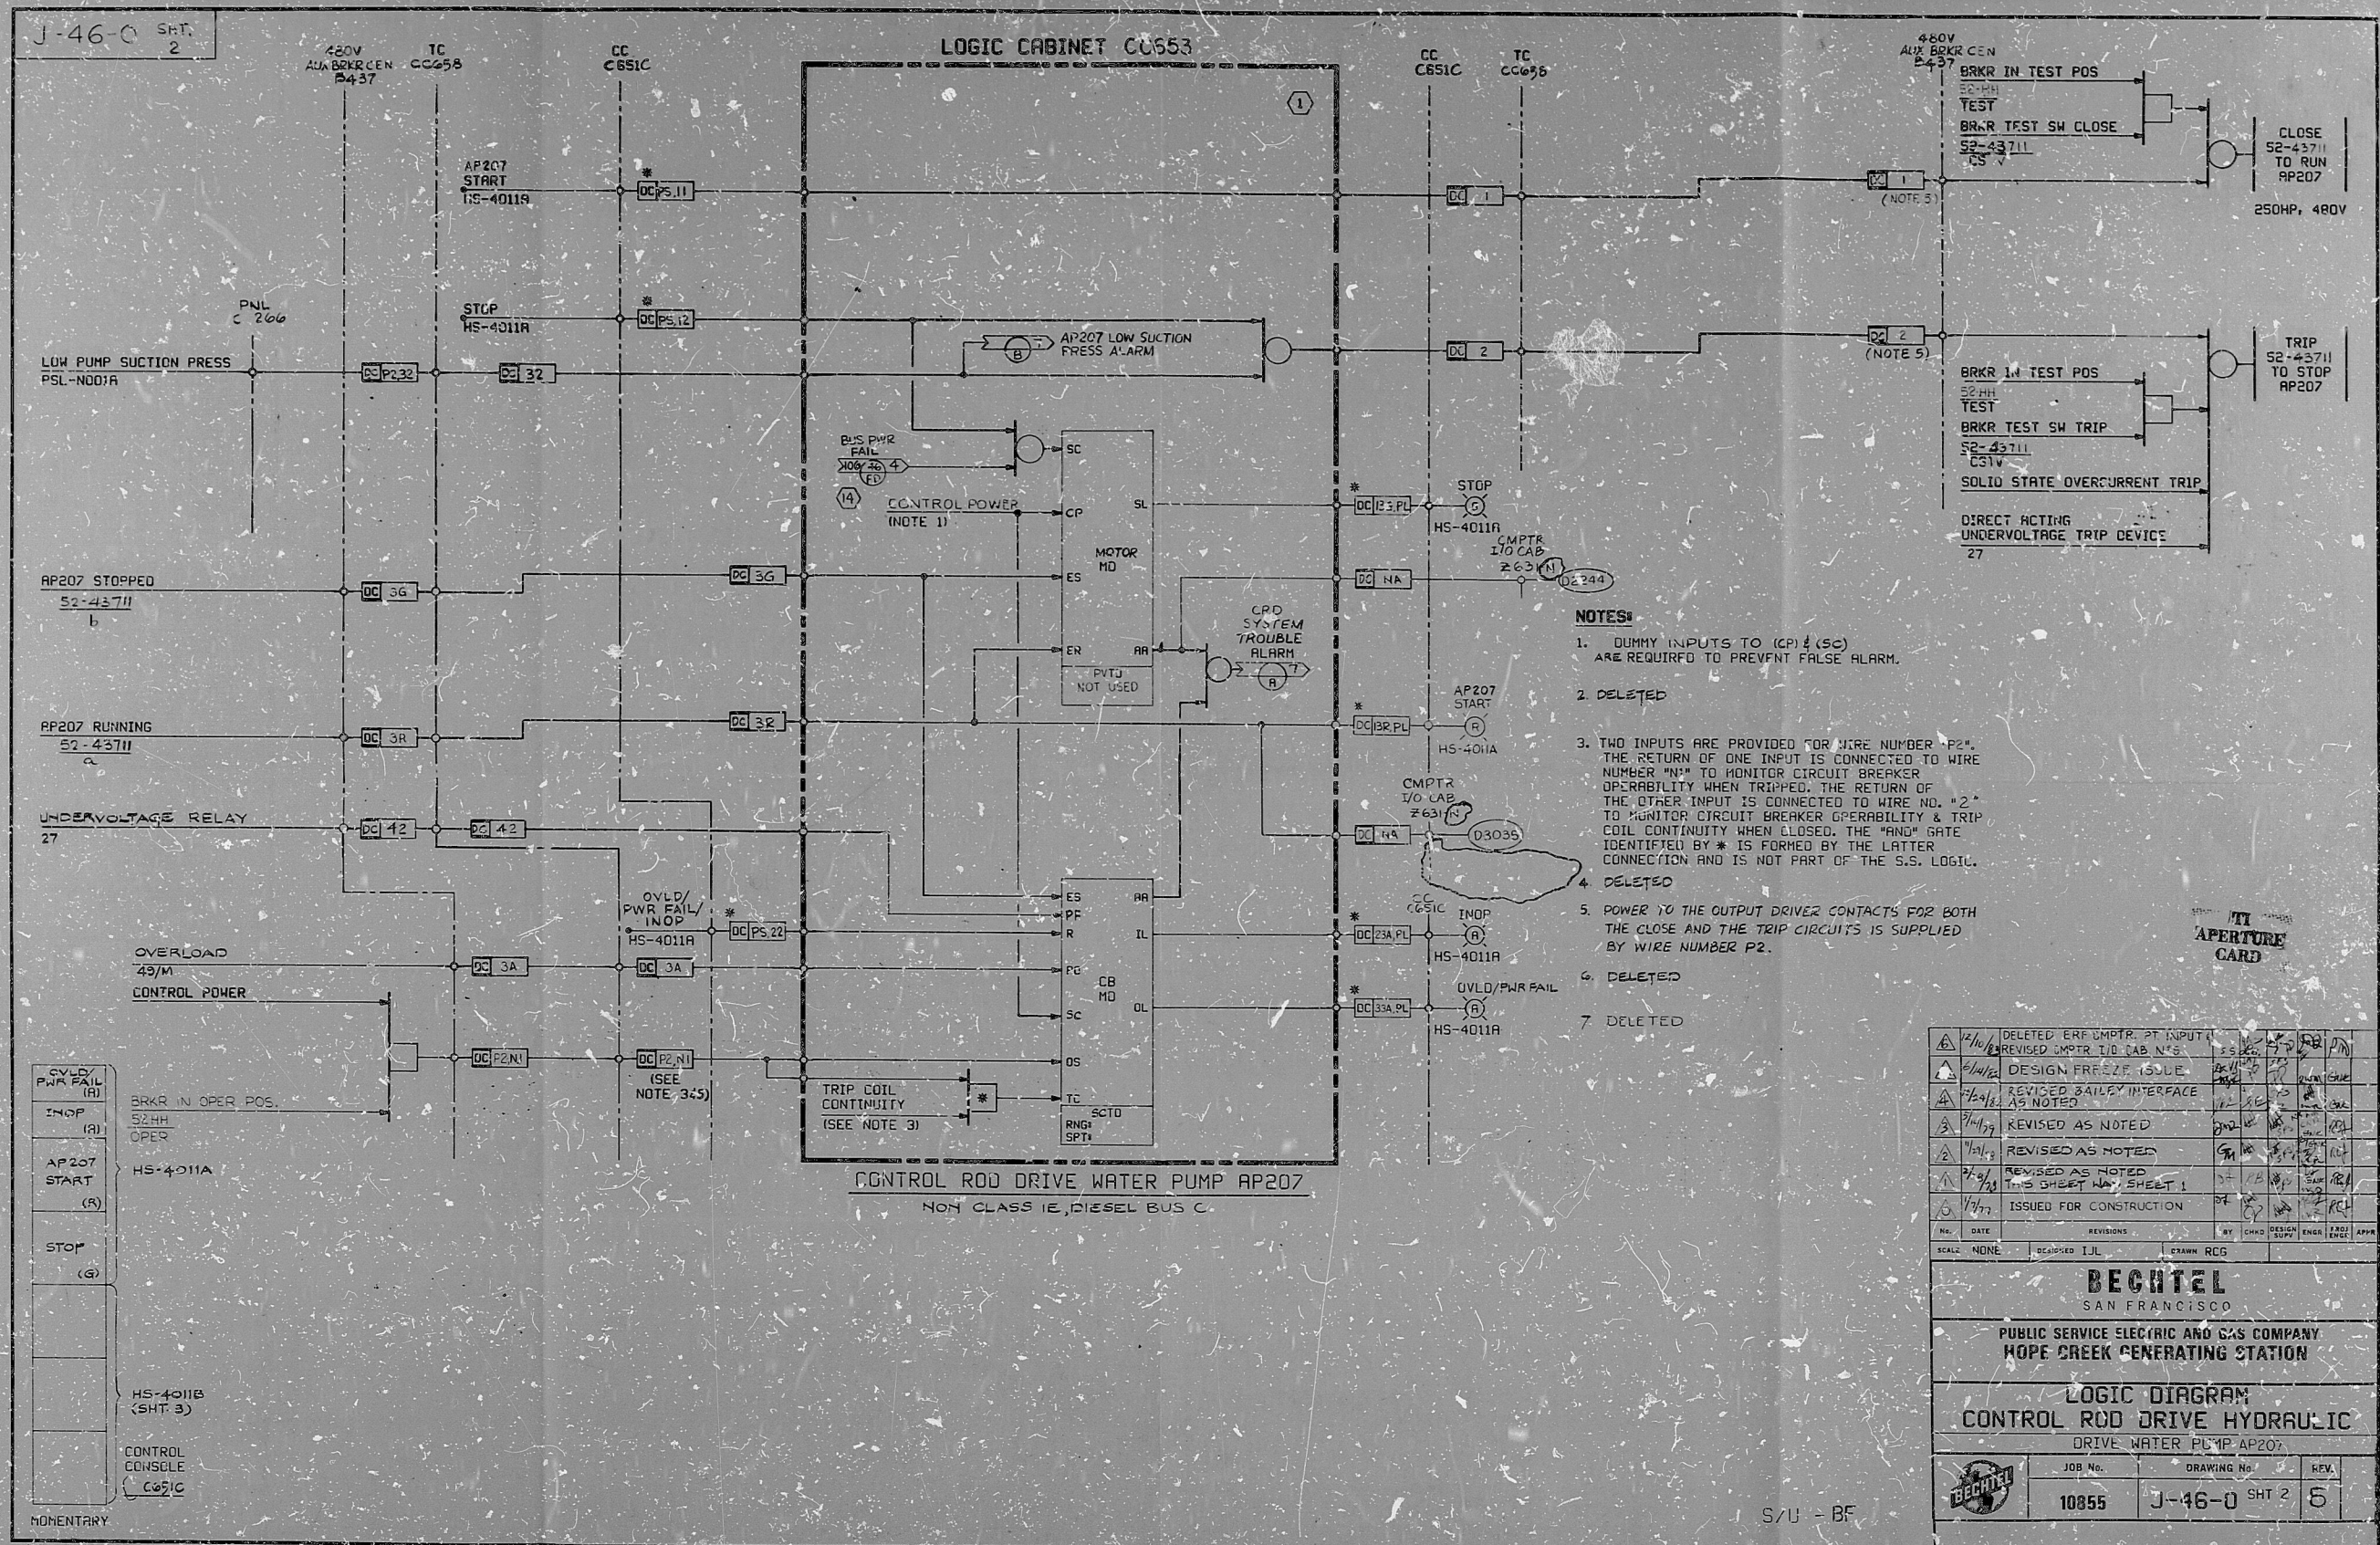

53

PDR RIDS

8406280130

