




RIDS

8305100050

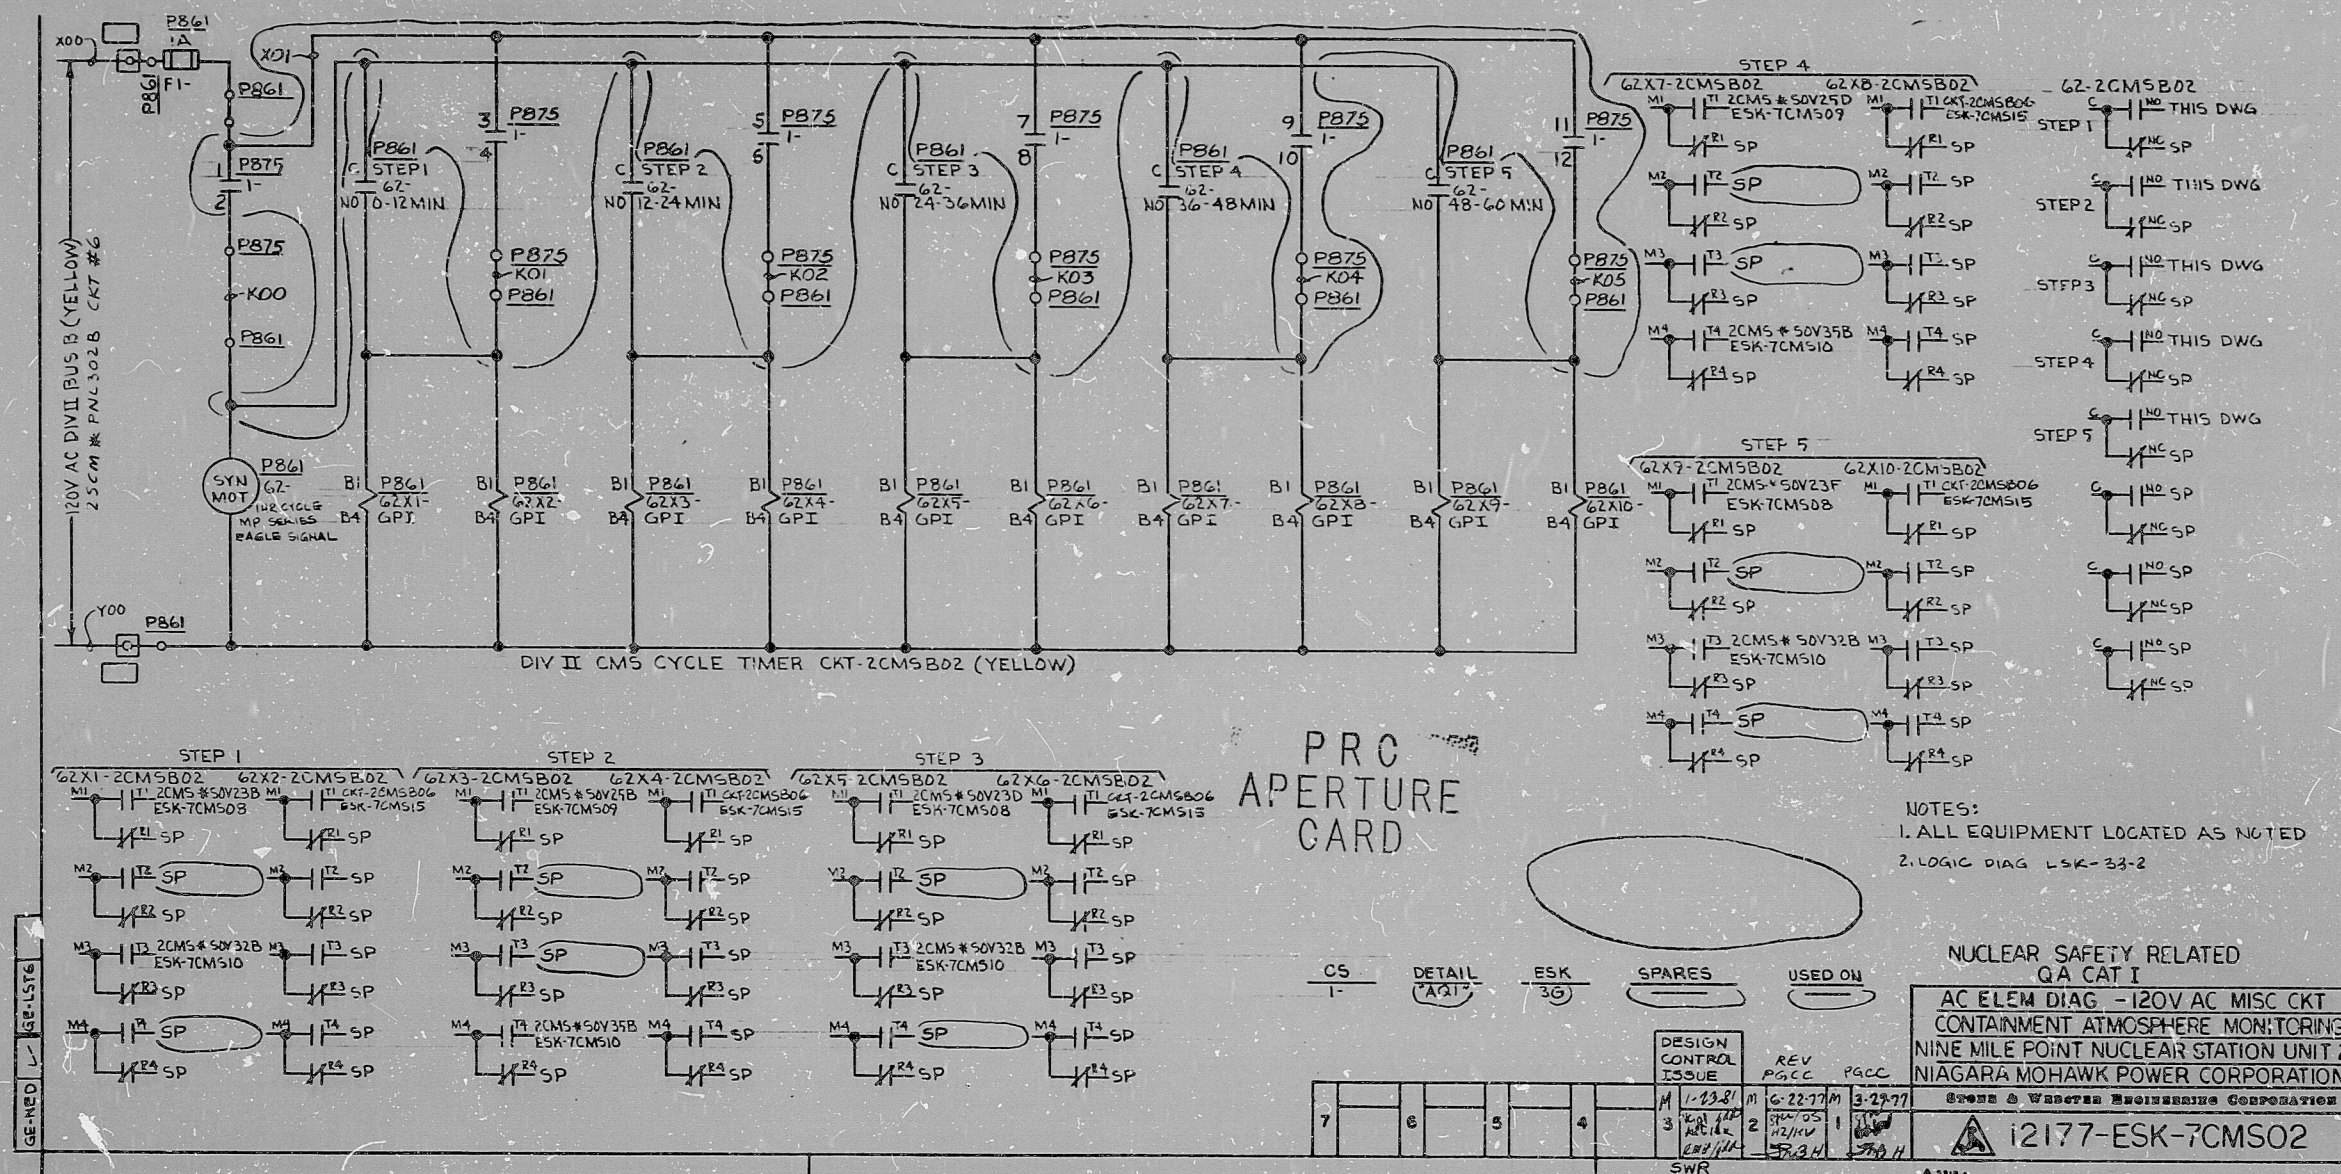