


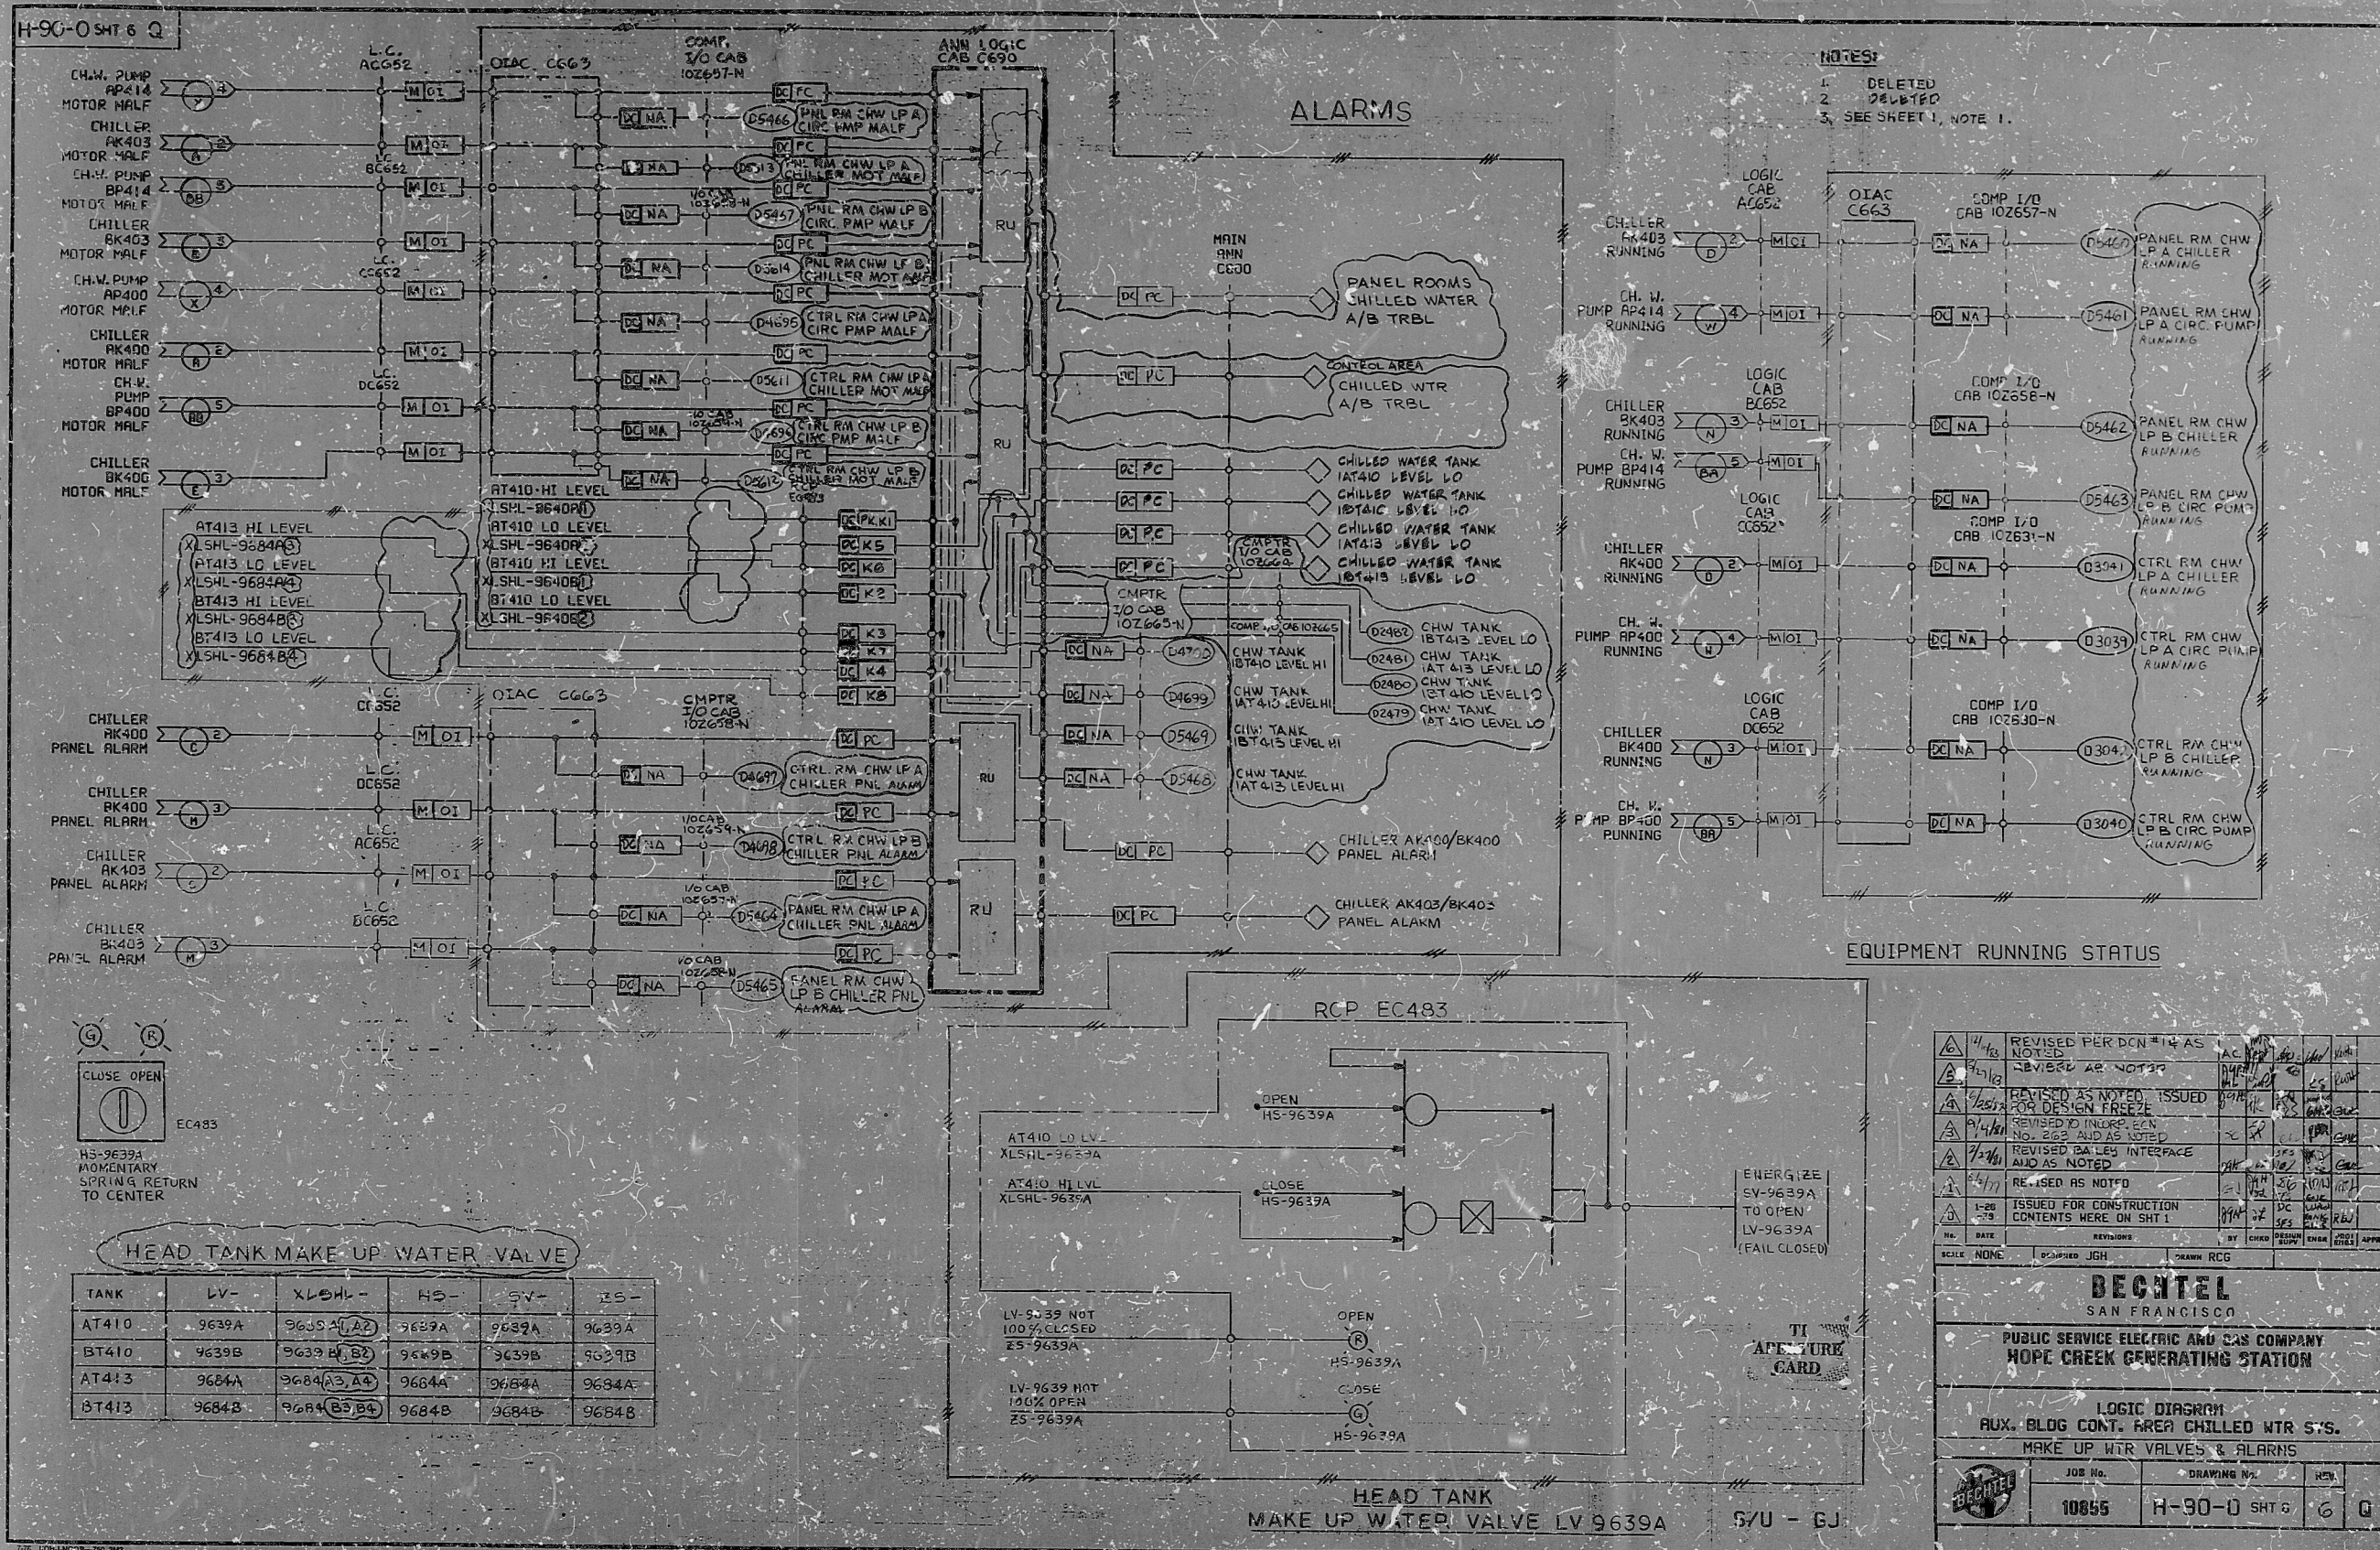

TANK	LV-	XLOHL-	HD-	GY-	IS-
AT410	9639A	9639A (4A)	9639A	9639A	9639A
BT410	9639B	9639B (4B)	9639B	9639B	9639B
AT413	9684A	9684A (3A)	9684A	9684A	9684A
BT413	9684B	9684B (3B)	9684B	9684B	9684B

PDR RIDS

8406280230

