

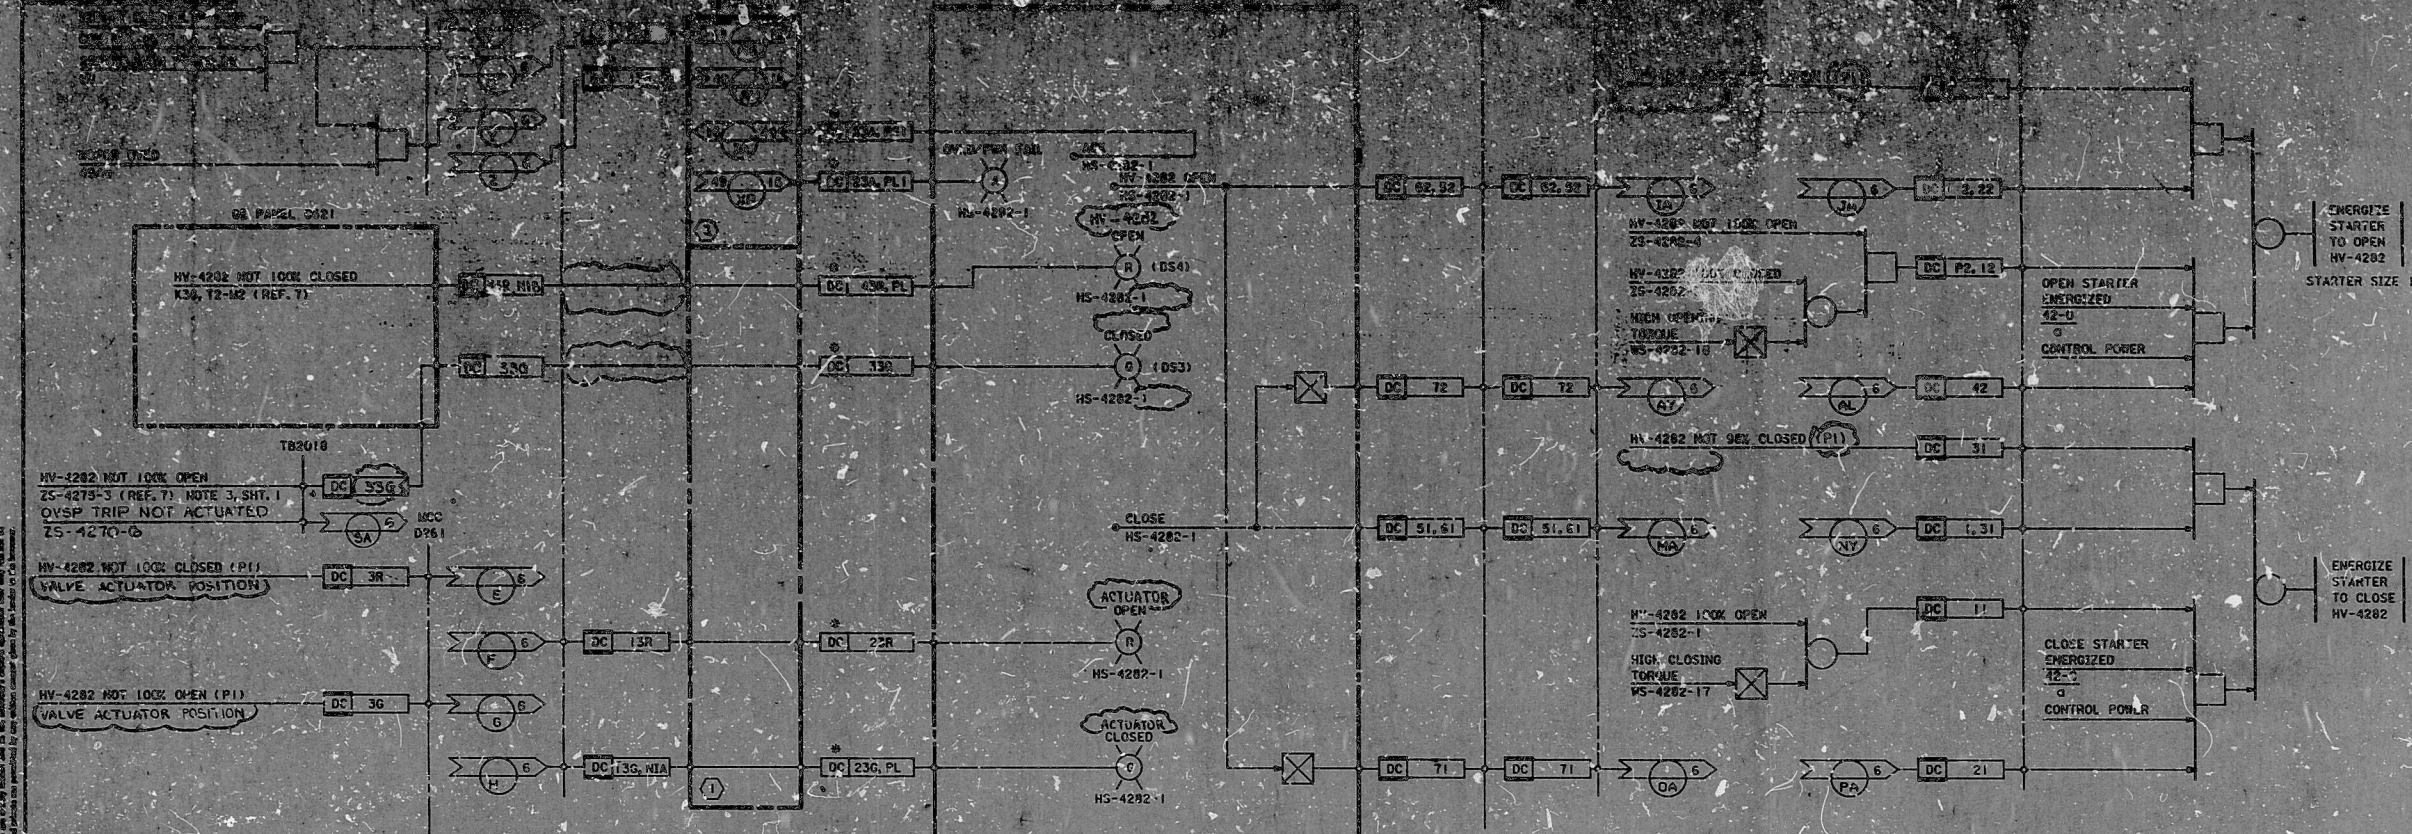


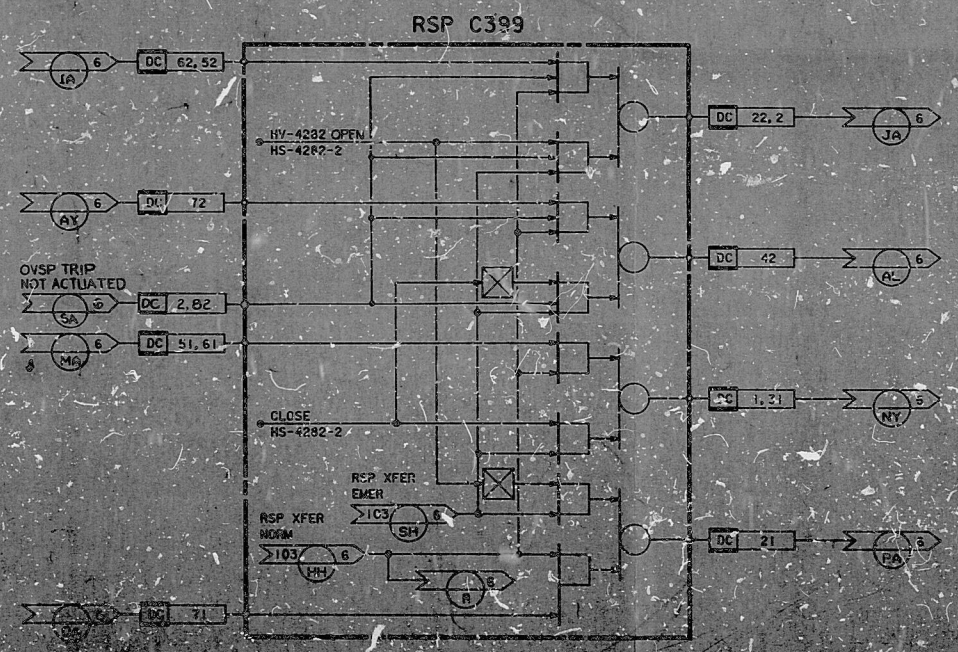

RCIC TURBINE TRIP/THROTTLE VALVE HV-4282
CLASS 1E, CHANNEL B

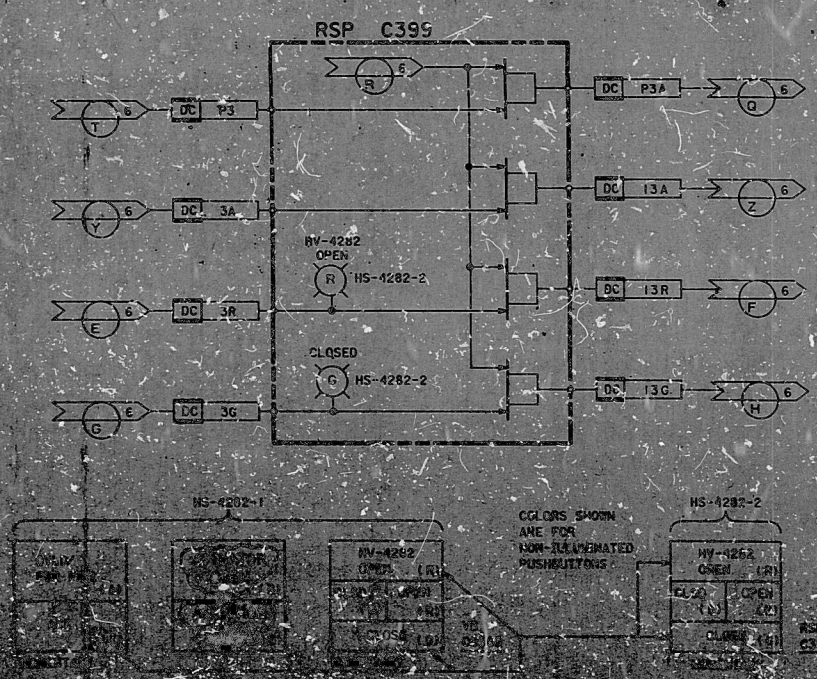

TI
APERTURE
CARD

NO.	DATE	REVISION	BY	CHKD	APPD

BECHTEL
SAN FRANCISCO

LOGIC DIAGRAM
RCIC TURBINE TRIP/THROTTLE VALVE HV-4282

PDR RIDS

8406280259

