


DIESEL GENERATOR ROOM 2B VENTILATION SYSTEM

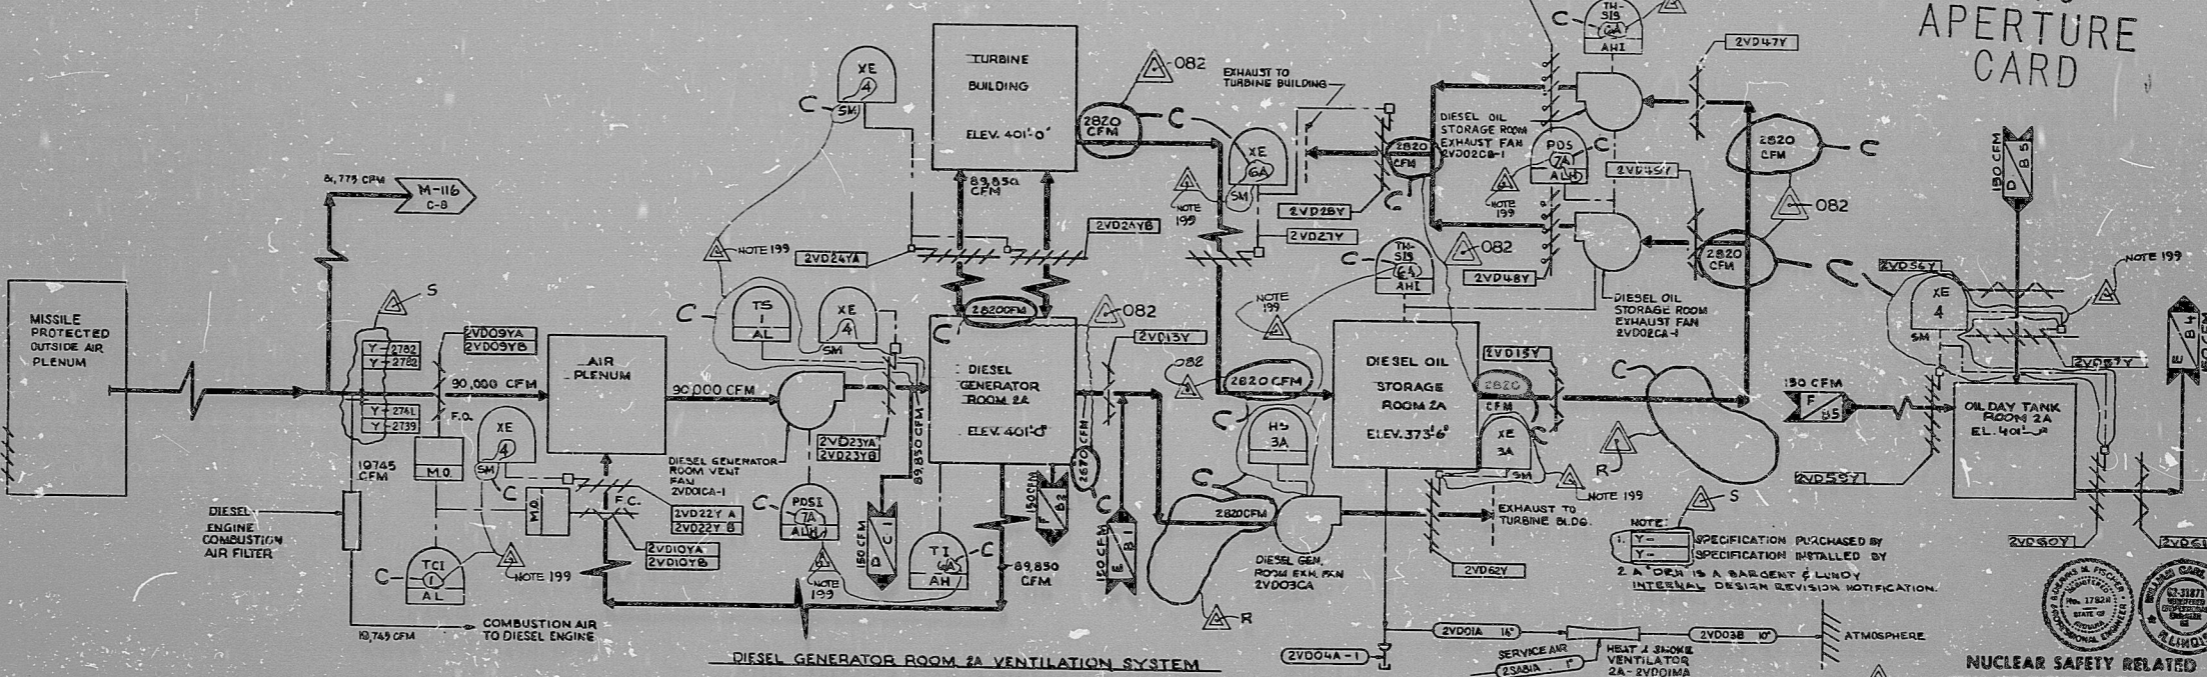

DIESEL GENERATOR ROOM 2A VENTILATION SYSTEM

PRC APERTURE CARD

NUCLEAR SAFETY RELATED ITEMS ARE SHOWN ON THIS DRAWING
CLASSIFICATION BOUNDARY DEFINITION ON M-34 (SHT. 1)



DIAGRAM OF DIESEL GENERATOR ROOM 2A & 2B VENTILATION SYSTEM

CHICAGO, ILLINOIS

SARGENT & LUNDY
ENGINEERS
CHICAGO, ILLINOIS

DRAWING NO. M-98
SHEET 1 OF 1



SCALE: NONE
PROJECT NUMBER: 4923-00


8305100/62

RIDS

