



J-51-0
SHT. 25

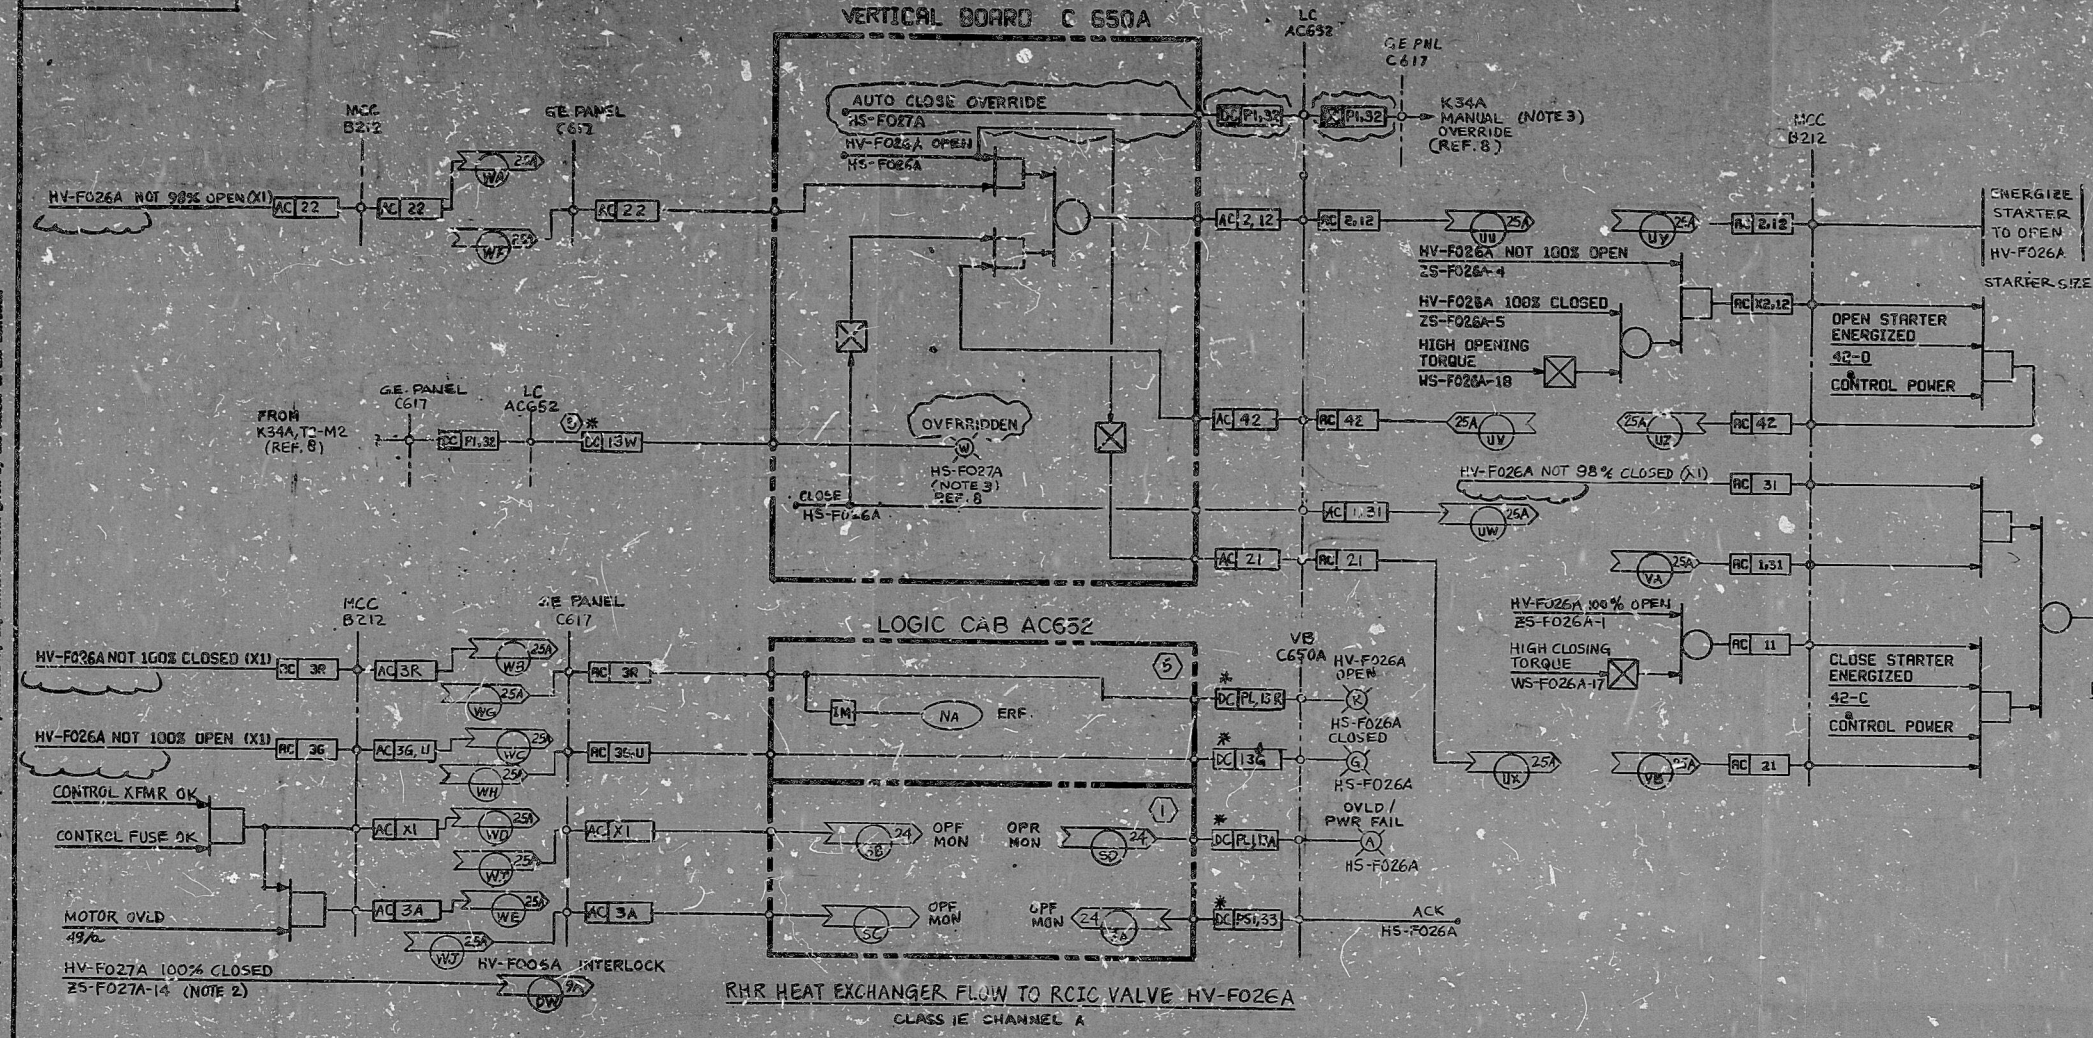

- NOTES:
1. THE BASIC POSITION AND TORQUE SWITCH NOS. FOR EACH VALVE ARE GIVEN IN THE TABLE. OPEN NOS. TO IDENTIFY SPECIFIC CONTACTS SHALL BE ADDED AS SHOWN ON THE DIAGRAM.
 2. HV-F027A 100% CLOSED INTERLOCKS WITH VALVE HV-F026A ONLY.
 3. OVERRIDE IS PROVIDED FOR HV-F027A ONLY.

CROSS REFERENCE TABLE

VALVE	SERVICE	CONTROL SWITCH	POSITION SWITCH (NOTE 1)	TORQUE SWITCH (NOTE 1)	VERTICAL BOARD	CLASS IE CHANNEL	MCC	GE PANEL	LOGIC CABINET	CKT NO.	OPF MON	OPF MON ARROW	ACK	CONT FWR	OVLD	OVLD PWR FAIL	ERF COMP POINT
HV-F026A	HX FLOW RCIC	HS-F026A	ZS-F026A	WS-F026A	C650A	A	B212	C617	AC652	5	I	SA	SB	SC	SD	NA	NA
HV-F027A	STEAM LINE SUPPRESSION POOL SPRAY	HS-F027A	ZS-F027A	WS-F027A	C650A	A	B212	C617	AC652	5	I	SA	SB	SC	SD	NA	NA

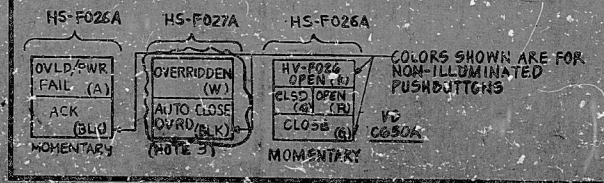

RECEIVED
SAN FRANCISCO
PUBLIC SERVICE ELECTRIC AND GAS COMPANY
HOPE CREEK GENERATING STATION
LOGIC DIAGRAM
RESIDUAL HEAT REMOVAL
RHR SYSTEM VALVES
10455
J-51-0
SHT 25
1 Q

S/U - BC

PDR RIDS

8406280374

