


ESSENTIAL SERVICE WATER COOLING TOWER ELECTRIC EQUIPMENT ROOM VENTILATION SYSTEM 1A

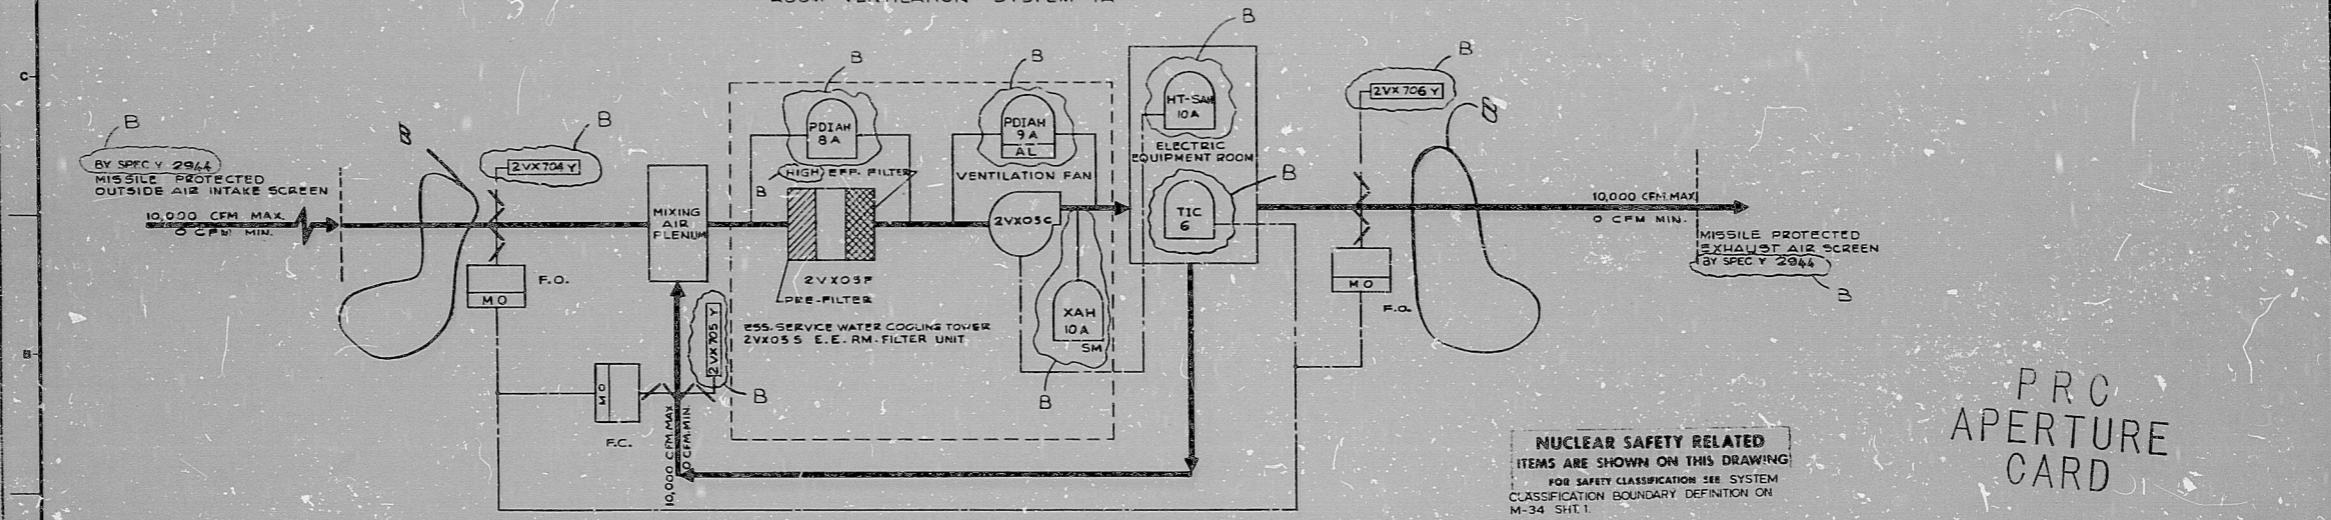

ESSENTIAL SERVICE WATER COOLING TOWER ELECTRIC EQUIPMENT ROOM VENTILATION SYSTEM 2A

NUCLEAR SAFETY RELATED
ITEMS ARE SHOWN ON THIS DRAWING
FOR SAFETY CLASSIFICATION SEE SYSTEM
CLASSIFICATION BOUNDARY DEFINITION ON
M-34 SHT. 1.

PRC
APERTURE
CARD

DRAWING RELEASE RECORD					DRAWING RELEASE RECORD					SCALE		PROJECT NUMBER		DRAWING NO.	
REV.	DATE	FIELD	PREPARED	REVIEWED	APPROVED	FILE NO.	DATE	FIELD	PREPARED	REVIEWED	APPROVED	SCALE	PROJECT NUMBER	DRAWING NO.	REV.
												NONE	4808	M-119	B
												4923			

DIAGRAM OF ESS SERVICE WATER COOLING TOWER ELECTRIC EQUIPMENT ROOM VENT. SYSTEM BLDG. OA

MARBLE HILL
NUCLEAR GENERATING STATION
UNIT 1 & 2
PUBLIC SERVICE INDIANA
PLAINFIELD, INDIANA

SARGENT & LINDY
CHICAGO

SHEET 1 OF 1

30X

8305110582

RIDS

