



J-101-0

This drawing and its changes are the property of BECHTEL. They are loaned to you and are not to be reproduced, copied, loaned, exhibited, nor used except in the limited way and for the limited time for which they are loaned to you.

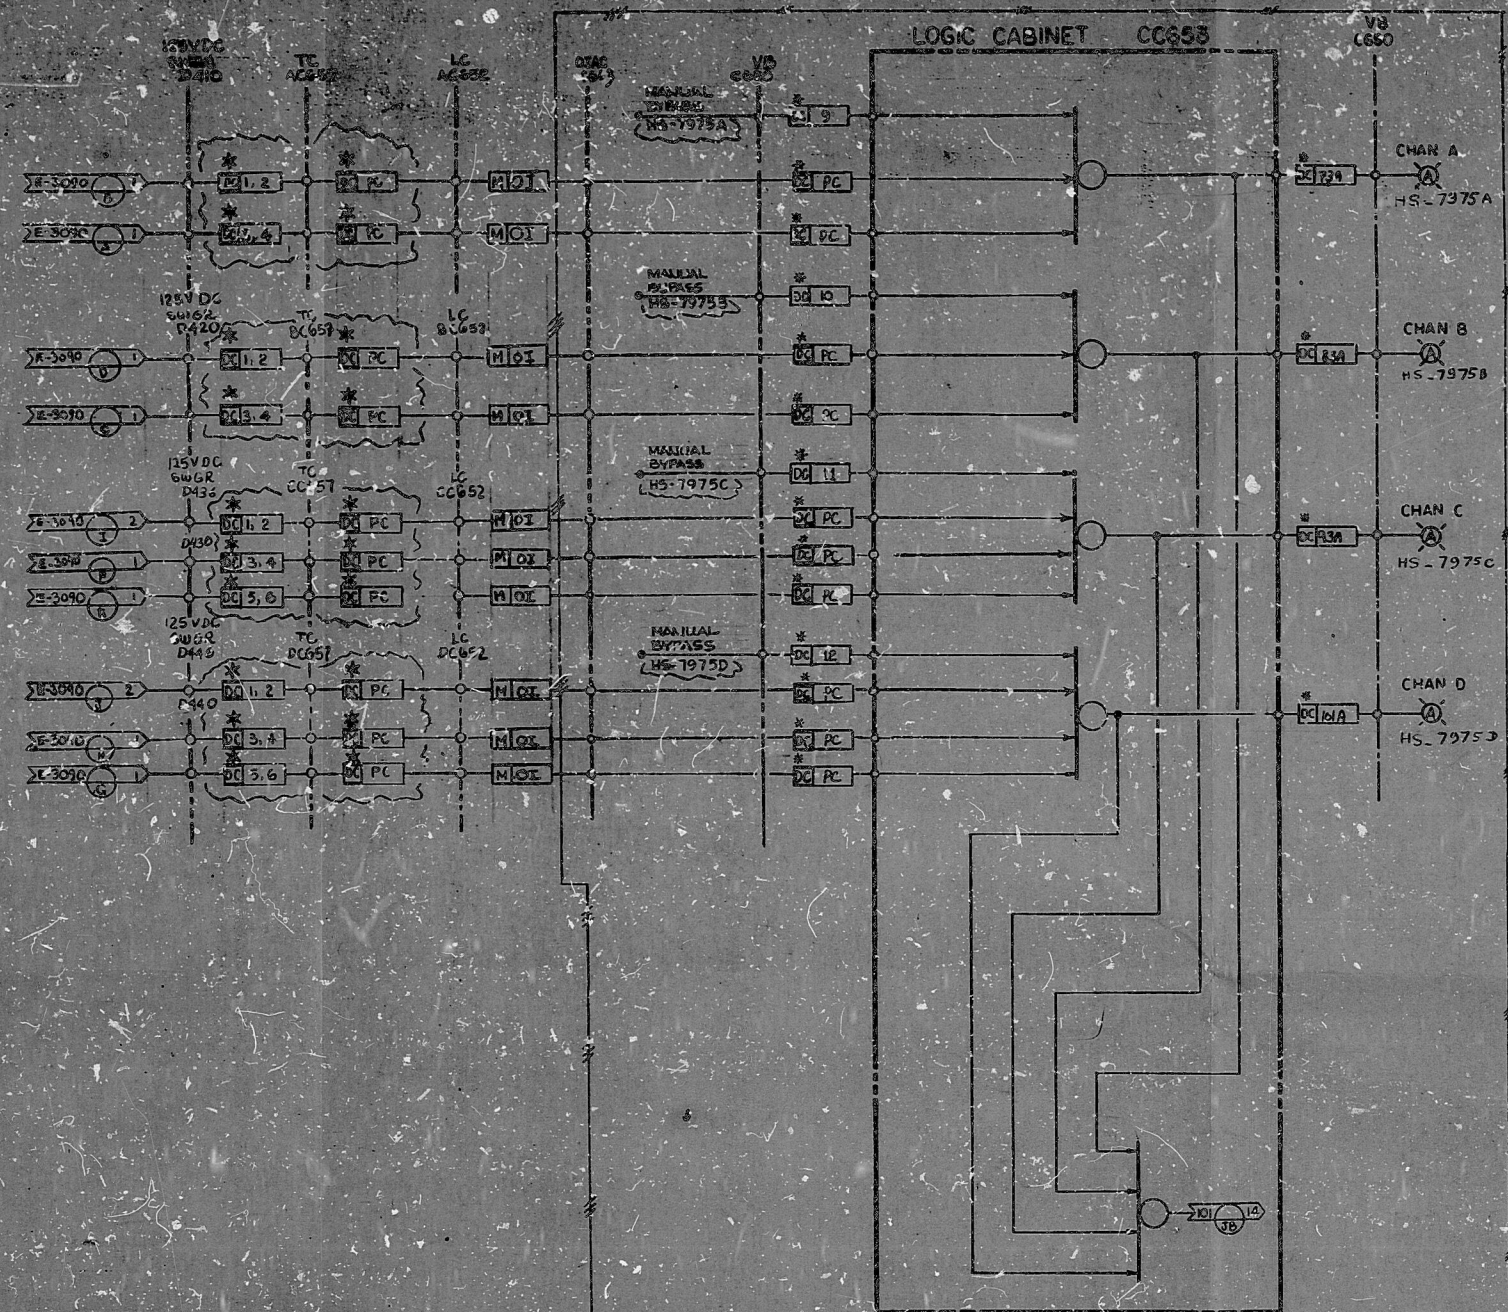

125V DC BATTERY CHARGER OUT OF SERVICE

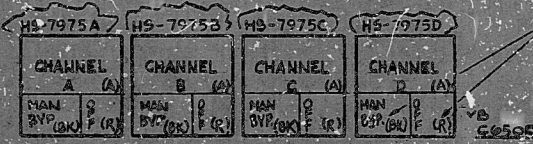

COLORS SHOWN ARE FOR NON-ILLUMINATED PUSH BUTTON (TYP. CHANNEL A, B, C, D)

TI
APERTURE
CARD

INCORPORATED DGM NO. 7	REV. 1	REV. 2	REV. 3	--------	--------	---------	---------	----------	----------	-----------	-----------	------

PDR RIDS

8406290114

