


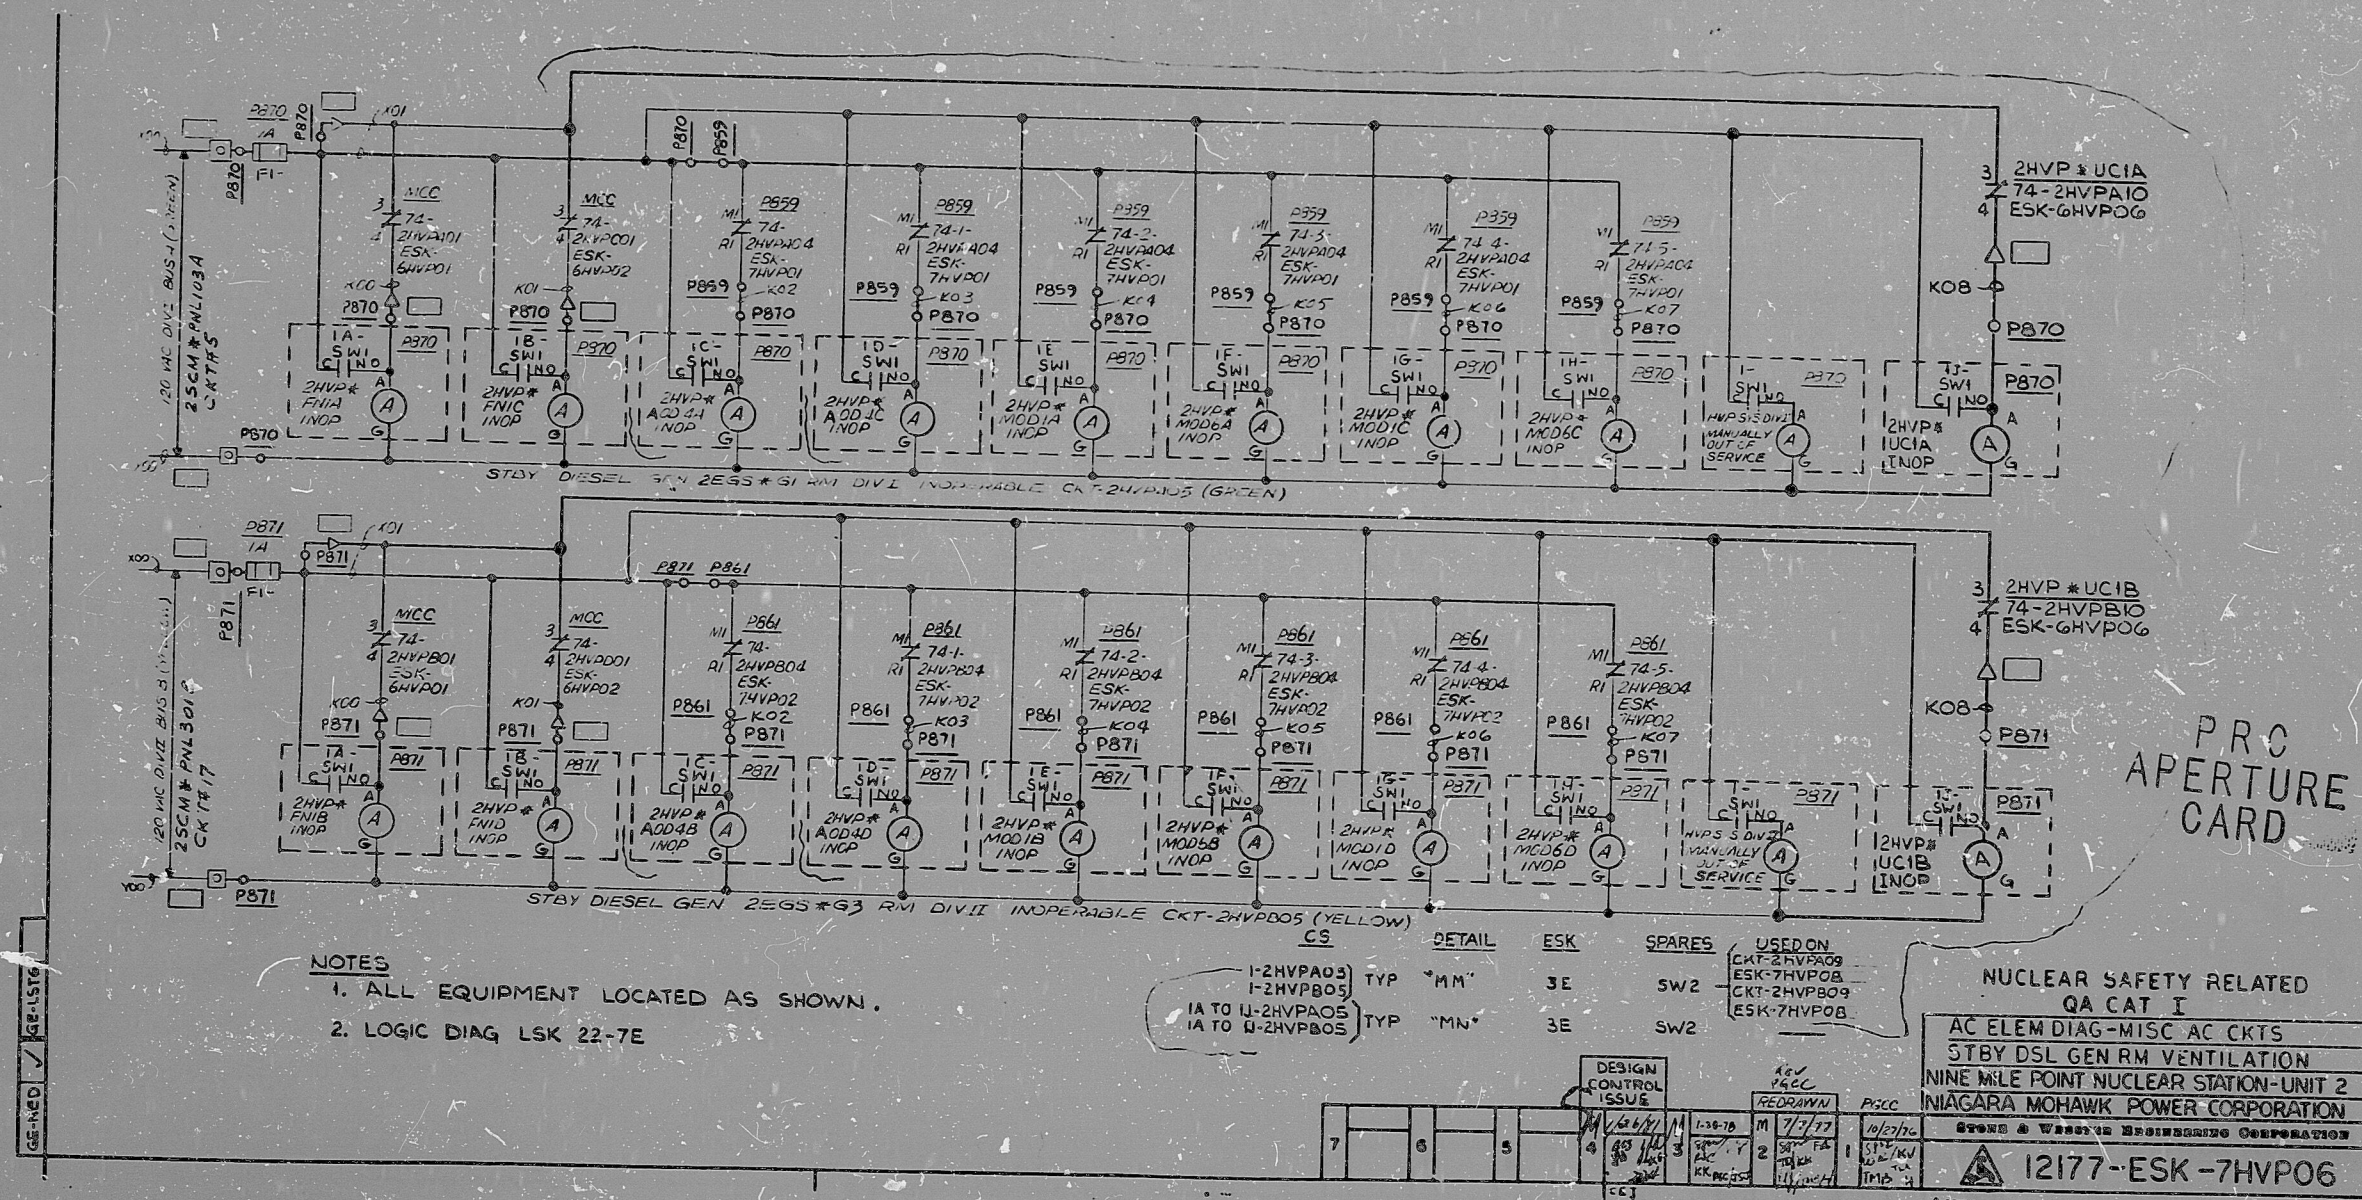

RIDS

830512049

