


J-15-0 SHT. 4

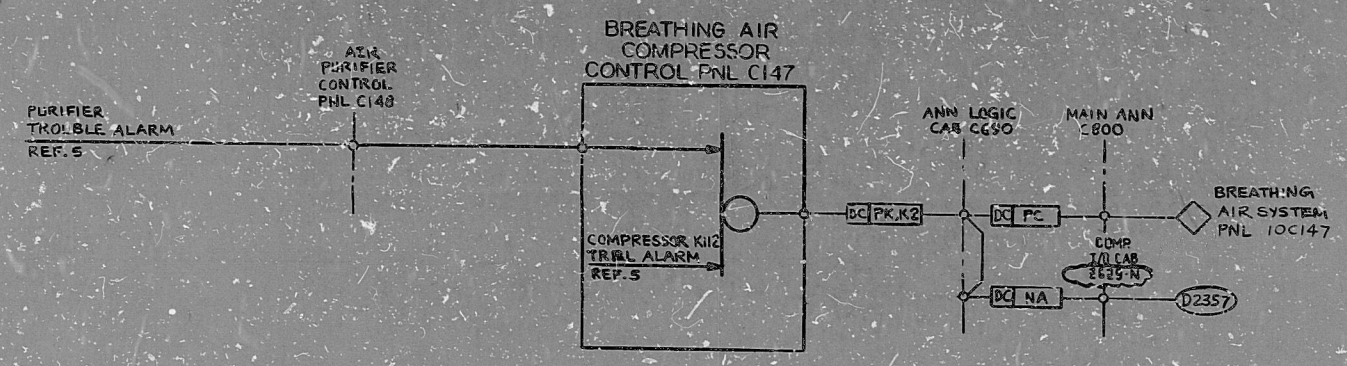

COMPUTER INPUT & TROUBLE ALARM

TI
APERTURE
CARD

S/U-KG

△									
△									
△									
NO.	DATE	REVISION	BY	CHKD	APPROV	DATE	DATE	DATE	DATE
SCALE	NONE	DESIGNED	MINH NGO	10/5	F.A.T.				
BECHTEL SAN FRANCISCO									
PUBLIC SERVICE ELECTRIC AND GAS COMPANY HOPKINS CREEK GENERATING STATION									
LOGIC DIAGRAM BREATHING AIR SYSTEM COMPUTER INPUT & TROUBLE ALARM									
JOB NO.		DRAWING NO.		REV.					
10855		J-15-0 SHT 4		1					

PDR RIDS

8406290369

