



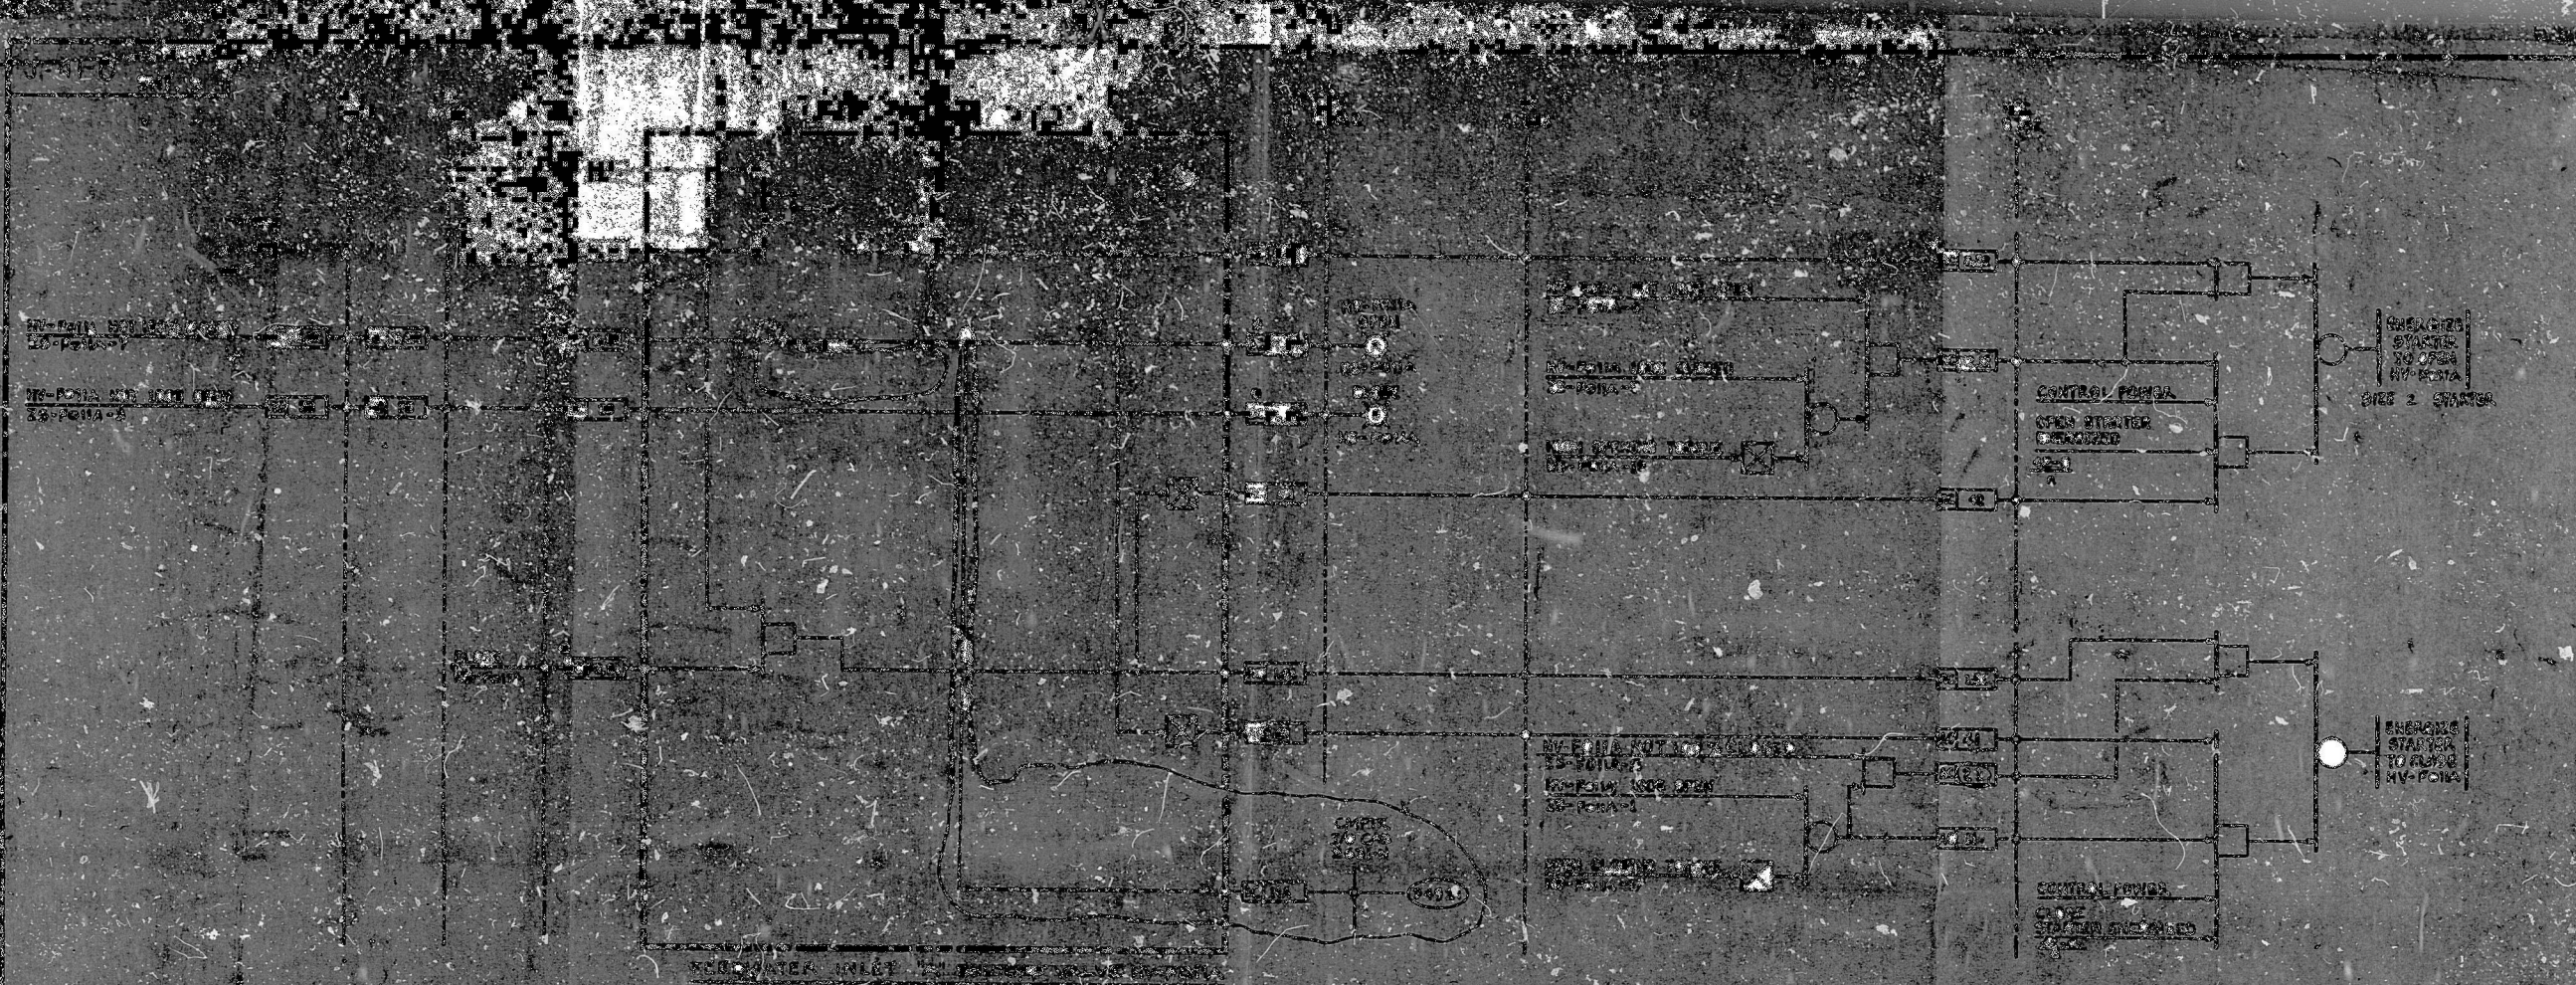




 

PDR RIDS

8406290433

