


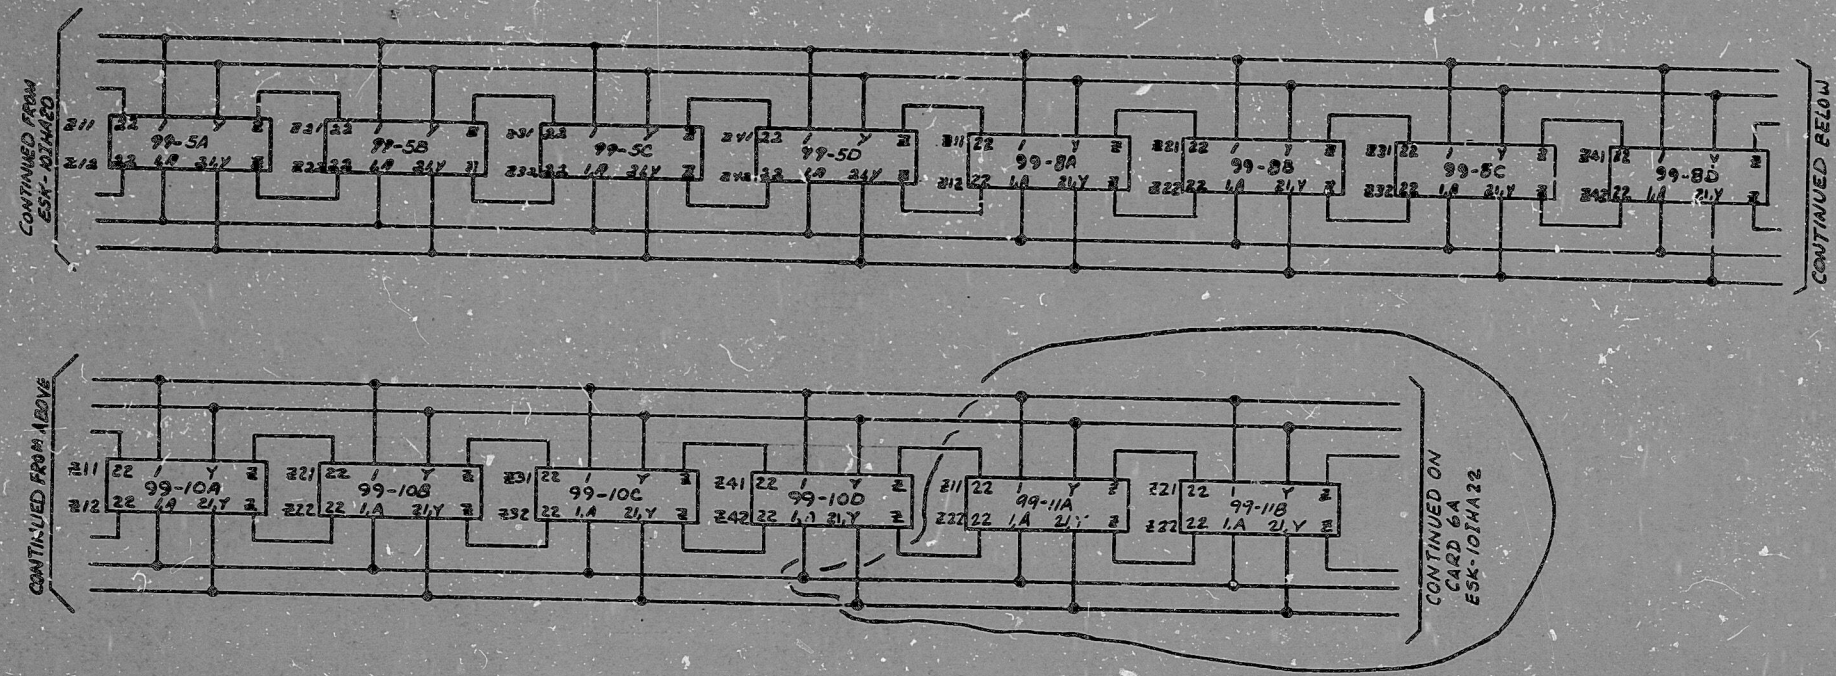

DIGITAL OPTICAL ISOLATOR - INPUT CARD-DIB001 / OUTPUT CARD-DIB002

99-5A																				
99-5B																				
99-5C																				
99-5D																				
99-8A																				
99-8B																				
99-8C																				
99-8D																				
99-10A																				
99-10B																				
99-10C																				
99-10D																				
99-11A																				
99-11B																				
99-11C																				
99-11D																				

ANNUNCIATOR OPTICAL ISOLATOR CONTROL CIRCUIT

PRC
APERTURE
CARD

- NOTES:
1. ALL EQUIPMENT LOCATED AT P938 UNLESS NOTED OTHERWISE.
 2. JUMBERS ON EACH INPUT CARD A TO B, C TO D, E TO F, H TO J, K TO L, M TO N, P TO R, S TO T, U TO V, W TO X.
 3. REFERENCES:
 55 DOCUMENT 274455
 56 QWG 1500570AA
 56 QWG 2510570AA

NUCLEAR SAFETY RELATED
QA CAT I, II



NIAGARA MOHAWK POWER CORPORATION	12177-ESK-10THA21		

RIDS

8305180220

