


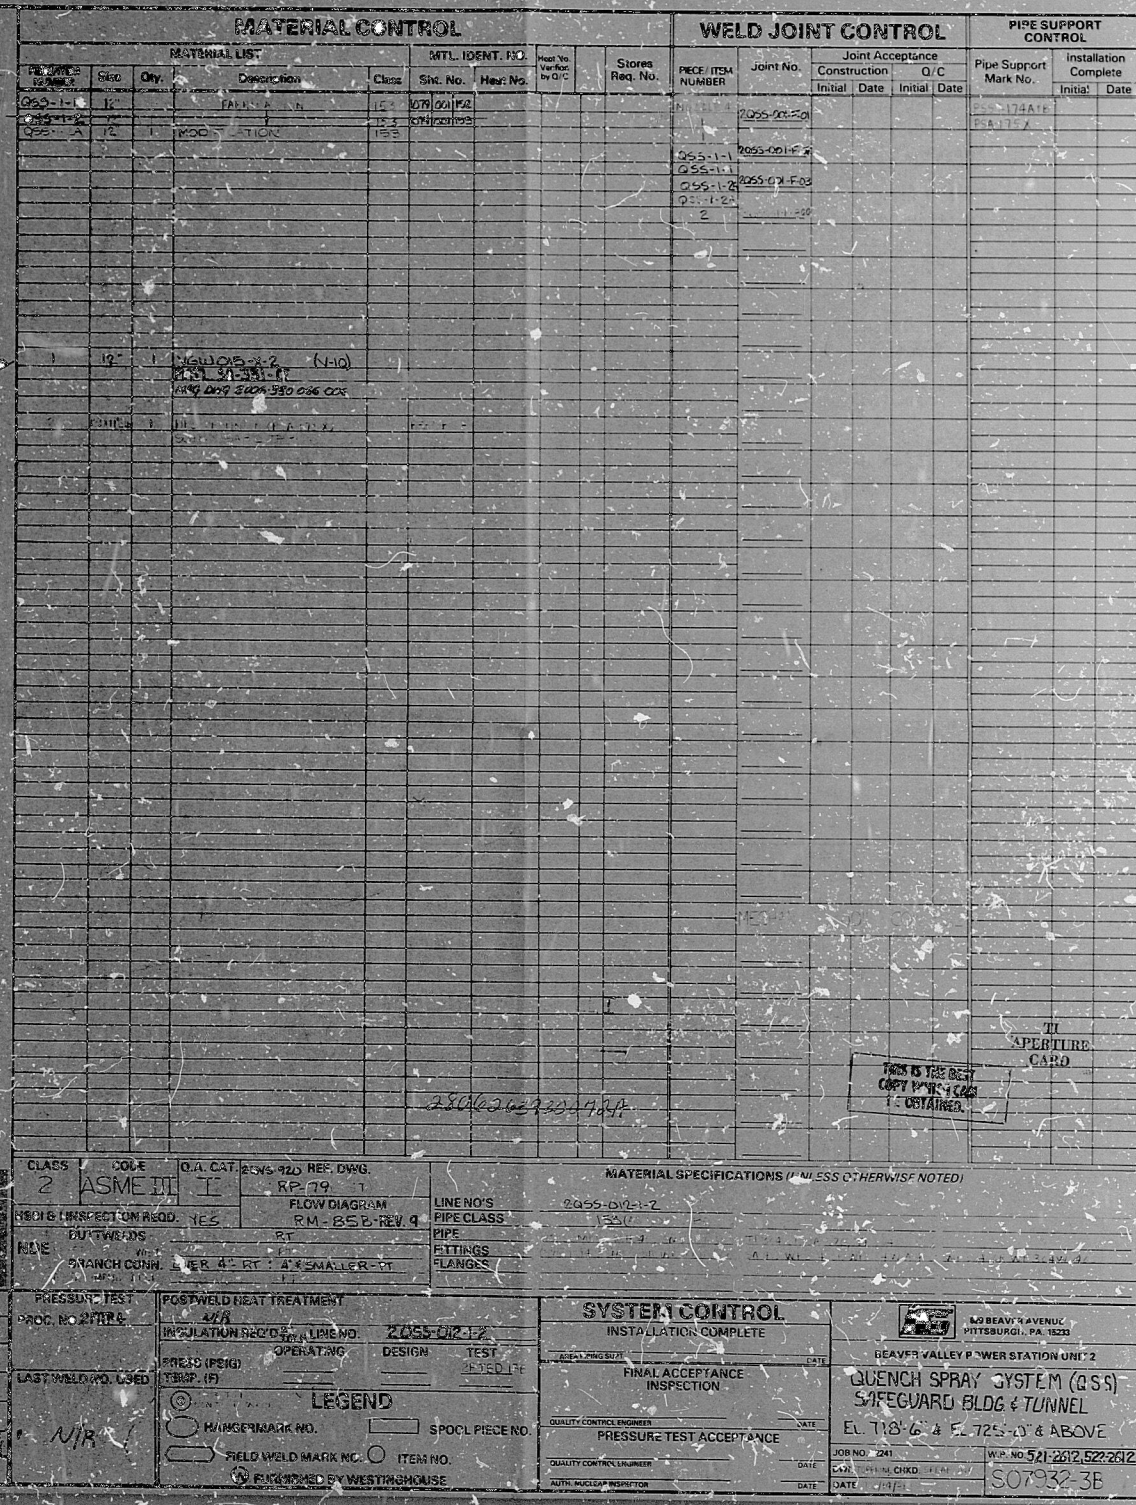

EMVPPC
PDR RIDS

8407260095

