





PARTIAL PLAN REACTOR BUILDING
ELEVATION 175'-0"

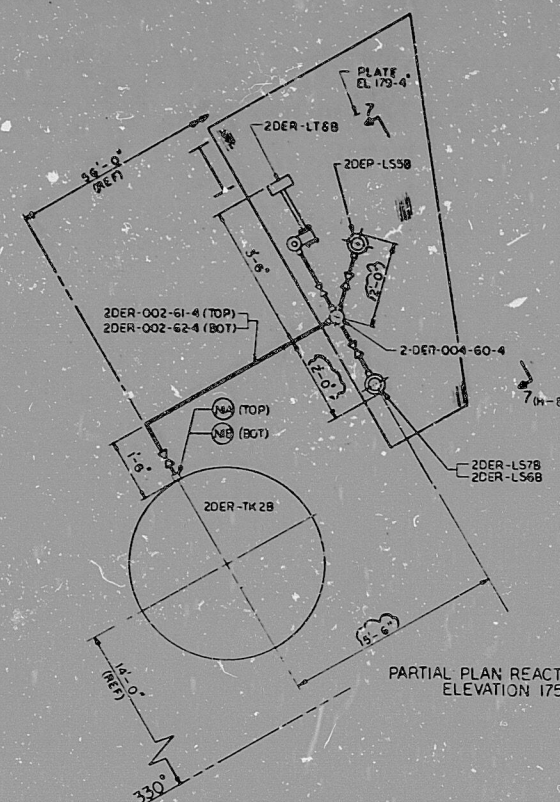


PARTIAL PLAN REACTOR BUILDING
ELEVATION 175-0'


NOTES:
1. SCALE: $\frac{1}{4}'' = 1'-0''$, UNLESS OTHERWISE NOTED.
2. GENERAL NOTES AND REFERENCES DWG EX-406A.

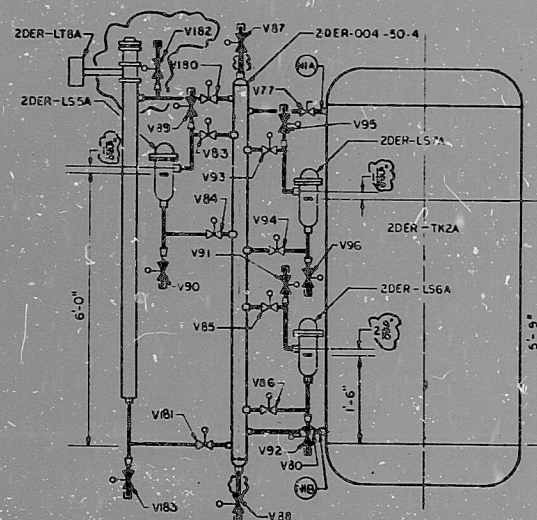


6-6 (D-3) (AS SHOWN) PIPING CLASS 153
ALL VALVE NUMBERS TO BE PREFIXED WITH "200"
SCALE: NONE

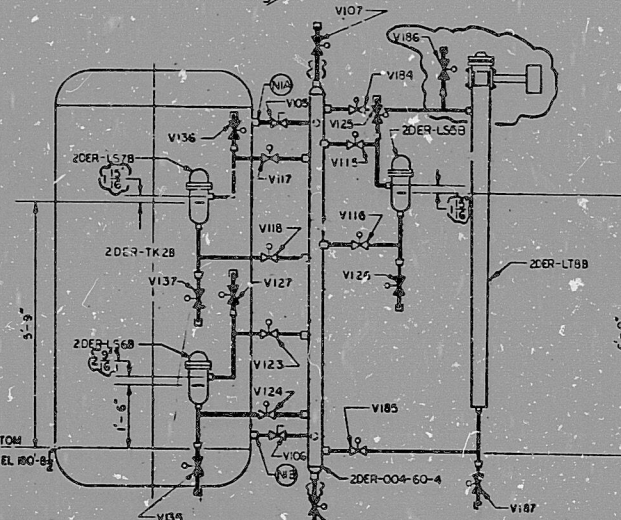


7-7 (J-3) (AS SHOWN) PIPING CLASS 153
ALL VALVE NUMBERS TO BE PREFIXED WITH "2DEN"
SCALE: NONE

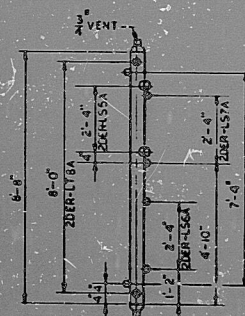

2-~~DER~~-004-50-4
SCALE: NONE

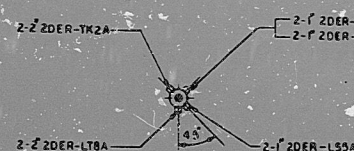

PLAN

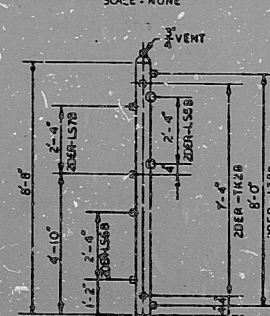

2-DEK-004-60-4
SCALE: NONE



PLAN

PRC
APERTURE
CARD

APPROVED _____
 LICENSED PROFESSIONAL ENGINEER, IN
 STATE OF NEW YORK
 ALTERNATE EXCEPT BY A LICENSED PROFESSIONAL ENGINEER IN ALTERNATE
 NUCLEAR SAFETY RELATED
 QA CAT II

INSTRUMENT PIPING
LEVEL CONTROLS & SWITCHES SH 3

NINE MILE POINT NUCLEAR STATION - UNIT 2
 NIAGARA MOHAWK POWER CORPORATION
 STONE & WEESTER ENGINEERING CORPORATION
 CHERRY HILL, N.J.


12177-EK-406C-2


