


509922

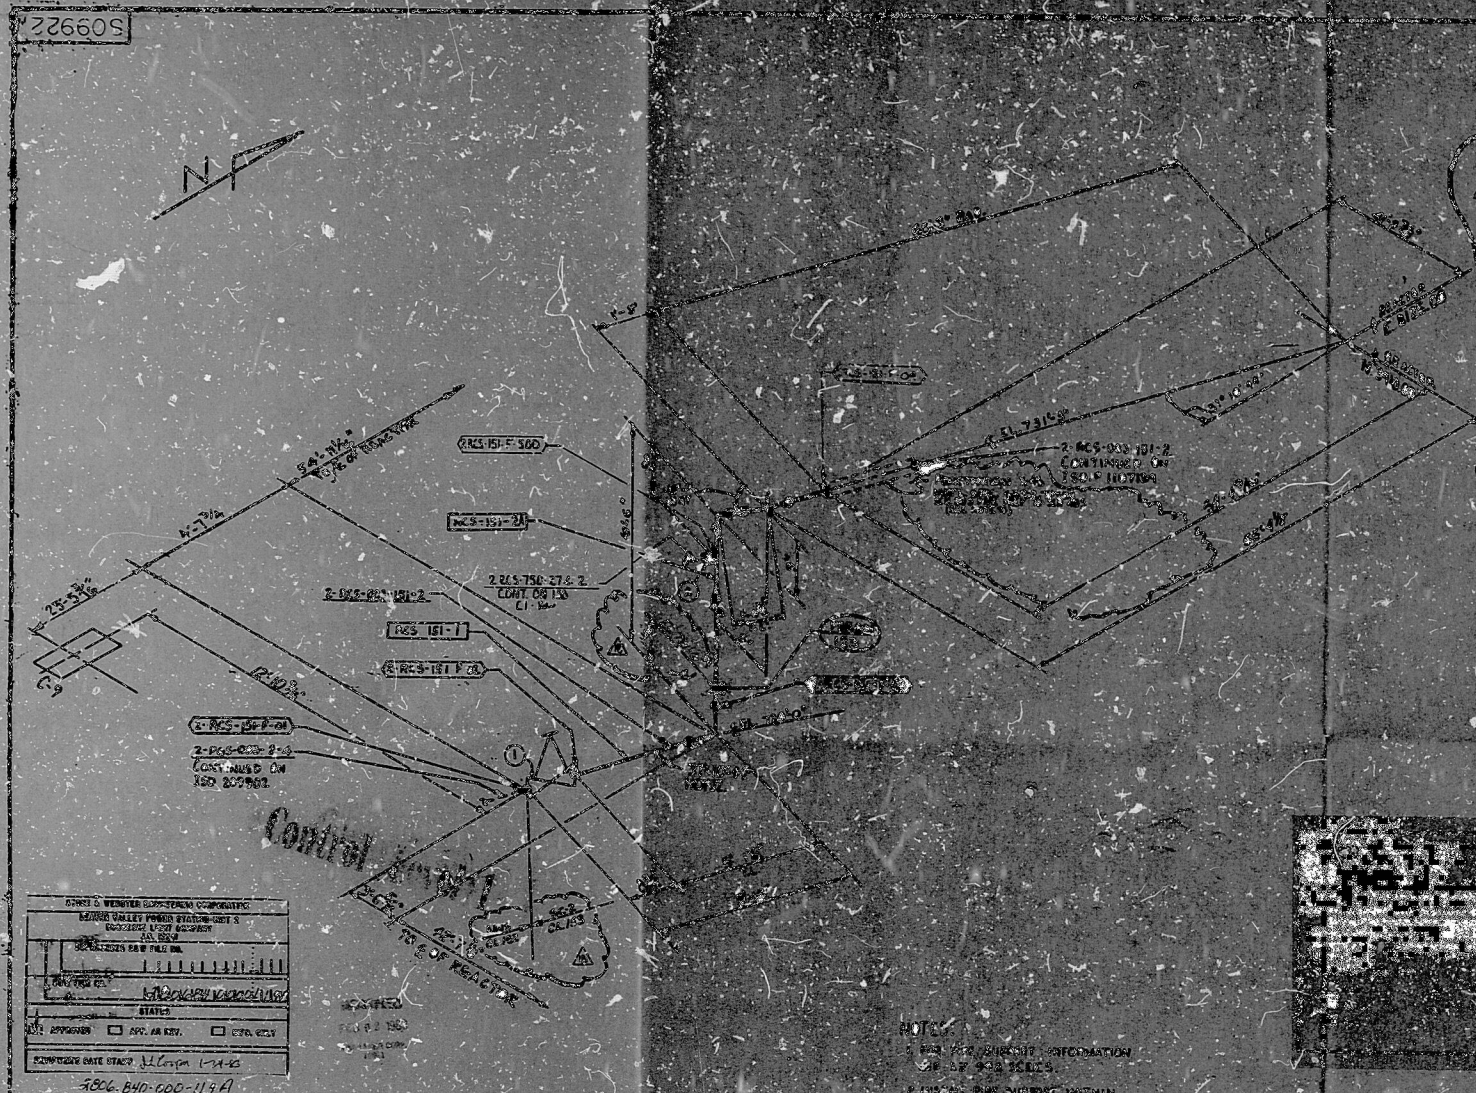

Control Level 1

[illegible]

NOTES:


MATERIAL CONTROL										JOINT CONTROL				PIPE SUPPORT CONTROL			
CLASS	CODE	QTY	DESCRIPTION	SPEC. NO.	MATERIAL	SHEET NO.	JOINT NO.	Construction		O/C		Pipe Support	Location				
								Initial	Date	Initial	Date						
MECHANICAL JOINT CONTROL									
ITEM NO.	JOINT NO.								

8407260305

PDR RIDS

