


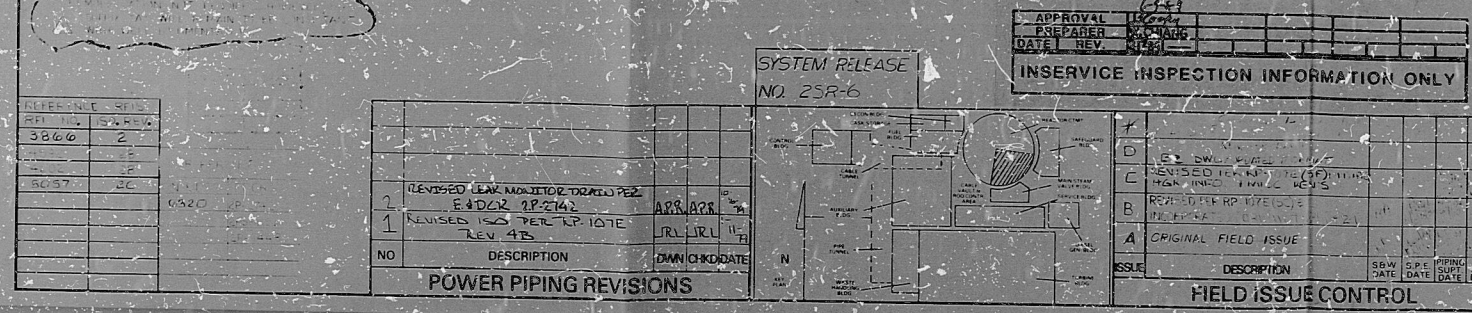

MATERIAL LIST

MTL IDENT. NO.

WELD JOINT CONTROL

PIPE SUPPORT CONTROL

PIECE/ITEM NUMBER	Size	Qty.	Description	Class	Sht. No.	Heat No.	Heat No. Verified by Q.C.	Sheet Req. No.	PIECE/ITEM NUMBER	Joint No.	Joint Acceptance Construction		Pipe Support Mark No.	Installation Complete	
											Initial Date	Initial Date		Initial	Date

EMVPPC

8407270343

PDR RIDs

