


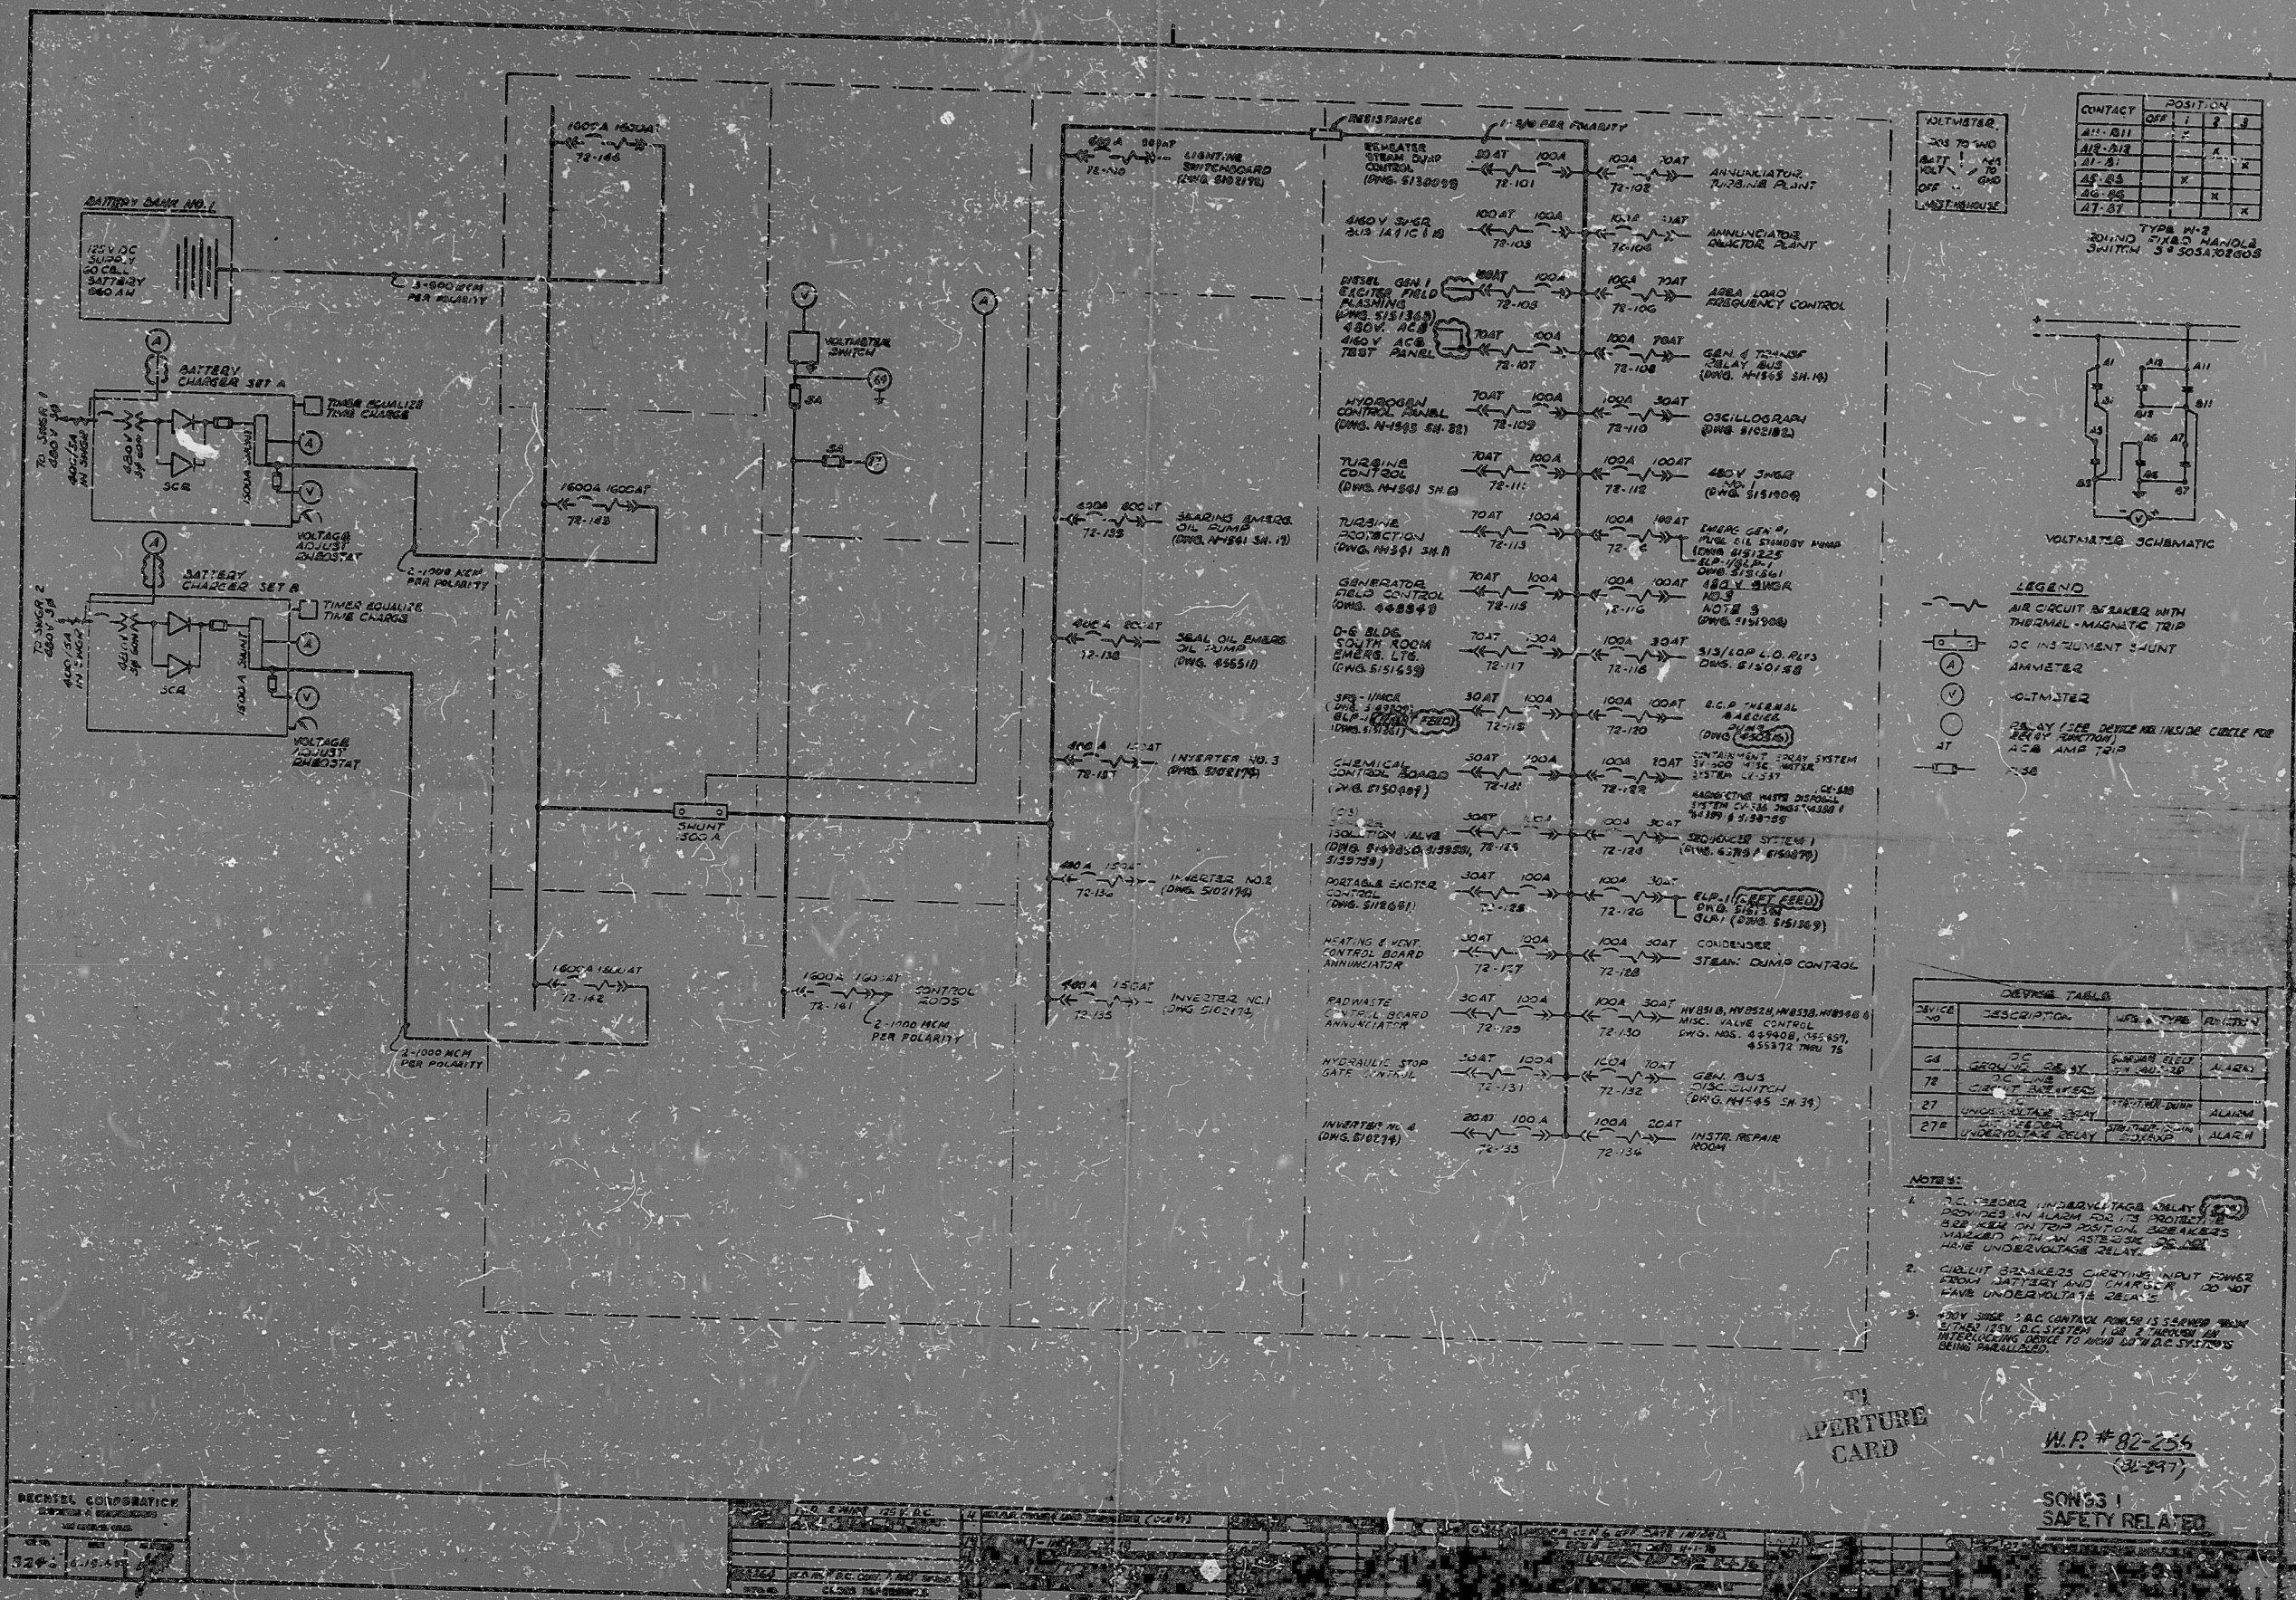

APERTURE
CARD

W.P. #82-256
(31-297)

SONG 1

848010243

PDR

8408010243

