


22"
17"
11"
8.5"
8.5"
11"
17"
22"

22"
17"
11"
8.5"
8.5"
11"
17"
22"

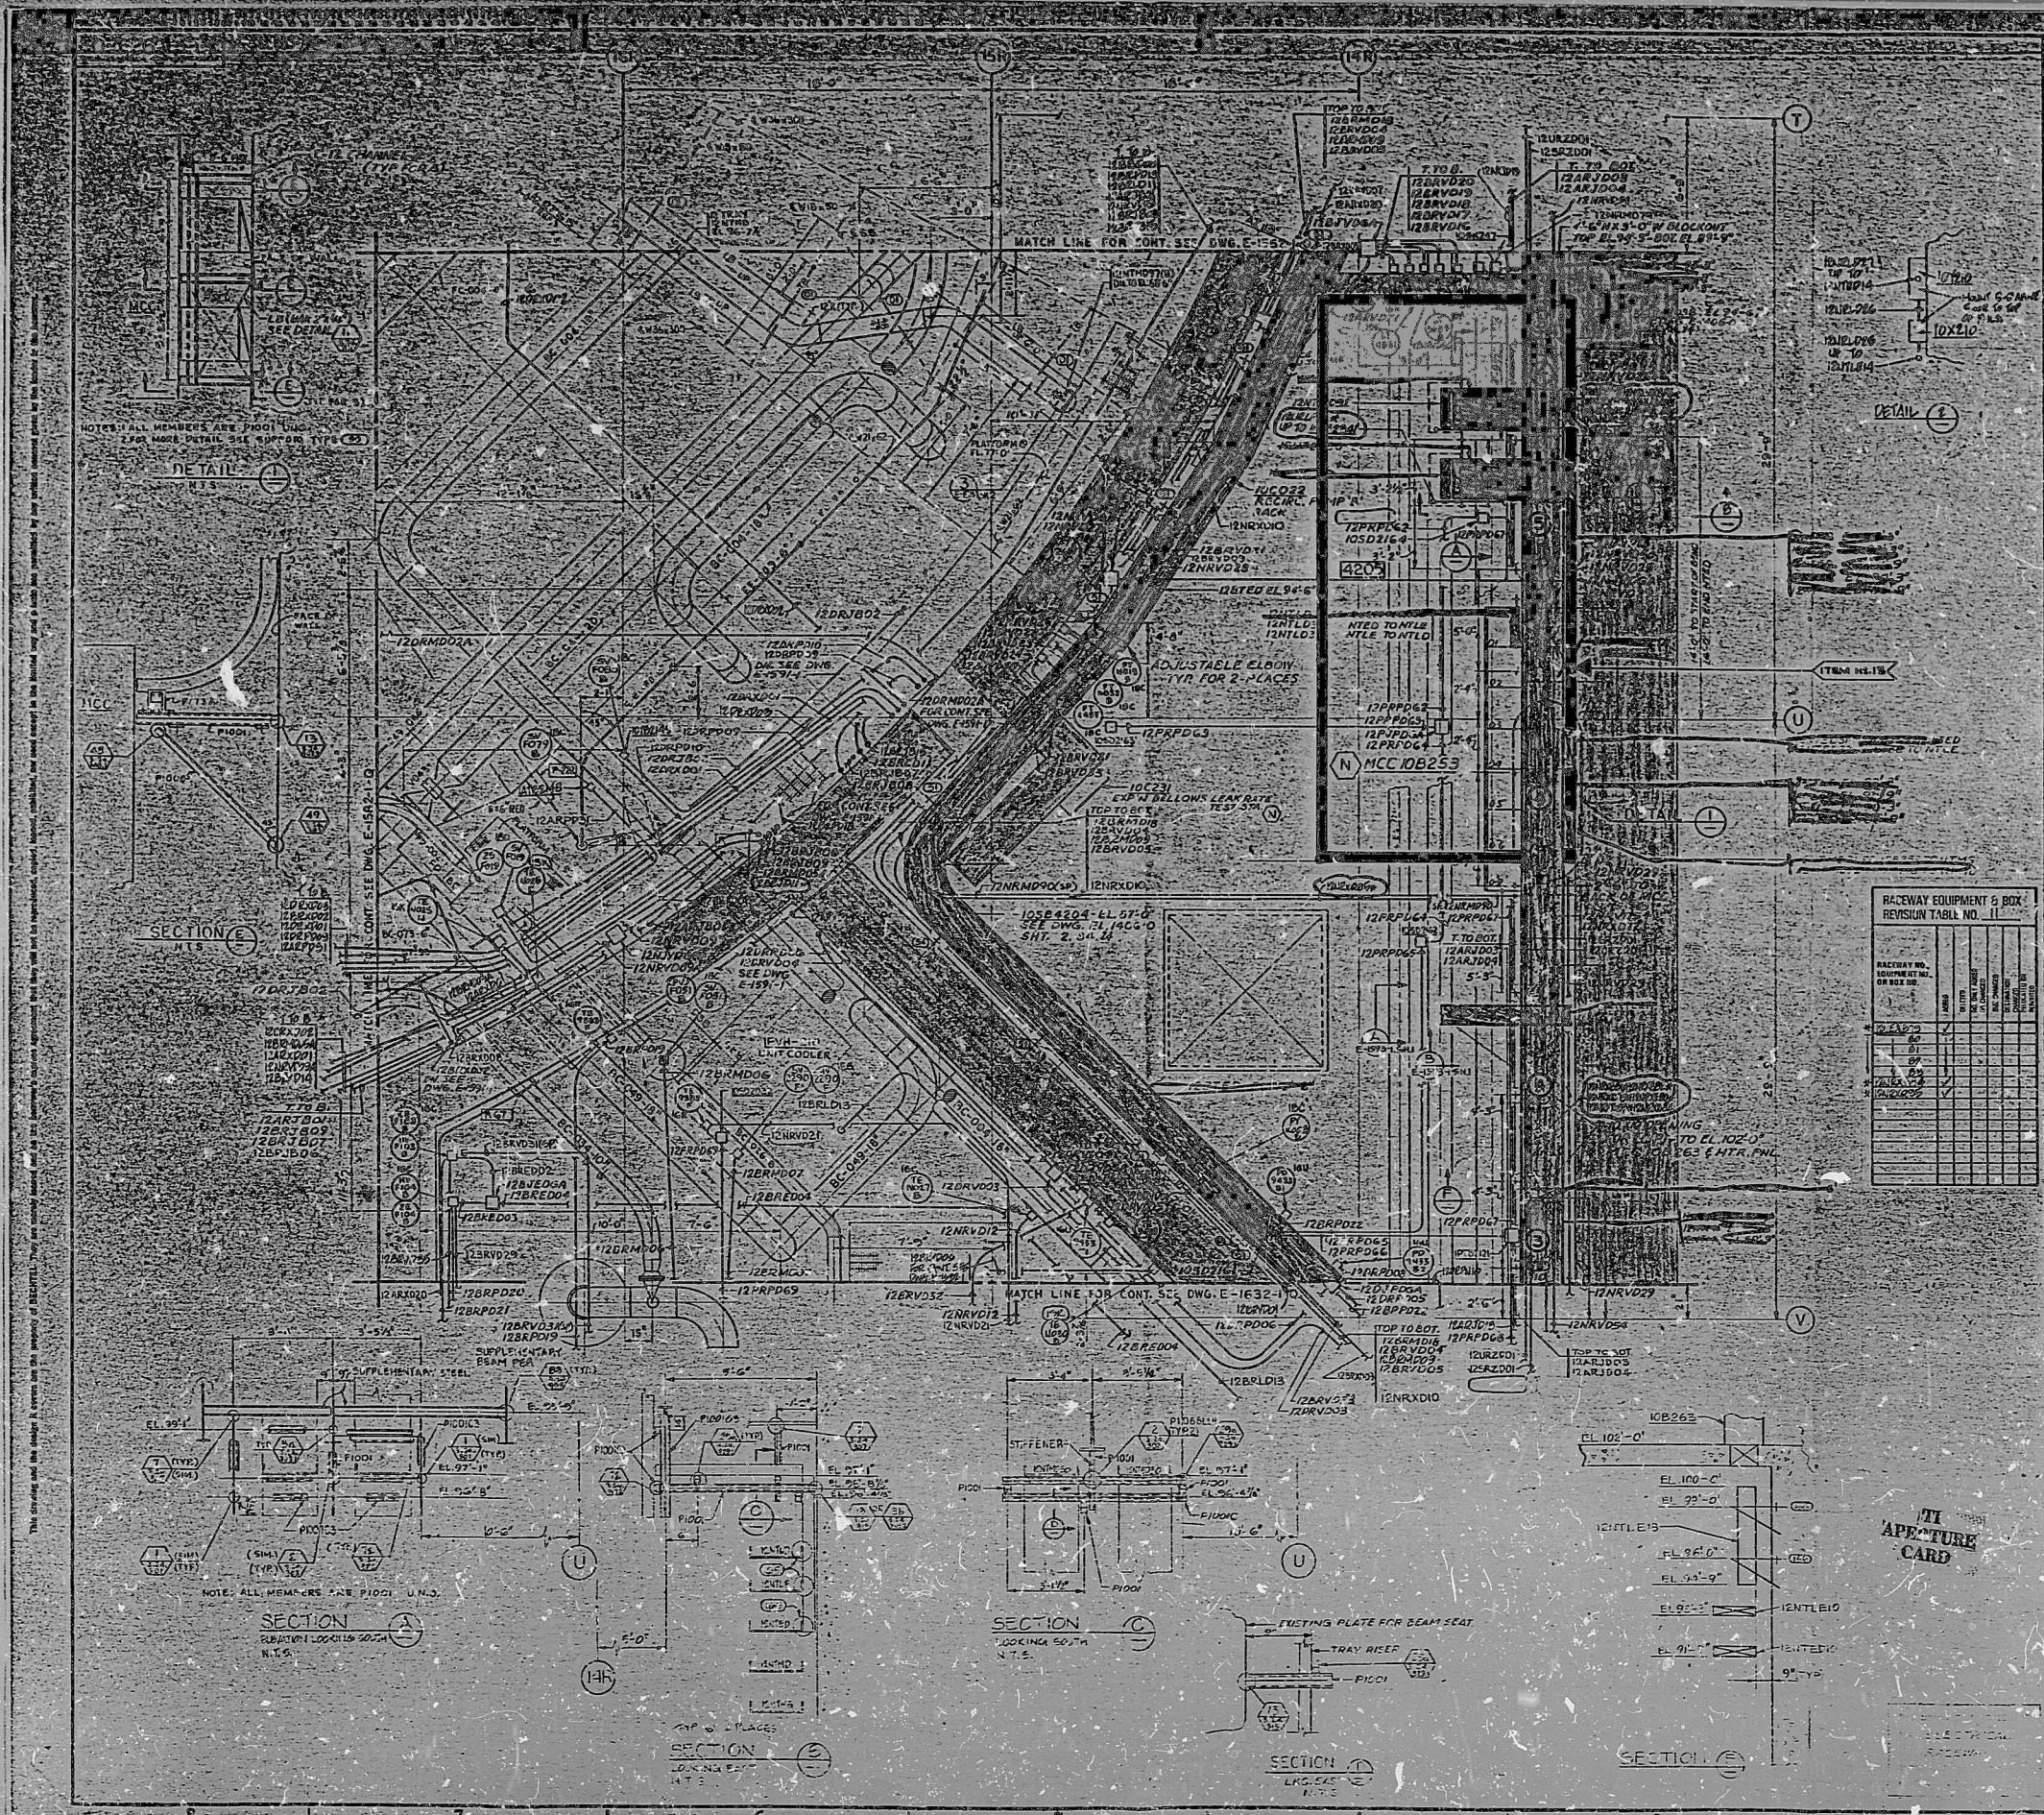

1	2	3	4	5	6	7	8	9	10	11	12	13	14	15	16	17	18	19	20	21	22
1	2	3	4	5	6	7	8	9	10	11	12	13	14	15	16	17	18	19	20	21	22

- NOTES:
1. ALL CABLE TRAYS ARE TO BE 24" UNLESS SHOWN OTHERWISE.
 2. CLASS 1E RACEWAY TRAY & CONDUIT ETC. ARE IDENTIFIED FOR LISTED INSTALLATION BY LETTERS A, B, C, D, W, X, Y OR Z. IN THE THIRD CHARACTER OF THE RACEWAY NUMBER.
 3. ALL FIRE DETECTORS ARE TO BE MOUNTED ON THE CEILING.
 4. FOR INSTALLATION DETAIL OF NONSTANDARD ELBOWS FOR CABLE TRAYS, SEE DWG. E-1405 O. 24, 3, 4, 5, 6.

- REFERENCE DRAWINGS
- P-1902 - PIPING
 - C-0507 - CIVIL-STRUCTURAL
 - P-9197 - HEATING & VENTILATING
 - P-8192 - PLUMBING
 - F-1406 - RACEWAY NOTES, SYMBOLS & DETAILS
 - C-0803 - FLOOR FRAME EL. 102'-0"
 - C-0535 - FLOOR ELEVATION 102'-0"
 - P-0042 - EQUIPMENT LOCATION
 - J-1902 - INSTRUMENT LOCATION

RACEWAY EQUIPMENT & BOX REVISION TABLE NO. 11

NO.	DESCRIPTION	DATE	BY	CHKD.
1	ISSUED FOR CONSTRUCTION	11/16/60
2	REVISION AS PER REV. TABLE
3	REVISION AS PER REV. TABLE
NO.	DESCRIPTION	DATE	BY	CHKD.
1	ISSUED FOR CONSTRUCTION	11/16/60
2	REVISION AS PER REV. TABLE
3	REVISION AS PER REV. TABLE
BECHTEL
SAN FRANCISCO

PUBLIC SERVICE ELECTRIC AND GAS COMPANY
HOPE CREEK GENERATING STATION

RACEWAY PLAN
REACTOR BUILDING AREA 19
PLAN EL. 77'-0"

10855	E-1592-1	1/6	Q
-------	----------	-----	---

8409040301

PDR RIDS

