
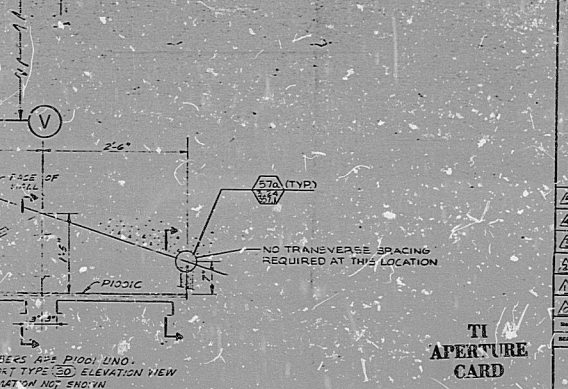
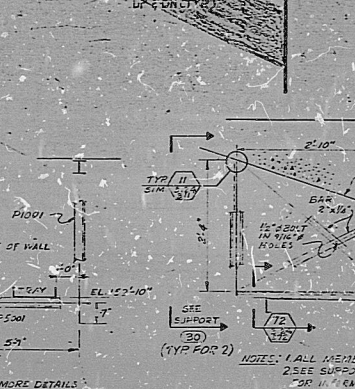
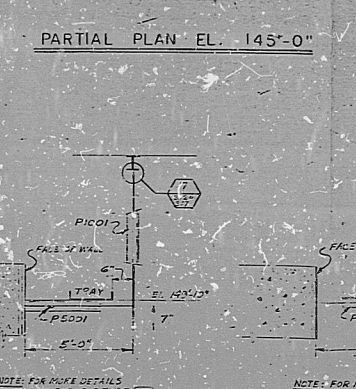
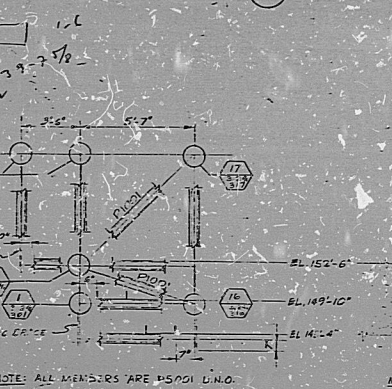
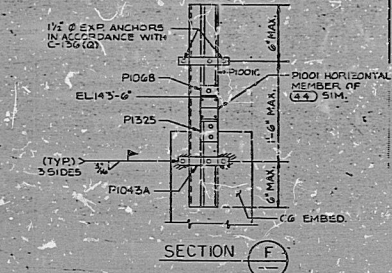
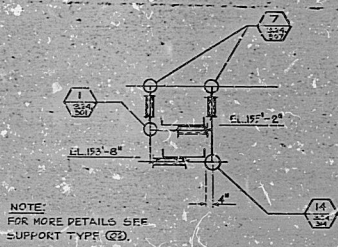
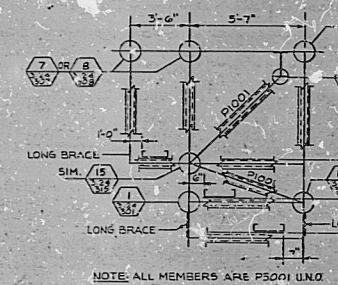


E-1575-1-0

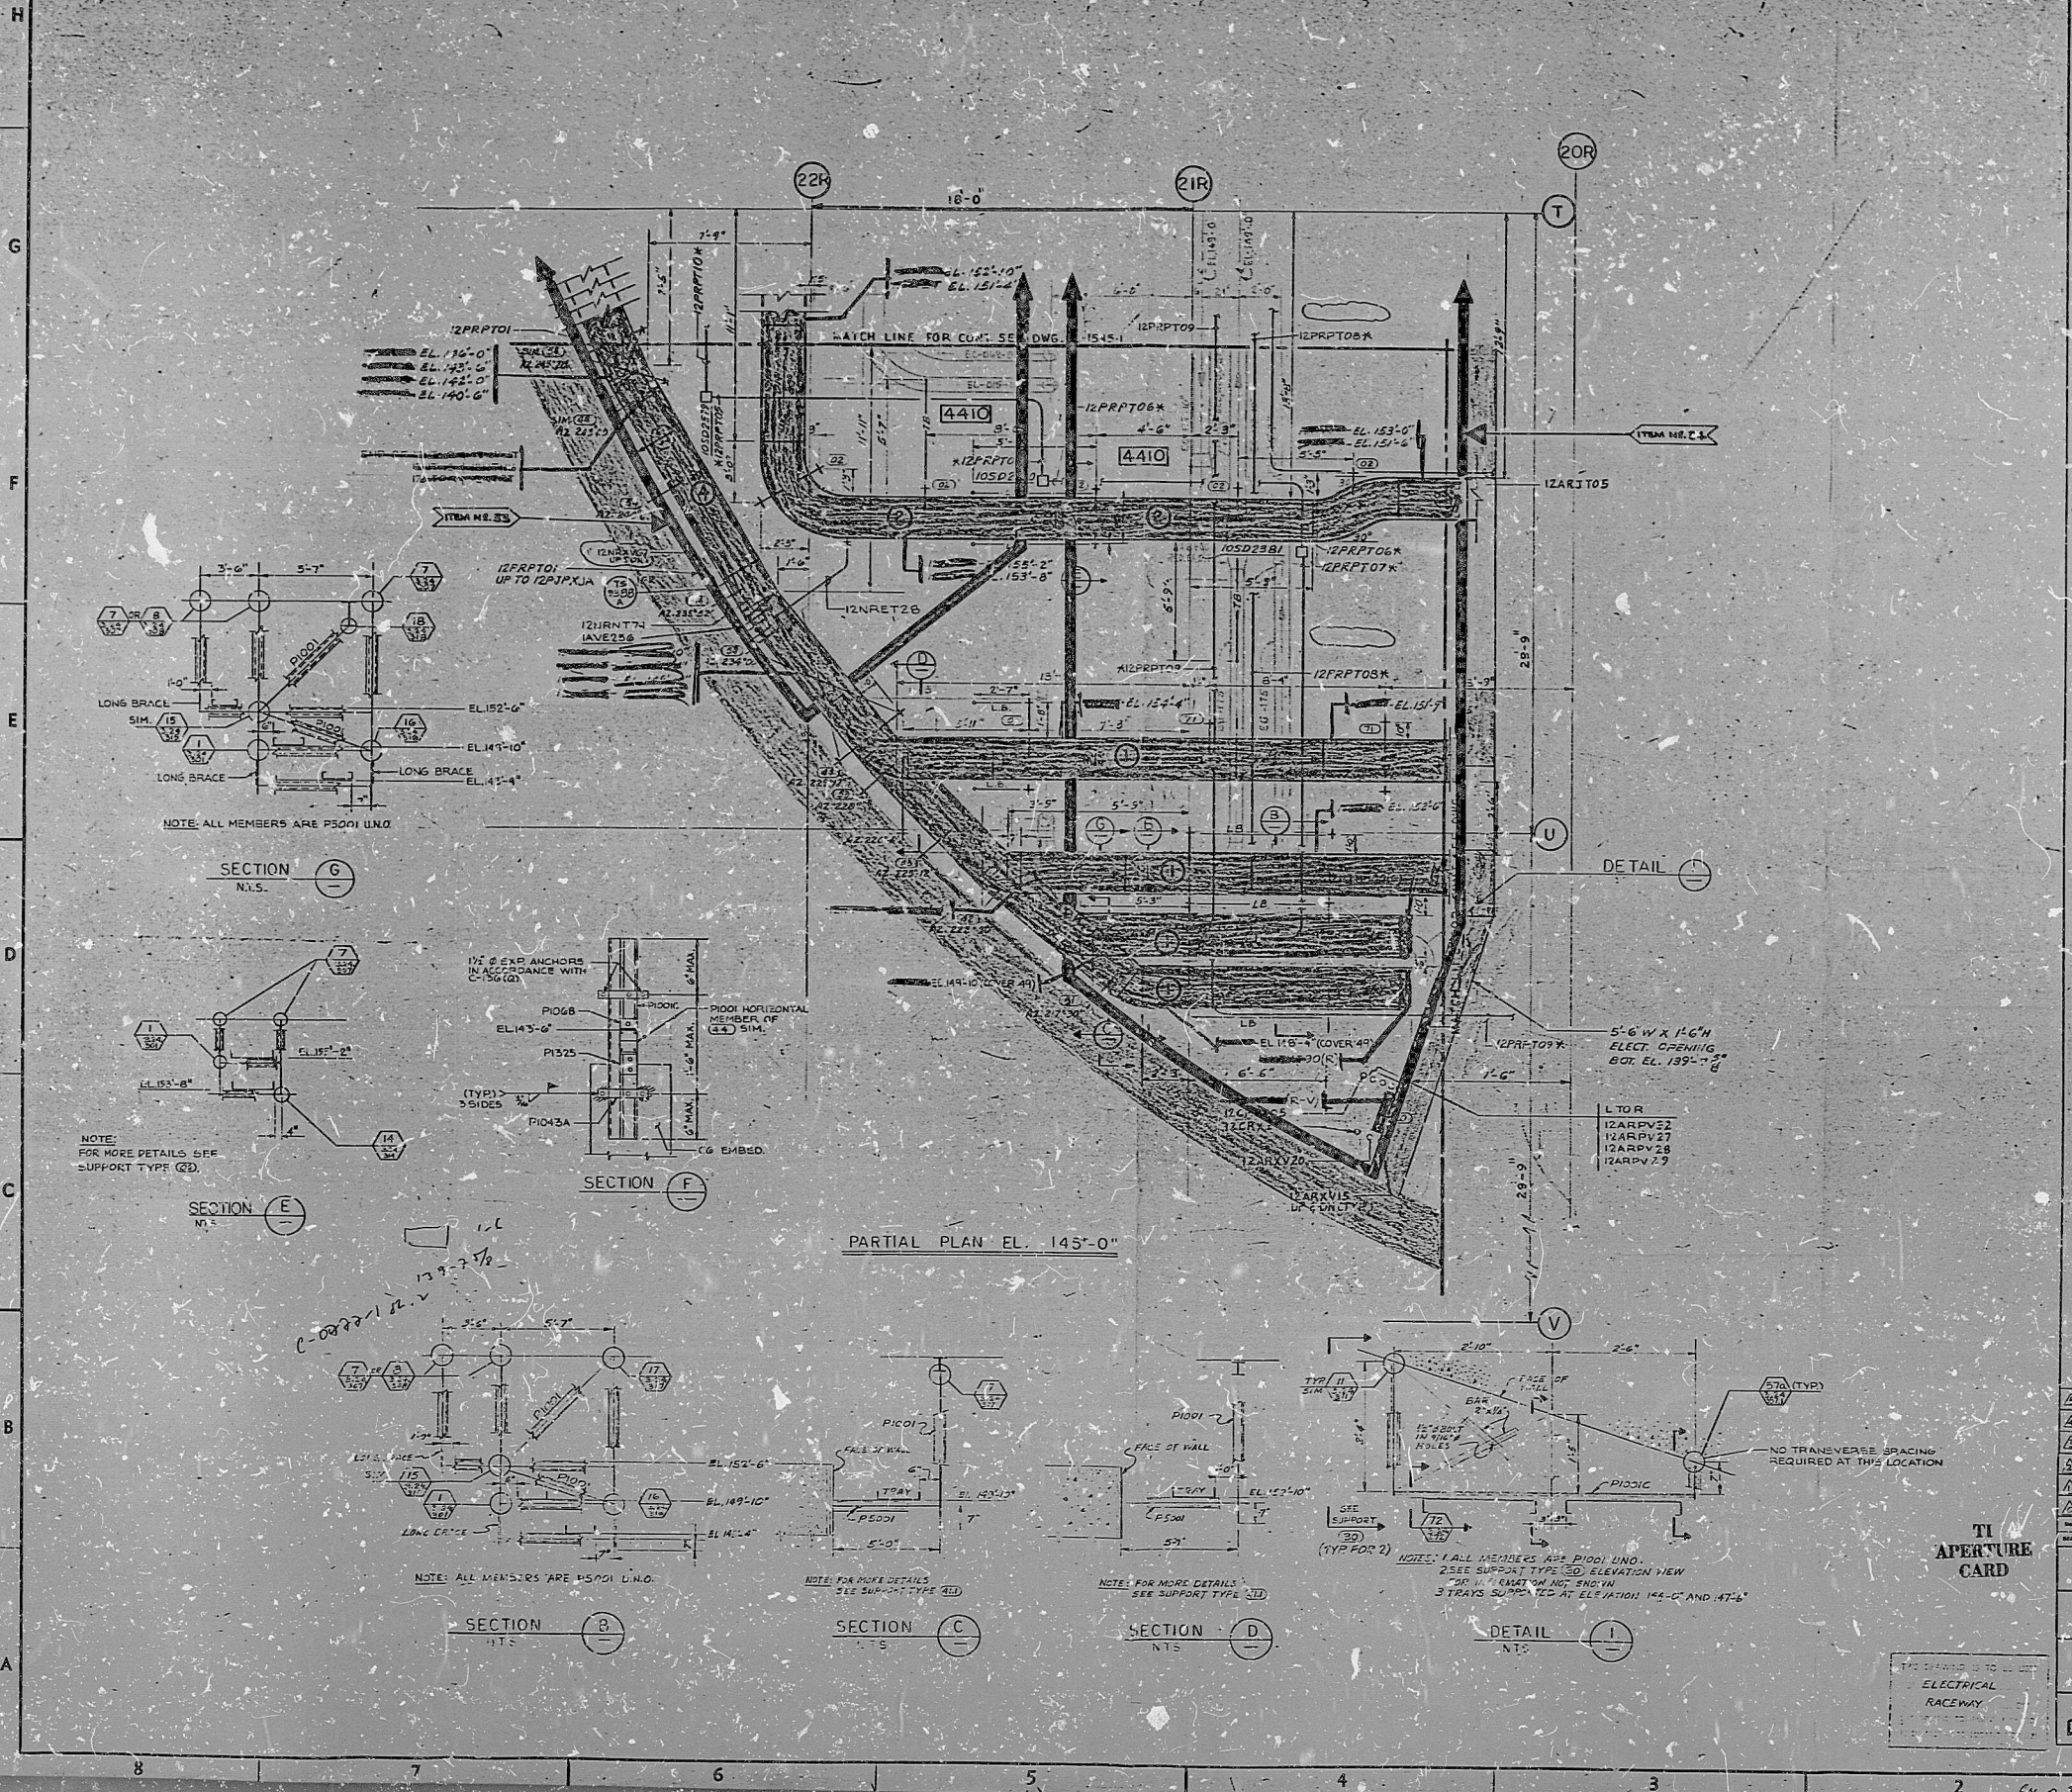


PLANT KEY PLAN

- NOTES:
- ALL CABLE TRAYS ARE 24" UNLESS SHOWN OTHERWISE.
 - FOR INSTALLATION DETAIL OF NON-STANDARD ELBOWS FOR CABLE TRAYS, SEE DWG. E-1406-O, SH. 3.24.388.
 - ALL FIRE DETECTORS ARE MOUNTED ON THE CEILING.

- REFERENCE DRAWINGS:
- P-2105-1 - PIPING.
 - C-0833-1 - CIVIL-STRUCTURAL.
 - P-8215-1 - HEATING & VENTILATING.
 - F-8215-1 - PLUMBING.
 - E-1406-O - RACEWAY NOTES, SYMBOLS & DETAILS.
 - C-0809-1 - STRUCTURAL STEEL FLOOR FRAMING PLAN.


BECHTEL
SAN FRANCISCO

PUBLIC SERVICE ELECTRIC AND GAS COMPANY
HOPE CREEK GENERATING STATION

RACEWAY PLAN
REACTOR BUILDING-AREA 21
PLAN EL 145'-0"

JOB NO. 13855 DRAWING NO. E-1575-1-5

TI
APERTURE
CARD

22"
17"
11"
8.5"
11"
17"
22"

22"
17"
11"
8.5"
11"
17"
22"

5-A-1115 17.25.54

PDR RIDS

8409048366

